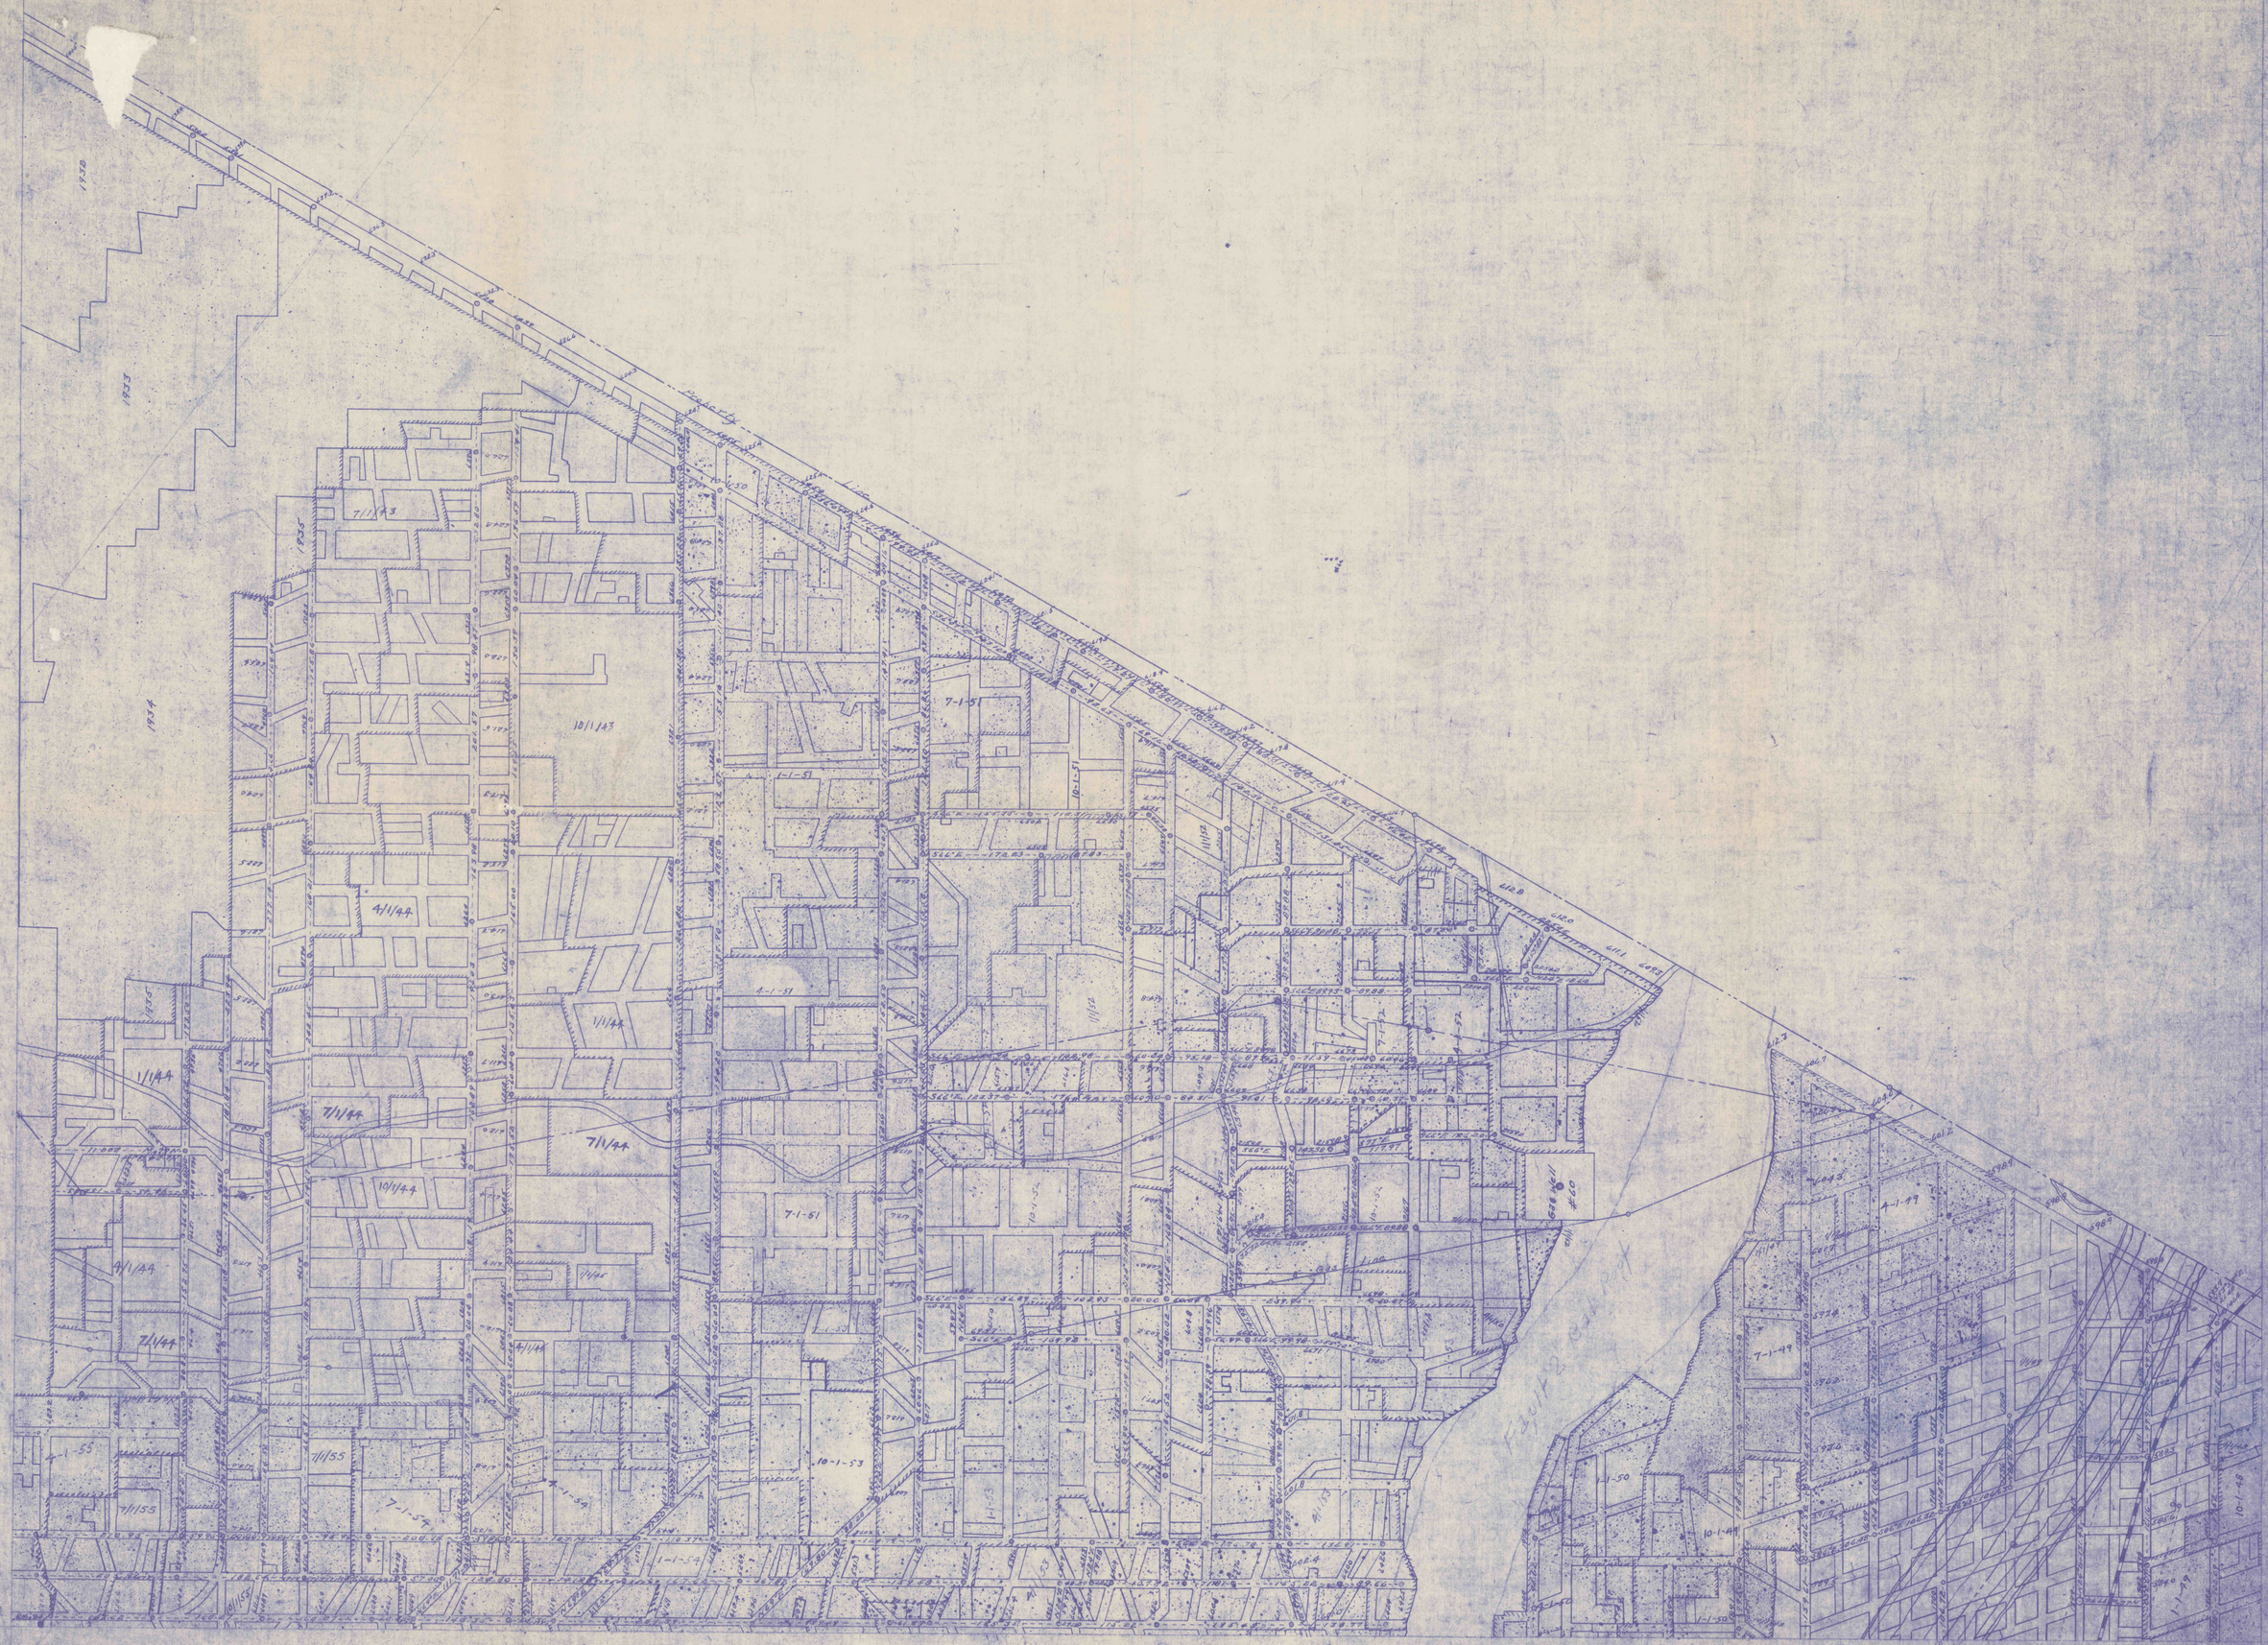
Property Line
1938
1937
1936
1935
1934
7/1/43
10/1/43
4/1/44
1/1/44
7/1/44
10/1/44
4/1/44
7/1/44
7/1/55
7-1-51
4-1-51
10-1-53
7-1-54
1-1-54
4-1-55
7-1-55
1-1-53
11/52
11/53
11/55
7-1-99
4-1-99
1-1-50
10-1-49
1-1-49
Figure 2 of X