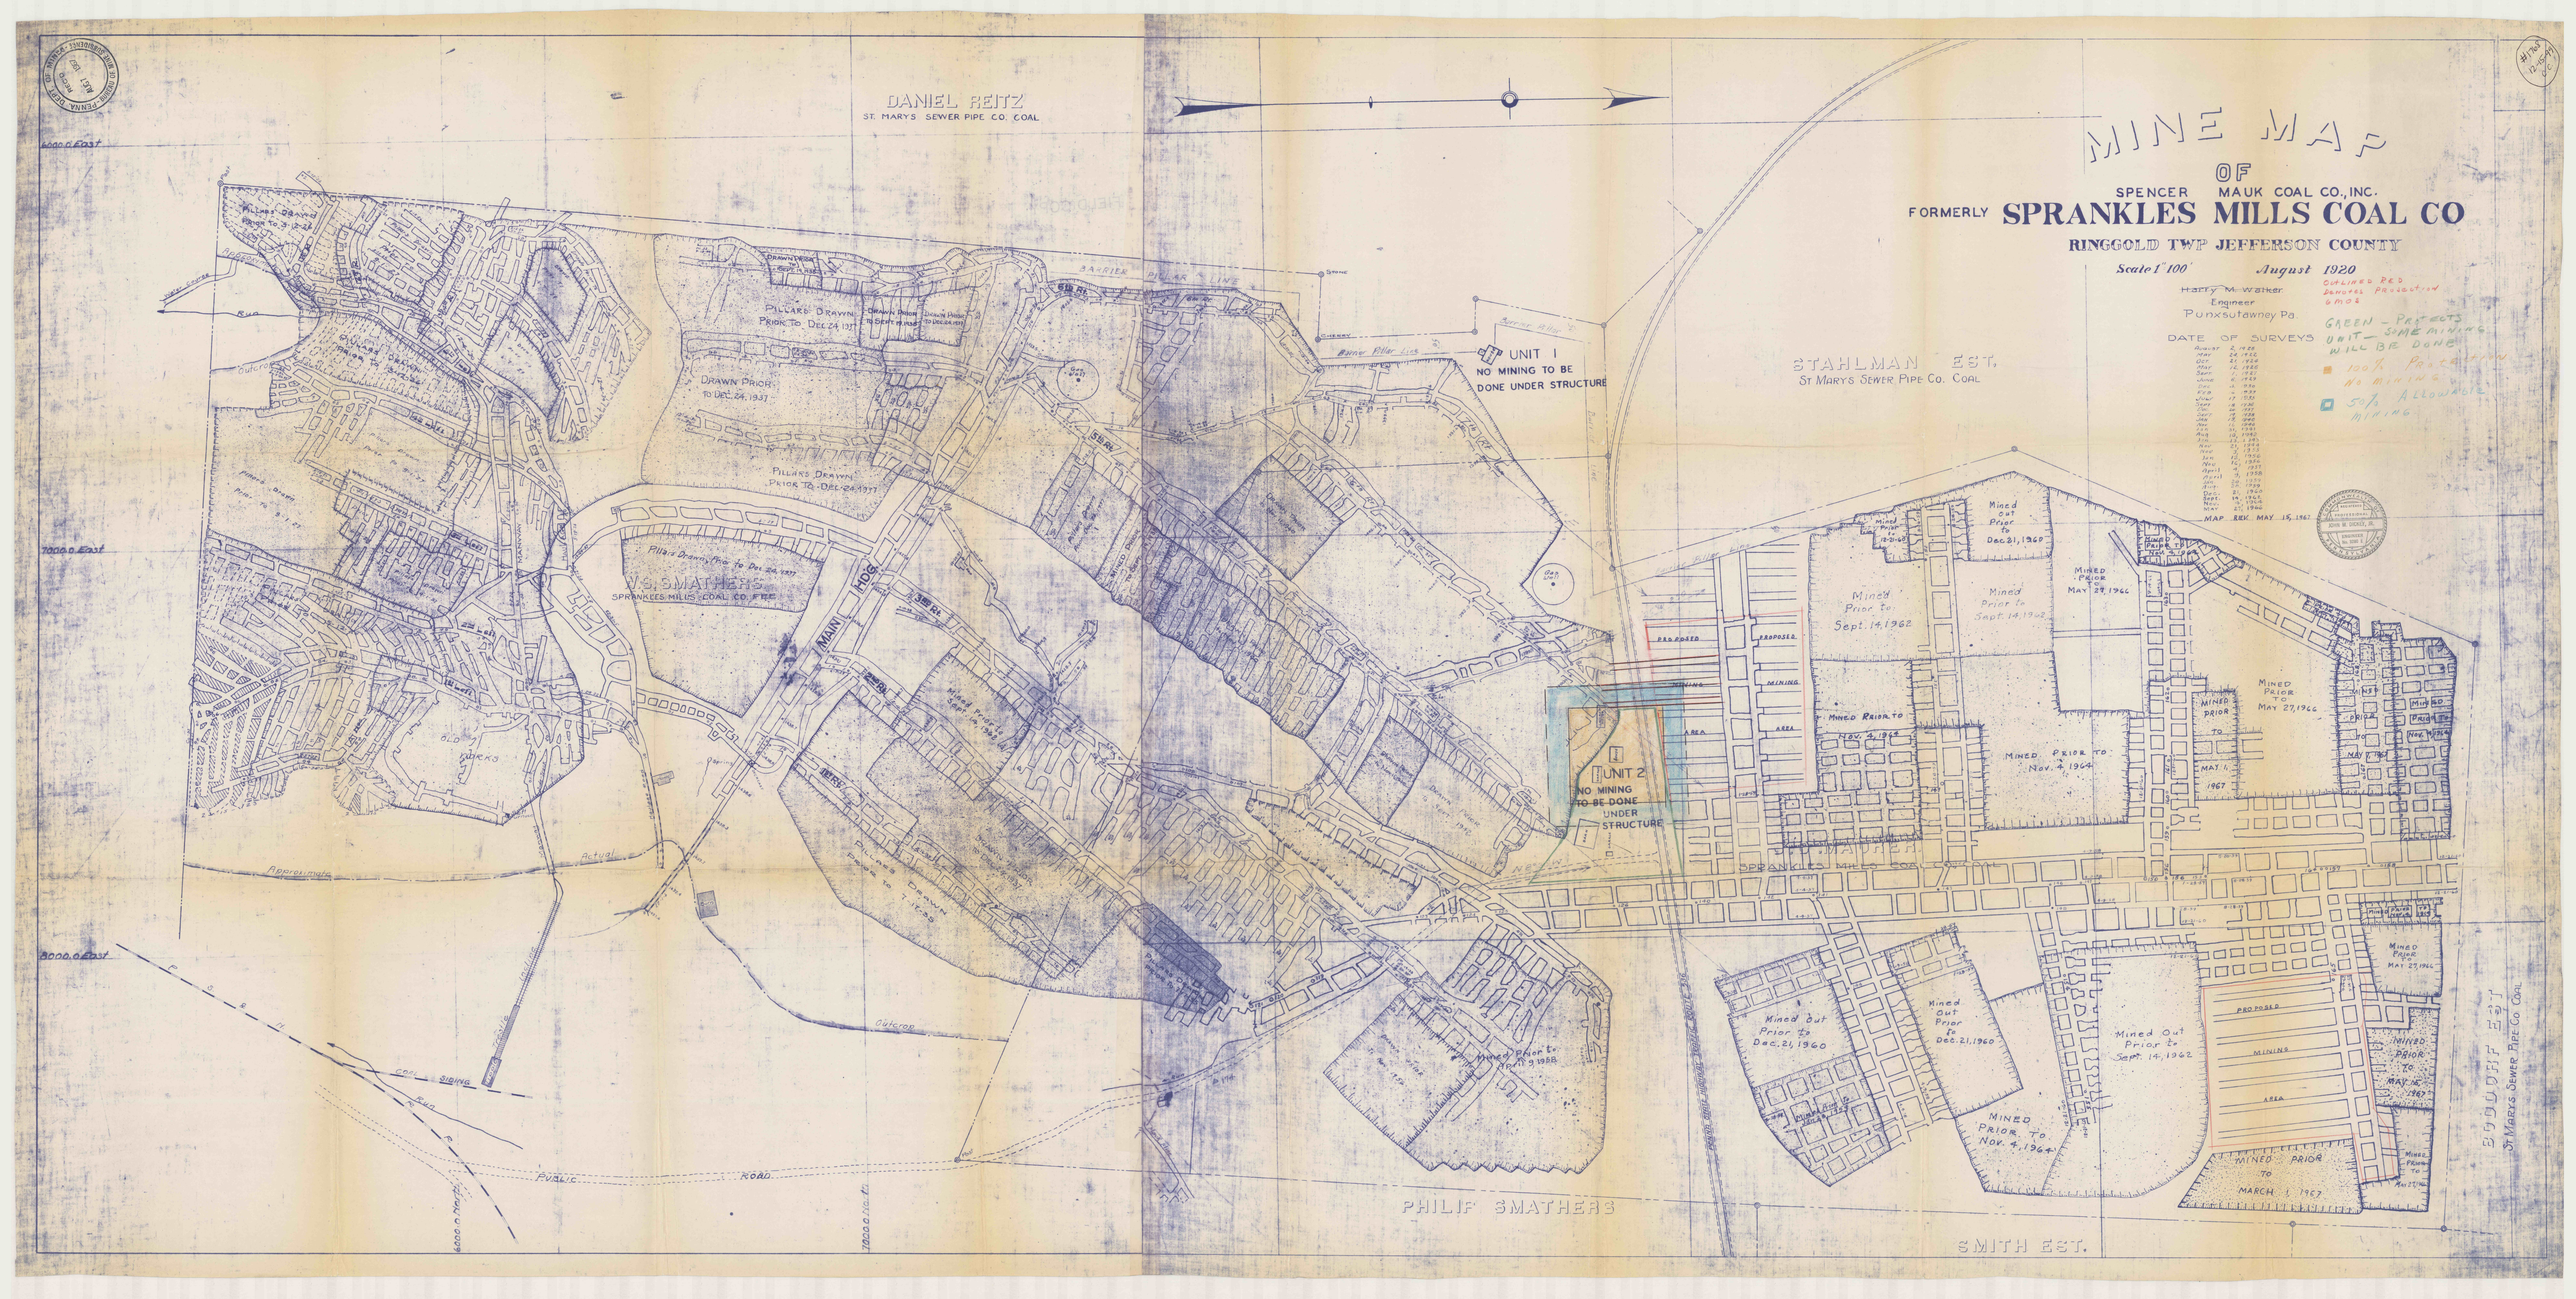
MINE MAP
OF
SPENCER MAUK COAL CO., INC.
FORMERLY SPRANKLES MILLS COAL CO
RINGGOLD TWP JEFFERSON COUNTY
Scale 1" 100'
August 1920
Harry M. Walker
Engineer
Punxsutawney Pa.
DATE OF SURVEYS
August 2, 1928
May 24, 1926
Oct. 21, 1924
Mar. 12, 1926
Sept. 1, 1927
June 6, 1929
Dec. 4, 1930
Feb. 4, 1932
Jan. 17, 1933
Sept. 18, 1936
Oct. 14, 1937
Sept. 19, 1938
Jan. 18, 1940
Nov. 16, 1940
Feb. 21, 1941
Aug. 18, 1942
Jan. 13, 1943
Nov. 21, 1944
Dec. 3, 1945
Nov. 12, 1946
Nov. 16, 1946
April 4, 1947
April 9, 1948
Jan. 20, 1949
Dec. 21, 1950
Sept. 14, 1951
Nov. 5, 1956
May 27, 1966
MAP REV. MAY 15, 1967
OUTLINED RED DENOTES PROJECTION 6MOS
GREEN - PROTECTS UNIT - SOME MINING WILL BE DONE
100% PROTECTION NO MINING
50% ALLOWABLE MINING
DANIEL REITZ
ST. MARYS SEWER PIPE CO. COAL
STAHLMAN EST.
ST MARYS SEWER PIPE CO. COAL
UNIT 1
NO MINING TO BE DONE UNDER STRUCTURE
UNIT 2
NO MINING TO BE DONE UNDER STRUCTURE
W. S. SMATHERS
SPRANKLES MILLS COAL CO. FEE
PILLARS DRAWN PRIOR TO DEC. 24, 1937
DRAWN PRIOR TO DEC. 24, 1937
MAIN HDG.
BARRIER PILLAR LINE
Mined Prior to Sept. 14, 1962
Mined Prior to Sept. 14, 1962
Mined Out Prior to Dec. 21, 1960
Mined Prior to May 27, 1966
Mined Prior to Nov. 4, 1964
Mined Prior to Nov. 4, 1964
Mined Prior to May 27, 1966
Mined Prior to May 1, 1967
Mined Out Prior to Dec. 21, 1960
Mined Out Prior to Dec. 21, 1960
Mined Out Prior to Sept. 14, 1962
Mined Prior to Nov. 4, 1964
Mined Prior to March 1, 1967
Mined Prior to May 27, 1966
Mined Prior to May 15, 1967
PROPOSED MINING AREA
SPRANKLES MILLS COAL CO. COAL
PHILIP SMATHERS
SMITH EST.
BOOCHOFF EST.
ST MARYS SEWER PIPE CO. COAL
6000.0 East
7000.0 East
8000.0 East
Approximate
Actual
Outcrop
PUBLIC ROAD
COAL SIDING
6000.0 North
7000.0 North