


#1774
12-15-66
EC


PLOT SHOWING
DEEP MINE
OF
MICHAEL & LEO MAXIM

WASHINGTON TWP. JEFF. CO.
SCALE: 1" = 100' 21 NOV. 1966

FIELD COPY
E. STERRETT

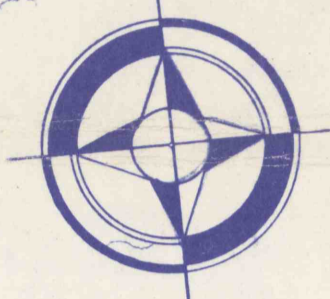

M I C H A E L J . R O S I O

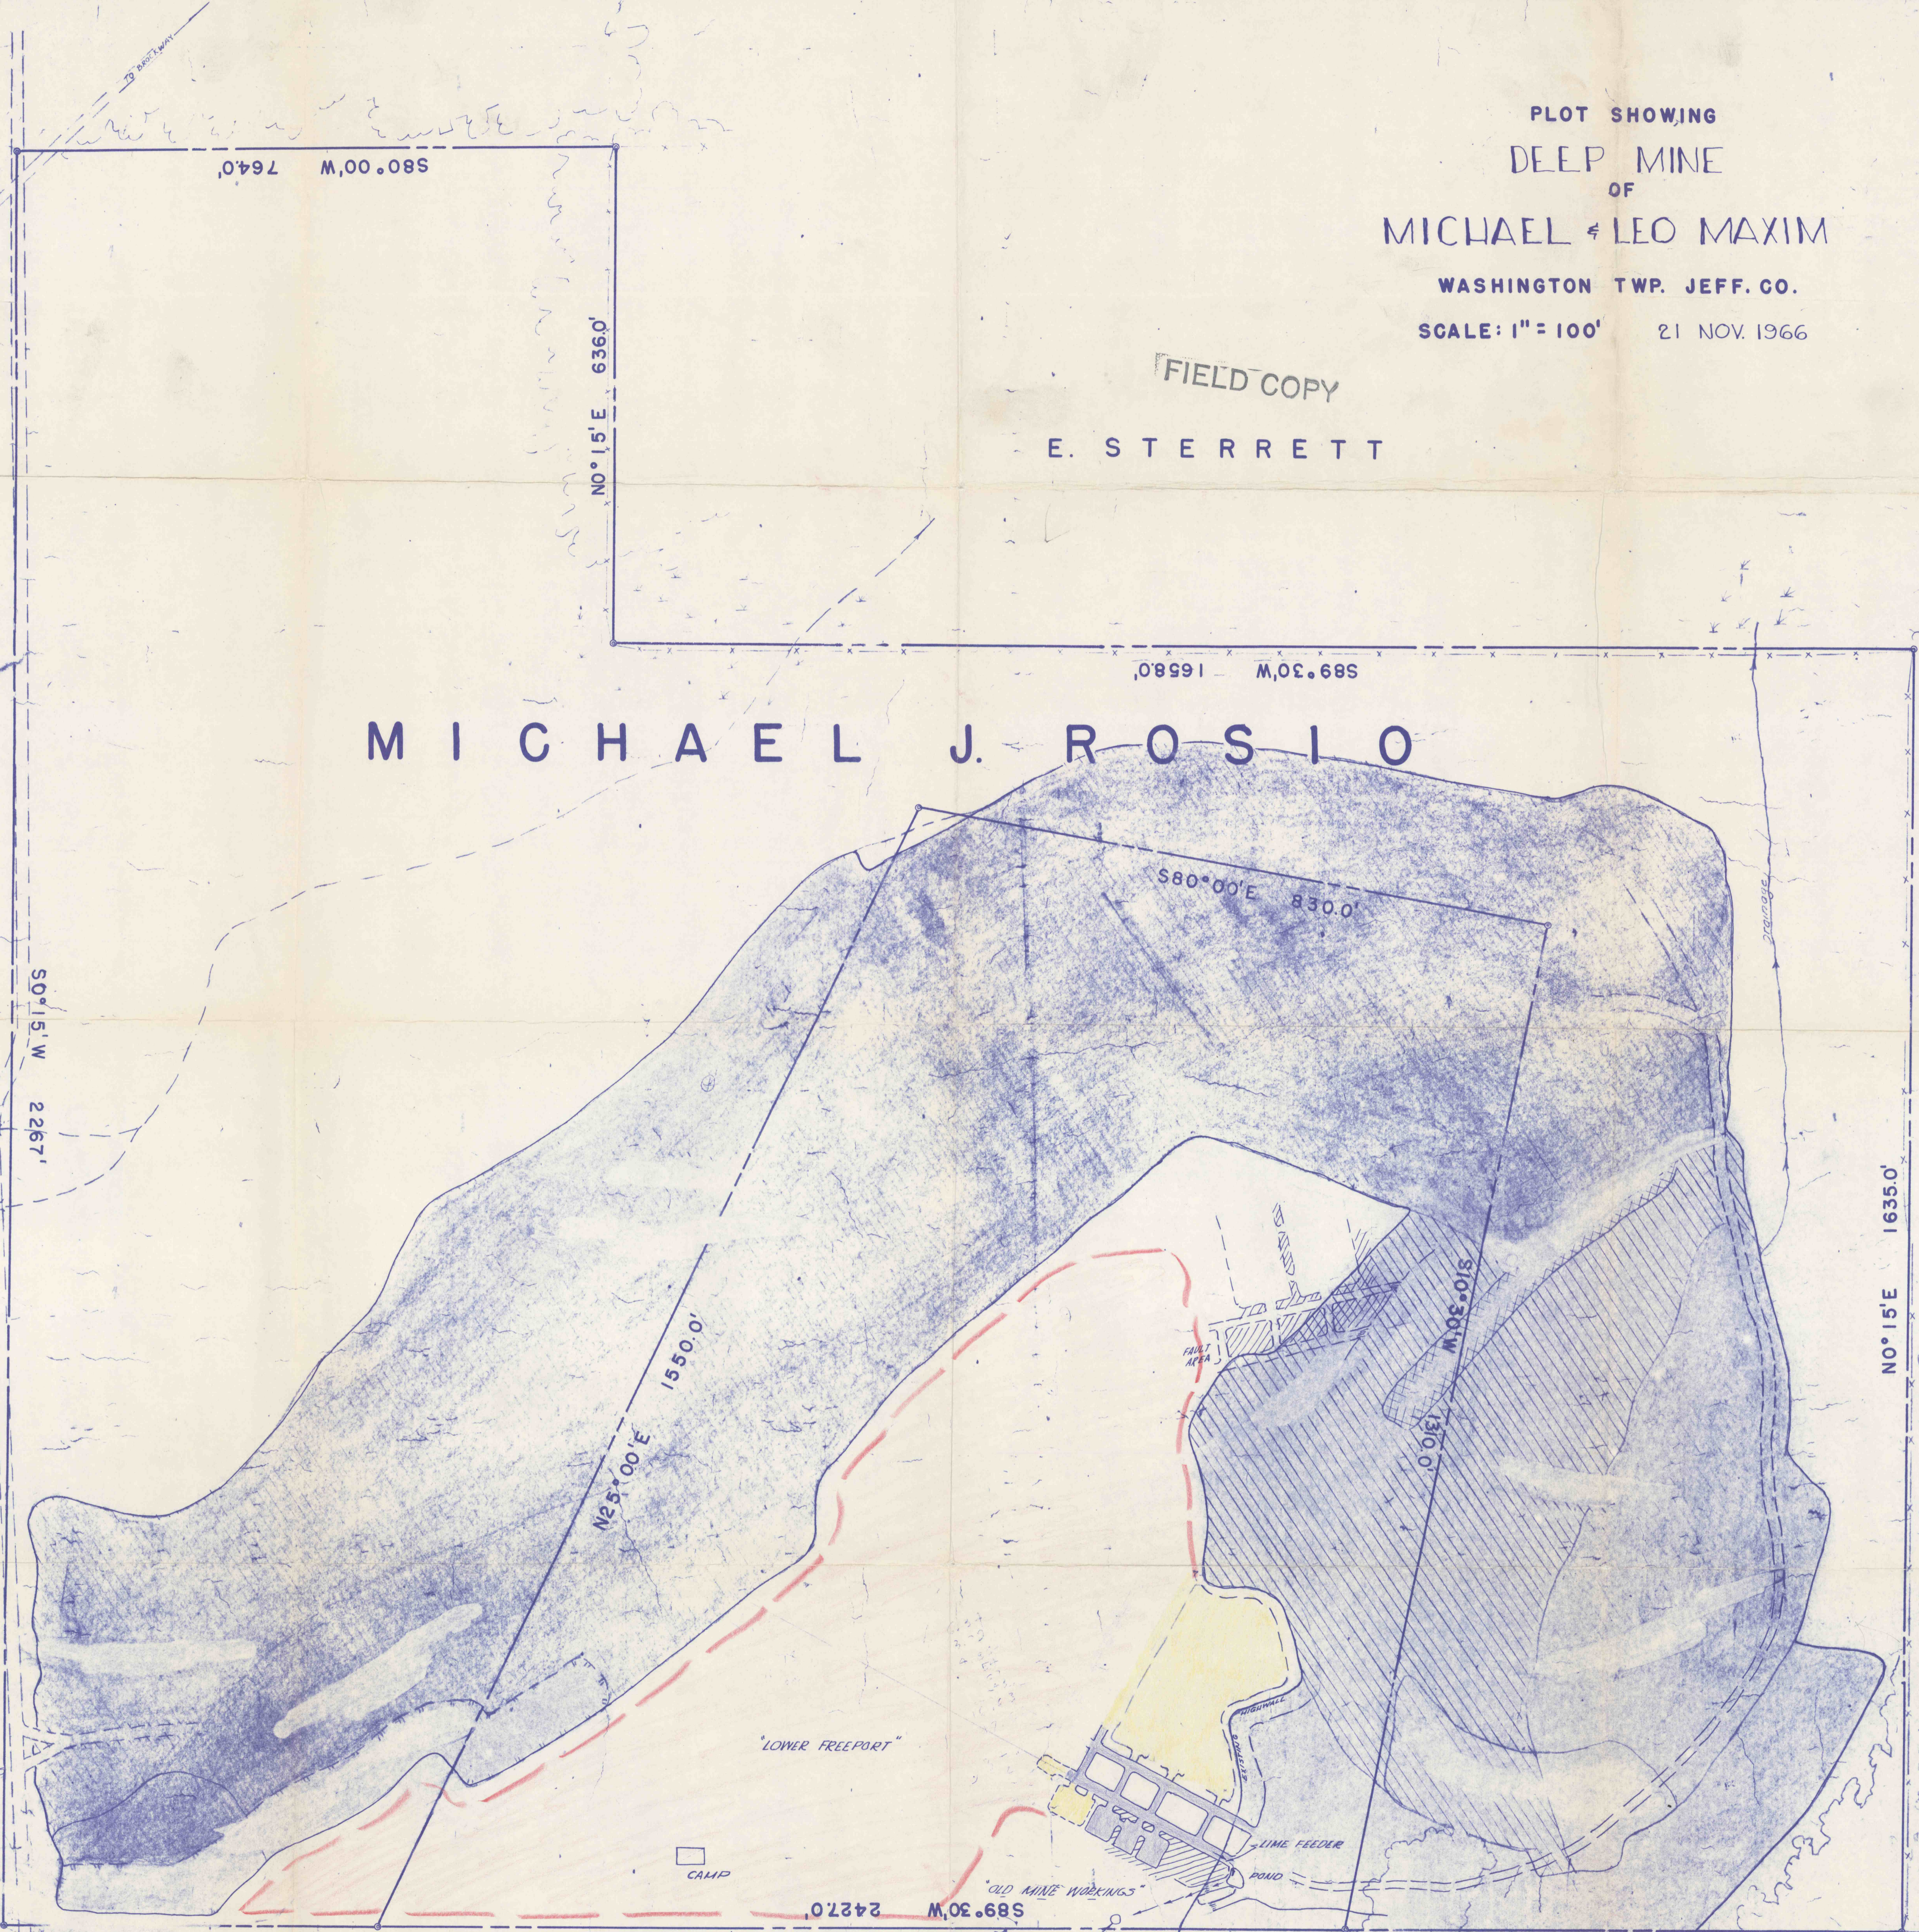

MCCURDY

E. STERRETT

W I L L I A M & T H O M A S K E Y S

- LEGEND
- AREA MINED TO DATE
 - EXTENT OF AREA TO BE MINED
 - AREA TO BE MINED NEXT 6 MONTHS PERIOD
 - OLD STEEP MINE

