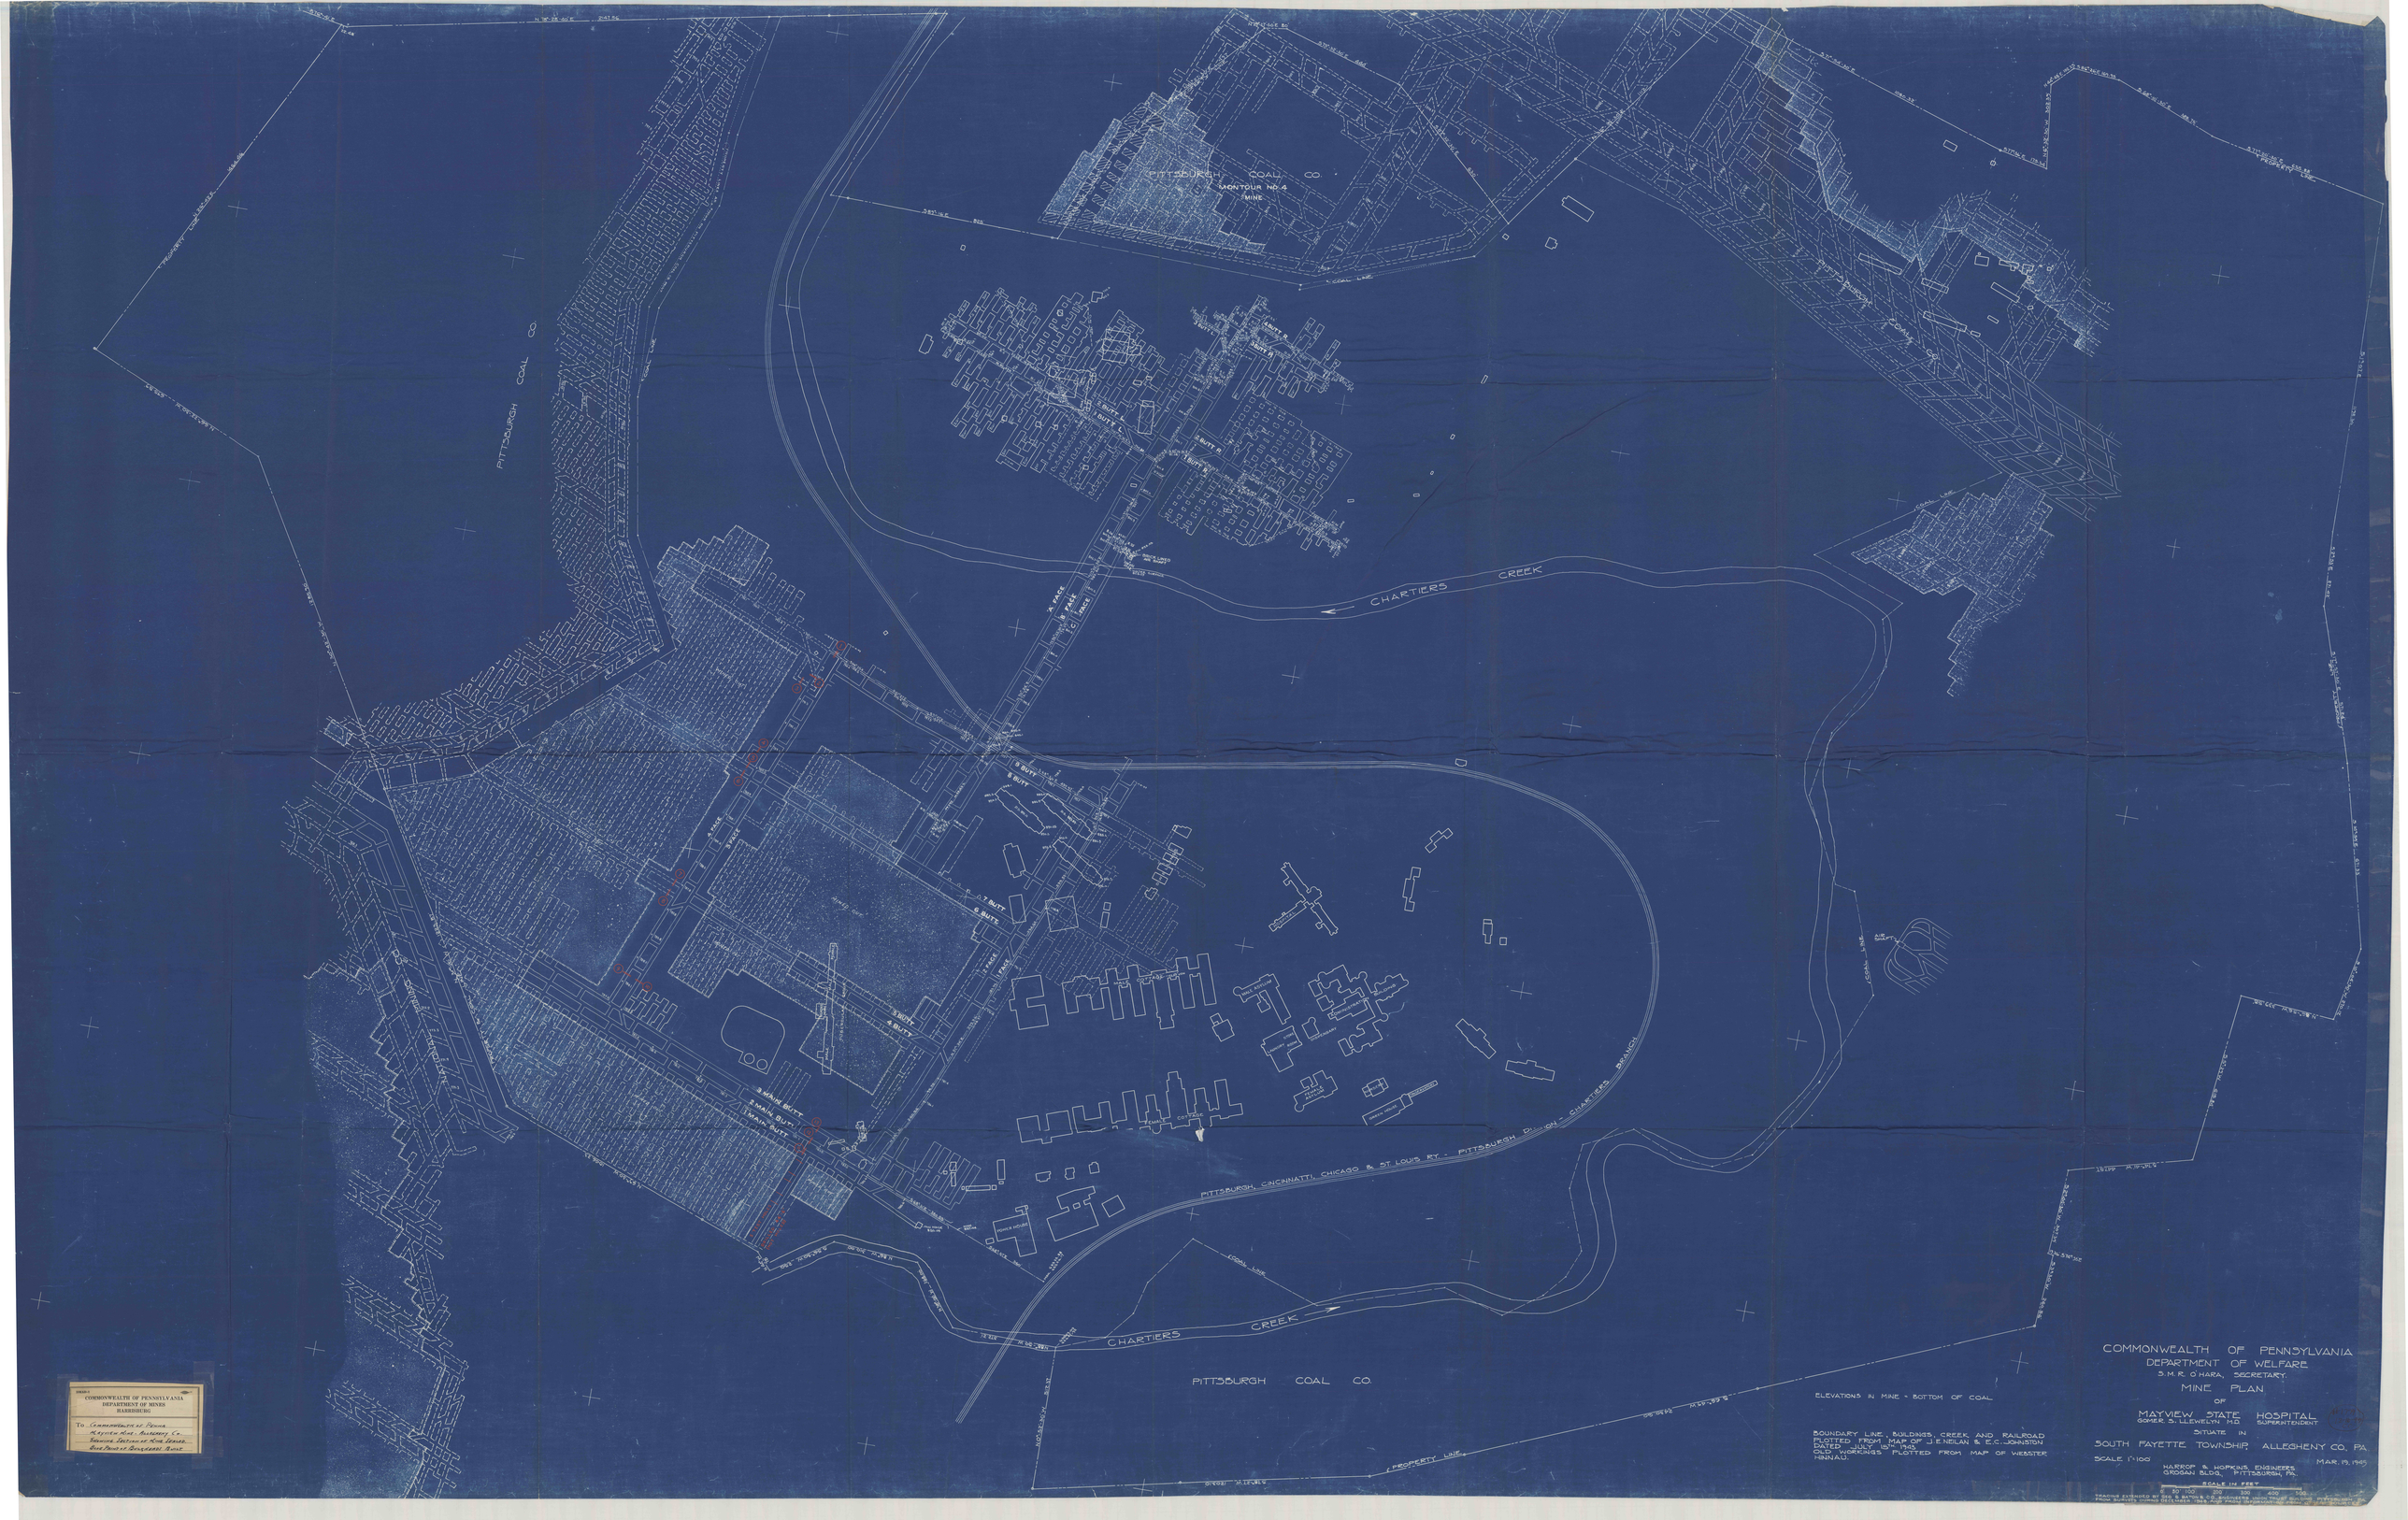
PITTSBURGH COAL CO.
MONTOUR No. 4
MINE
PITTSBURGH COAL CO.
CHARTIERS CREEK
PITTSBURGH, CINCINNATI, CHICAGO & ST. LOUIS RY. - PITTSBURGH DIVISION - CHARTIERS BRANCH
PITTSBURGH COAL CO.
ELEVATIONS IN MINE = BOTTOM OF COAL
BOUNDARY LINE, BUILDINGS, CREEK AND RAILROAD PLOTTED FROM MAP OF J.E. NOLAN & E.C. JOHNSTON DATED JULY 15TH 1943
OLD WORKINGS PLOTTED FROM MAP OF WEBSTER HINNAD.
COMMONWEALTH OF PENNSYLVANIA
DEPARTMENT OF WELFARE
S.M.R. O'HARA, SECRETARY.
MINE PLAN
OF
MAYVIEW STATE HOSPITAL
GOMER S. LLEWELYN M.D. SUPERINTENDENT
SITUATE IN
SOUTH FAYETTE TOWNSHIP, ALLEGHENY CO. PA.
SCALE 1"=100
MAR. 19, 1945
HARROP & HOPKINS, ENGINEERS
GROGAN BLDG., PITTSBURGH, PA.
SCALE IN FEET
0 50 100 200 300 400 500
TRACING EXTENDED BY GEO. S. BATON & CO. ENGINEERS UNION TRUST BUILDING PITTSBURGH, PA.
FROM SURVEY DURING OCTOBER 1945 AND PRIOR TO ABANDONMENT
COMMONWEALTH OF PENNSYLVANIA
DEPARTMENT OF MINES
HARRISBURG
To Commonwealth of Penna.
Mayview State Hospital Co.
Township Section of Sur. Grade.
Bus Project Boulevard Road.