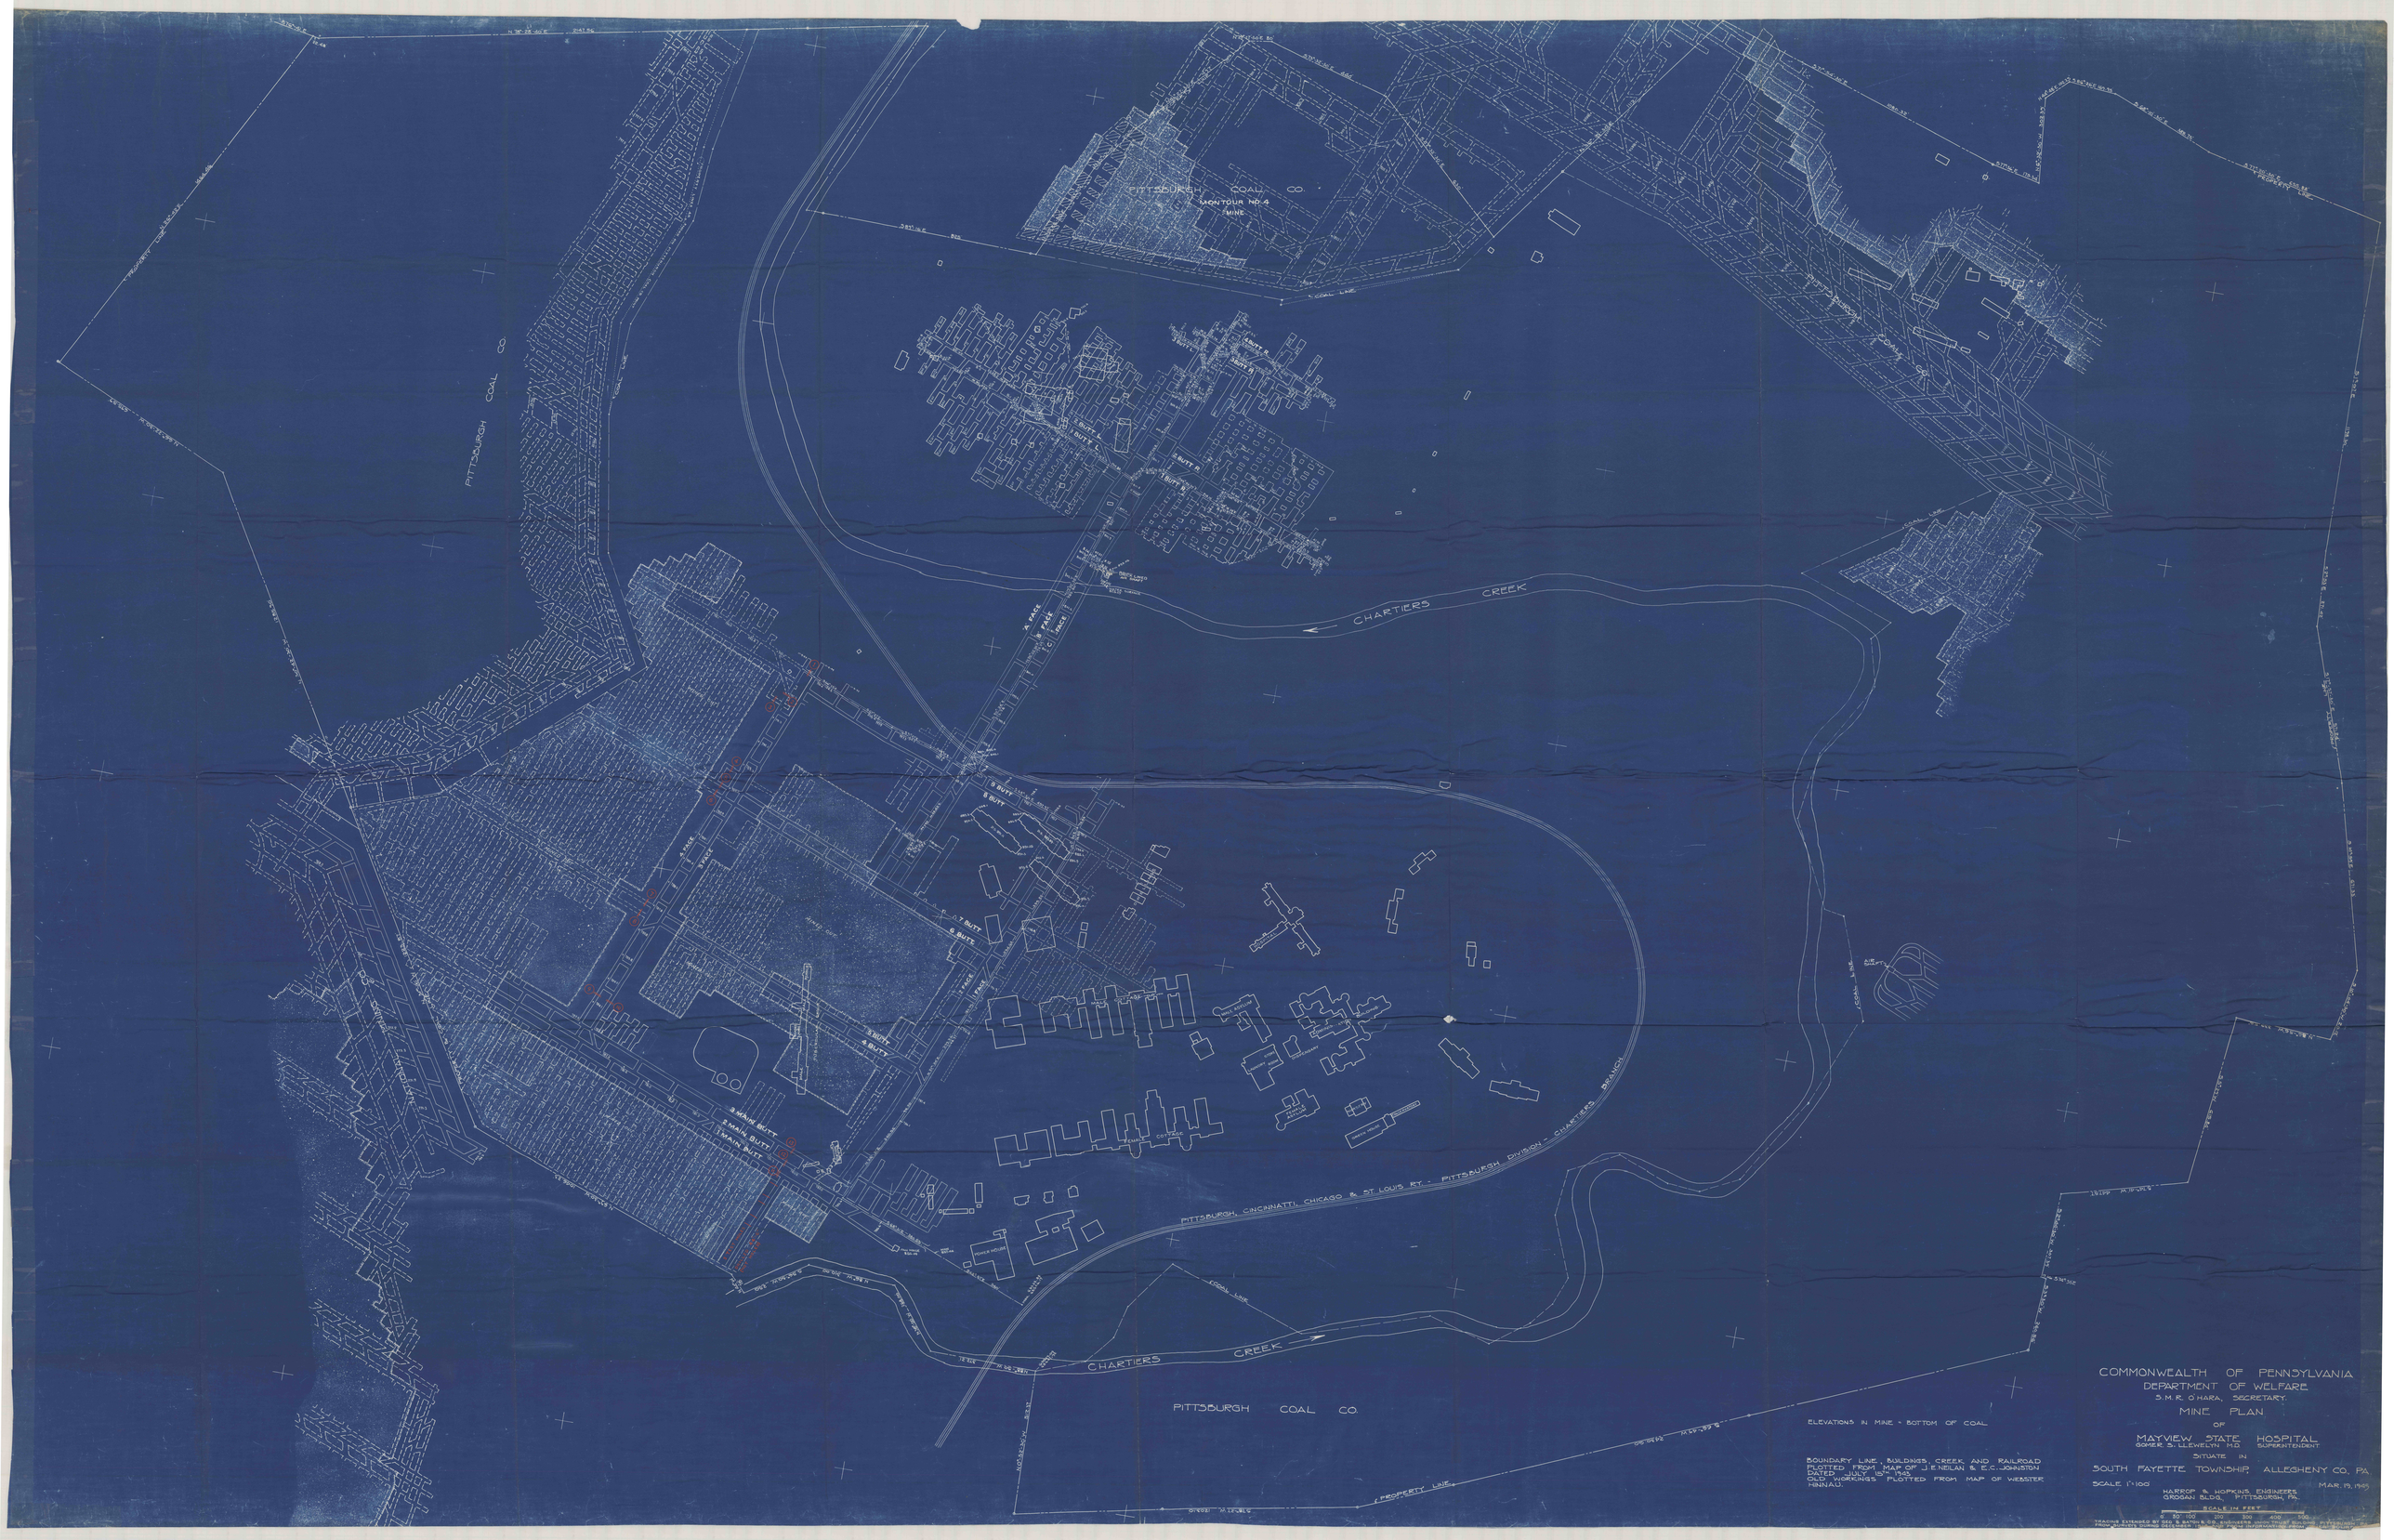
PITTSBURGH COAL CO.
MONTOUR NO. 4
MINE
PITTSBURGH COAL CO.
PITTSBURGH COAL CO.
CHARTIERS CREEK
CHARTIERS CREEK
PITTSBURGH, CINCINNATI, CHICAGO & ST LOUIS RY. - PITTSBURGH DIVISION - CHARTIERS BRANCH
PITTSBURGH COAL CO.
PROPERTY LINE
COAL LINE
AIR SHAFT
COMMONWEALTH OF PENNSYLVANIA
DEPARTMENT OF WELFARE
S. M. R. O'HARA, SECRETARY.
MINE PLAN
OF
MAYVIEW STATE HOSPITAL
GORGE S. LLEWELYN M.D. SUPERINTENDENT.
SITUATE IN
SOUTH FAYETTE TOWNSHIP, ALLEGHENY CO. PA.
SCALE 1"=100
MAR. 19, 1945
HARROP & HOPKINS, ENGINEERS
GROGAN BLDG. PITTSBURGH, PA.
SCALE IN FEET
0 50 100 200 300 400 500
TRACINGS EXTENDED BY DES & BATES R.E. INDUSTRIES
FROM PRIVATE SURVEY DATED
ELEVATIONS IN MINE - BOTTOM OF COAL.
BOUNDARY LINE, BUILDINGS, CREEK, AND RAILROAD PLOTTED FROM MAP OF J. E. NEILAN & E.C. JOHNSTON DATED JULY 15TH 1941.
OLD WORKINGS PLOTTED FROM MAP OF WEBSTER HINAU.