


DATE OF SURVEY.
MAY 30, 1918 = B.
NOV. 30, 1918 = C.
DEC. 31, 1918 = D.
DEC. 11, 1920 = E.

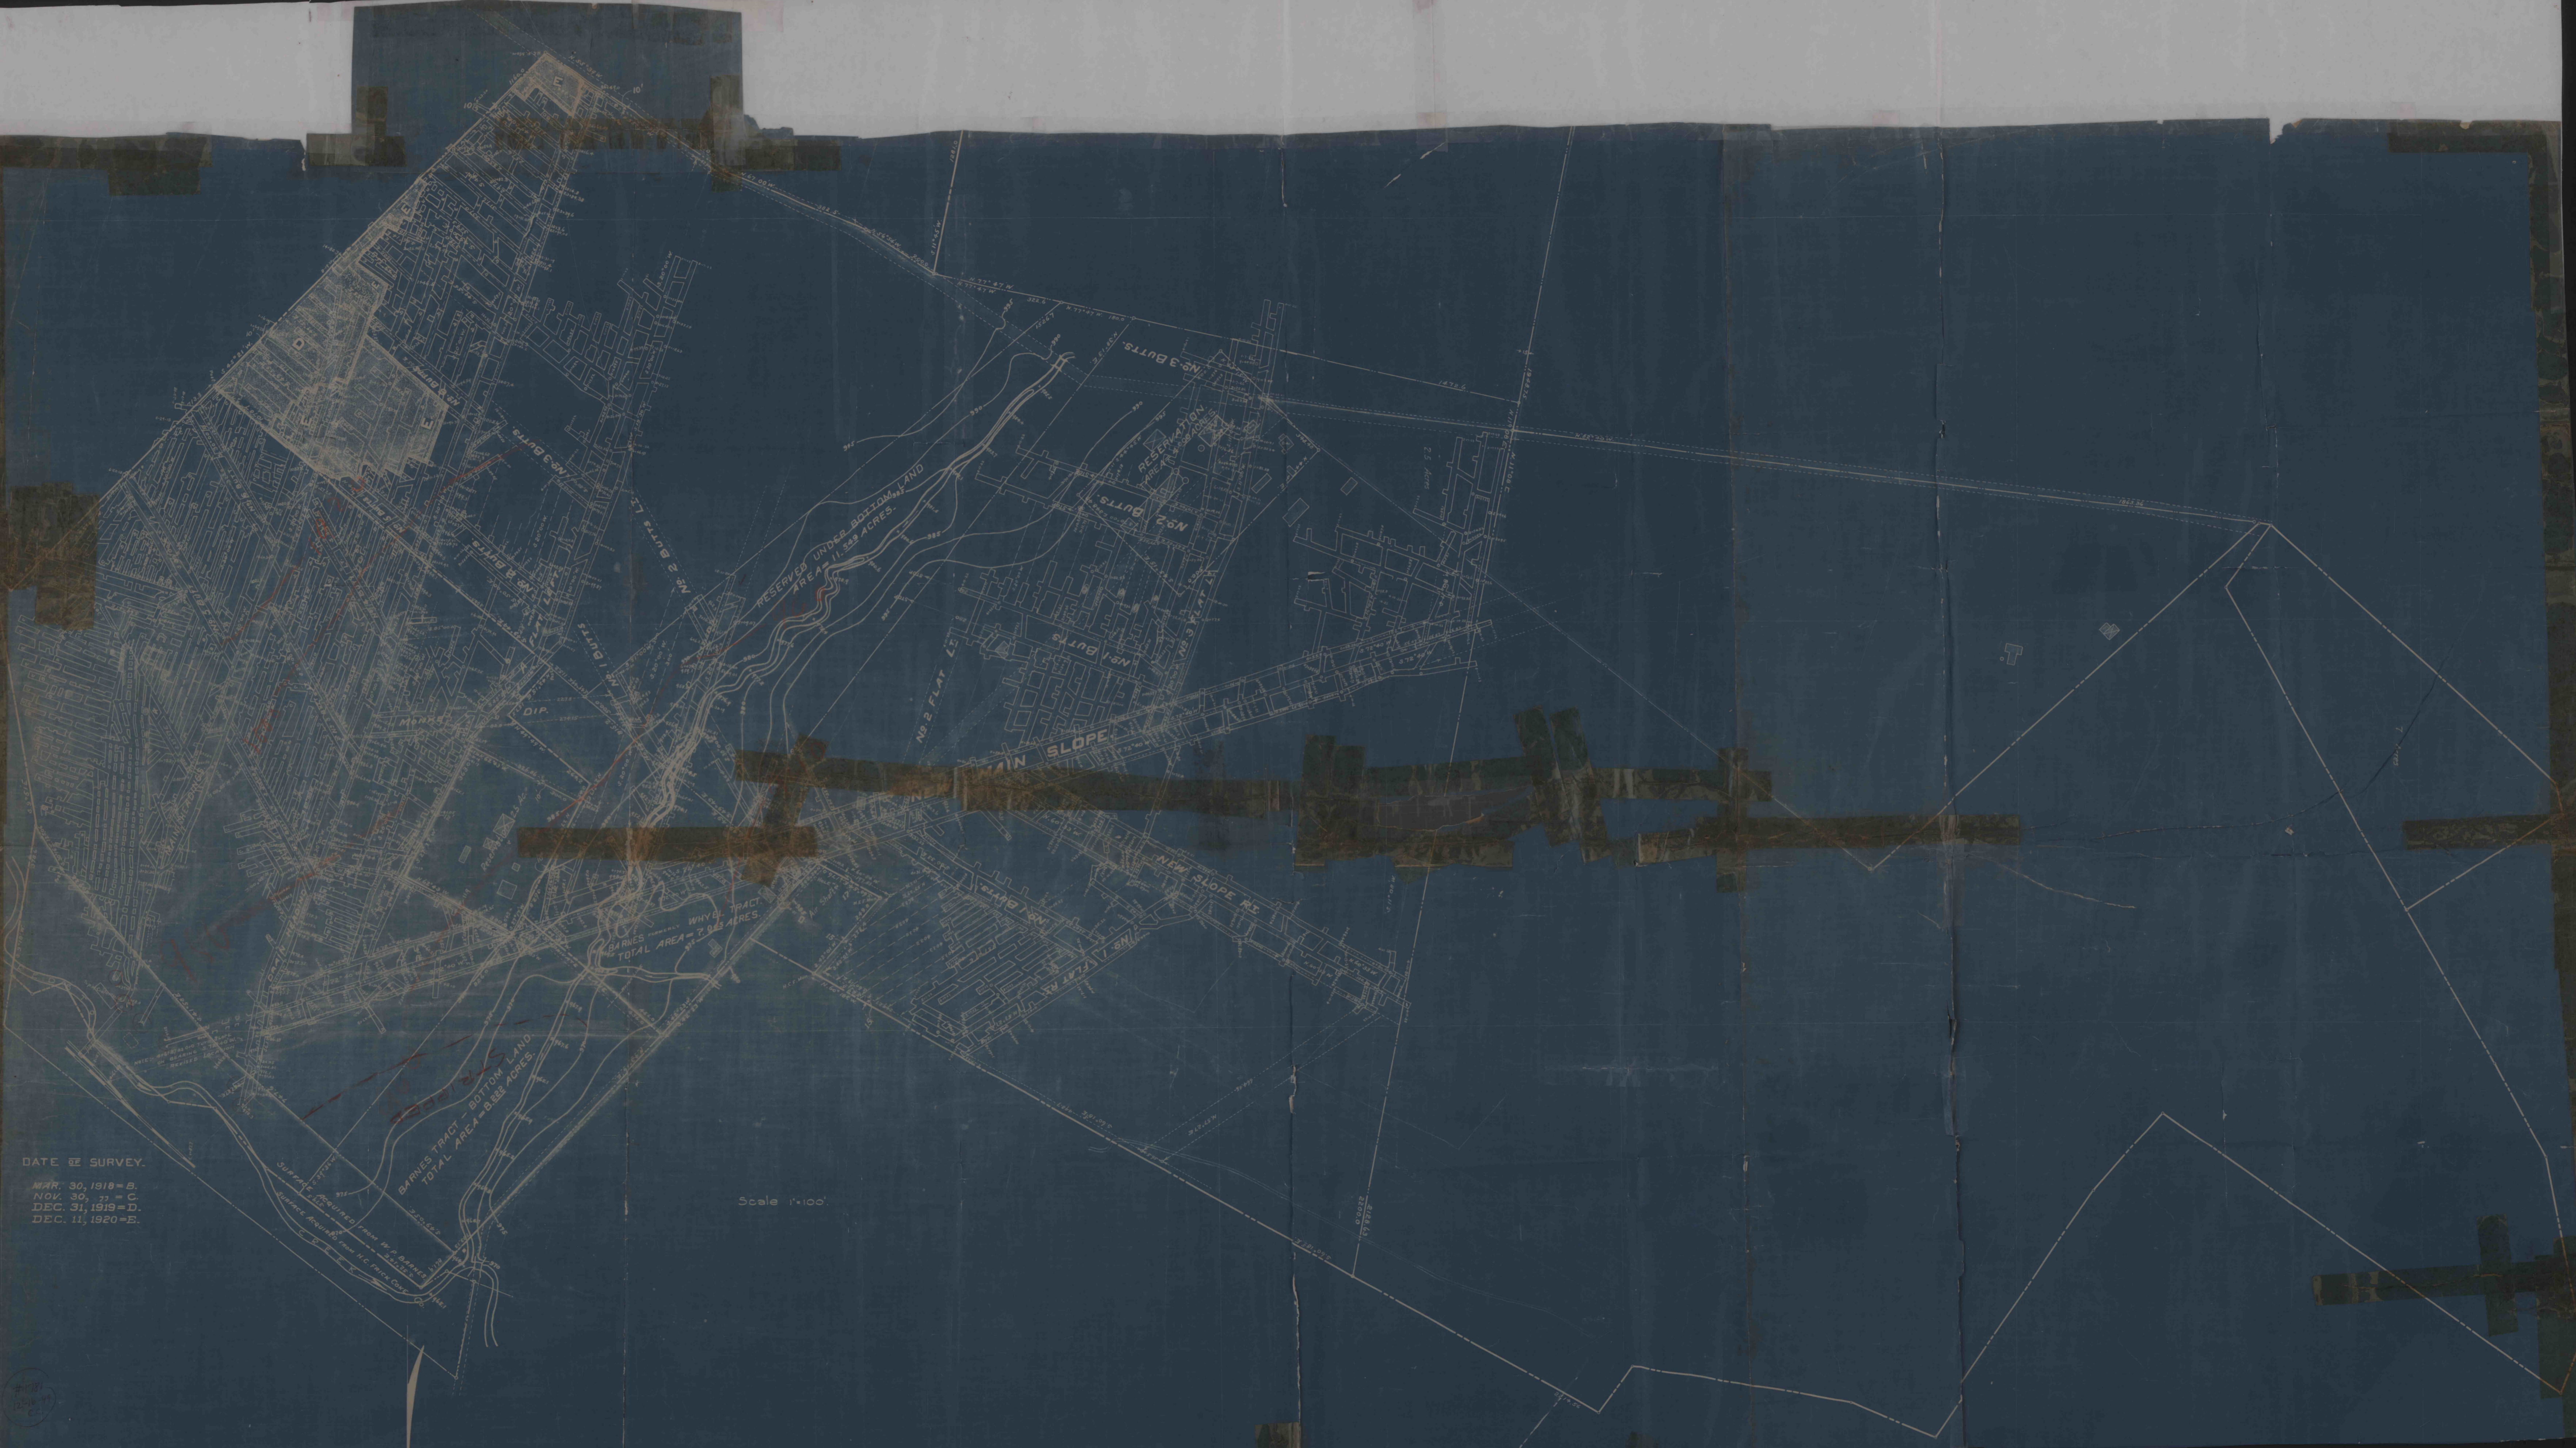

Scale 1"=100'