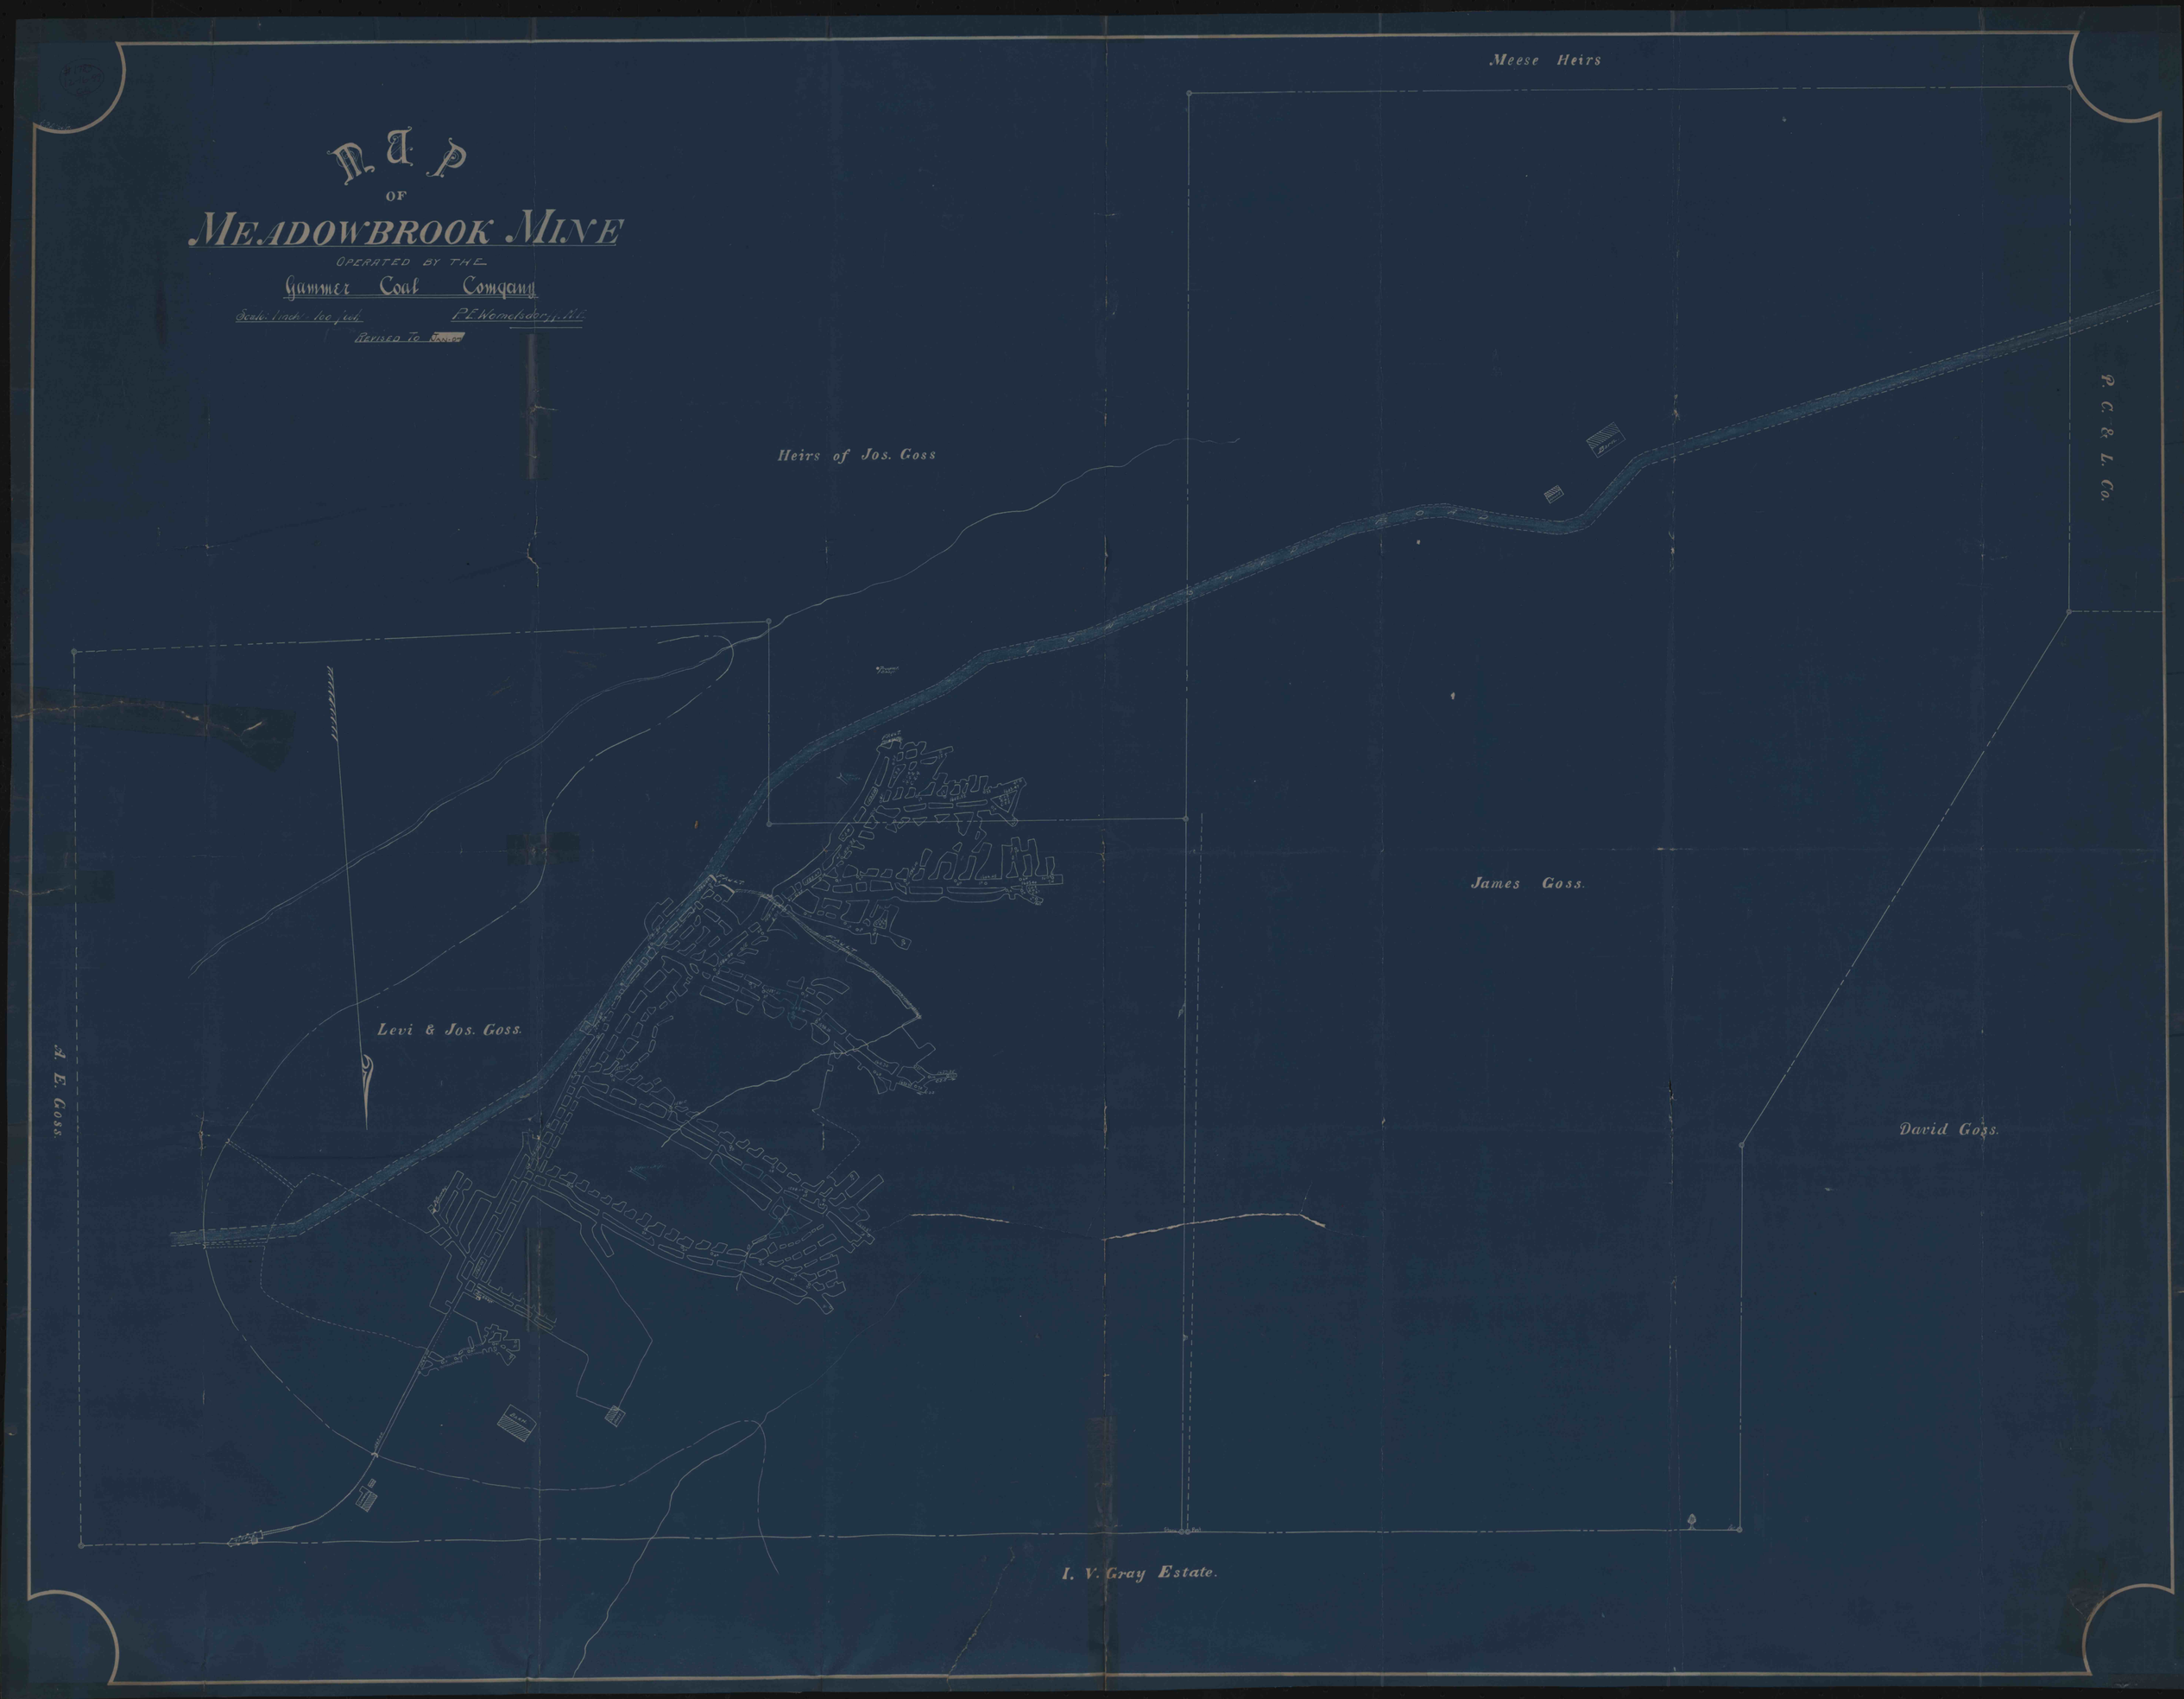

MAP
OF
MEADOWBROOK MINE
OPERATED BY THE
Gammer Coal Company
Scale: 1 inch = 100 feet
P. E. Womelsdorff, M.E.
Meese Heirs
Heirs of Jos. Goss
P. C. & L. Co.
James Goss.
Levi & Jos. Goss.
A. E. Goss.
David Goss.
I. V. Gray Estate.