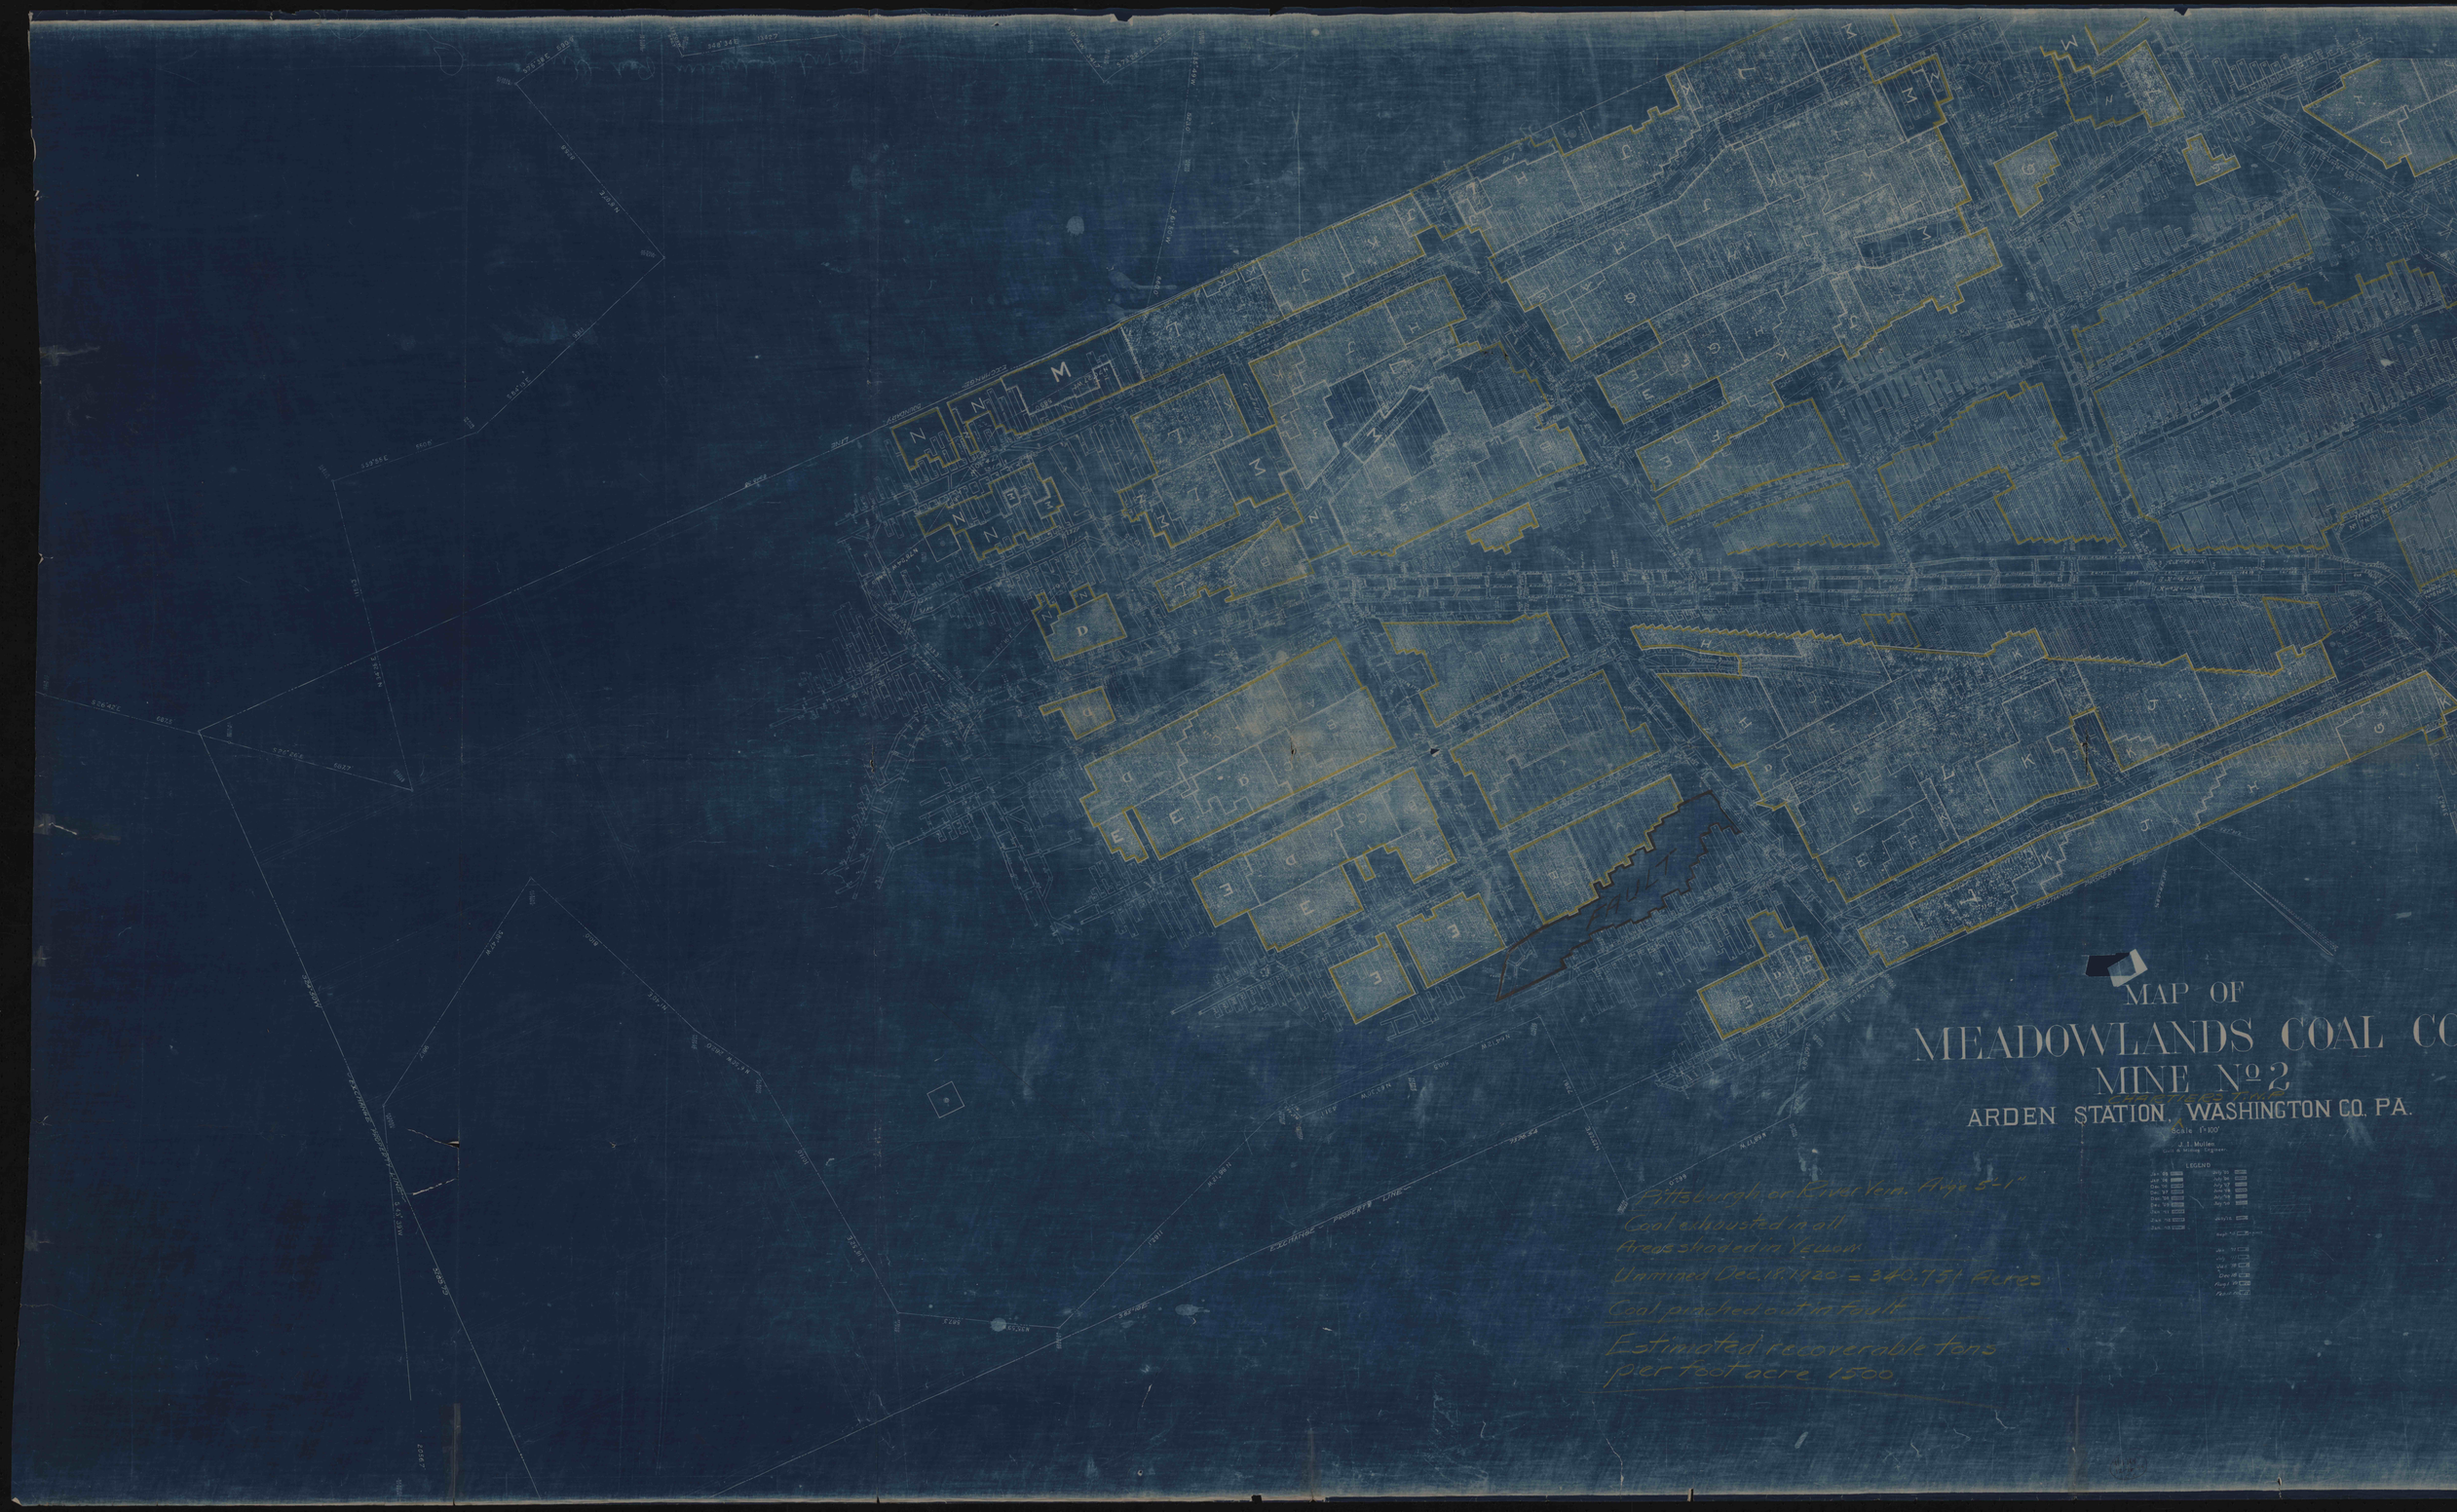
MAP OF
MEADOWLANDS COAL CO
MINE No 2
ARDEN STATION, WASHINGTON CO. PA.
Scale 1"=100'
J. I. Mullen
Civil & Mining Engineer
LEGEND
Pittsburgh or River Vein. Avge 5'-1"
Coal exhausted in all
Areas shaded in Yellow
Unmined Dec. 18, 1920 = 340.751 Acres
Coal pinched out in fault
Estimated recoverable tons
per foot acre 1500
FAULT
EXCHANGE PROPERTY LINE