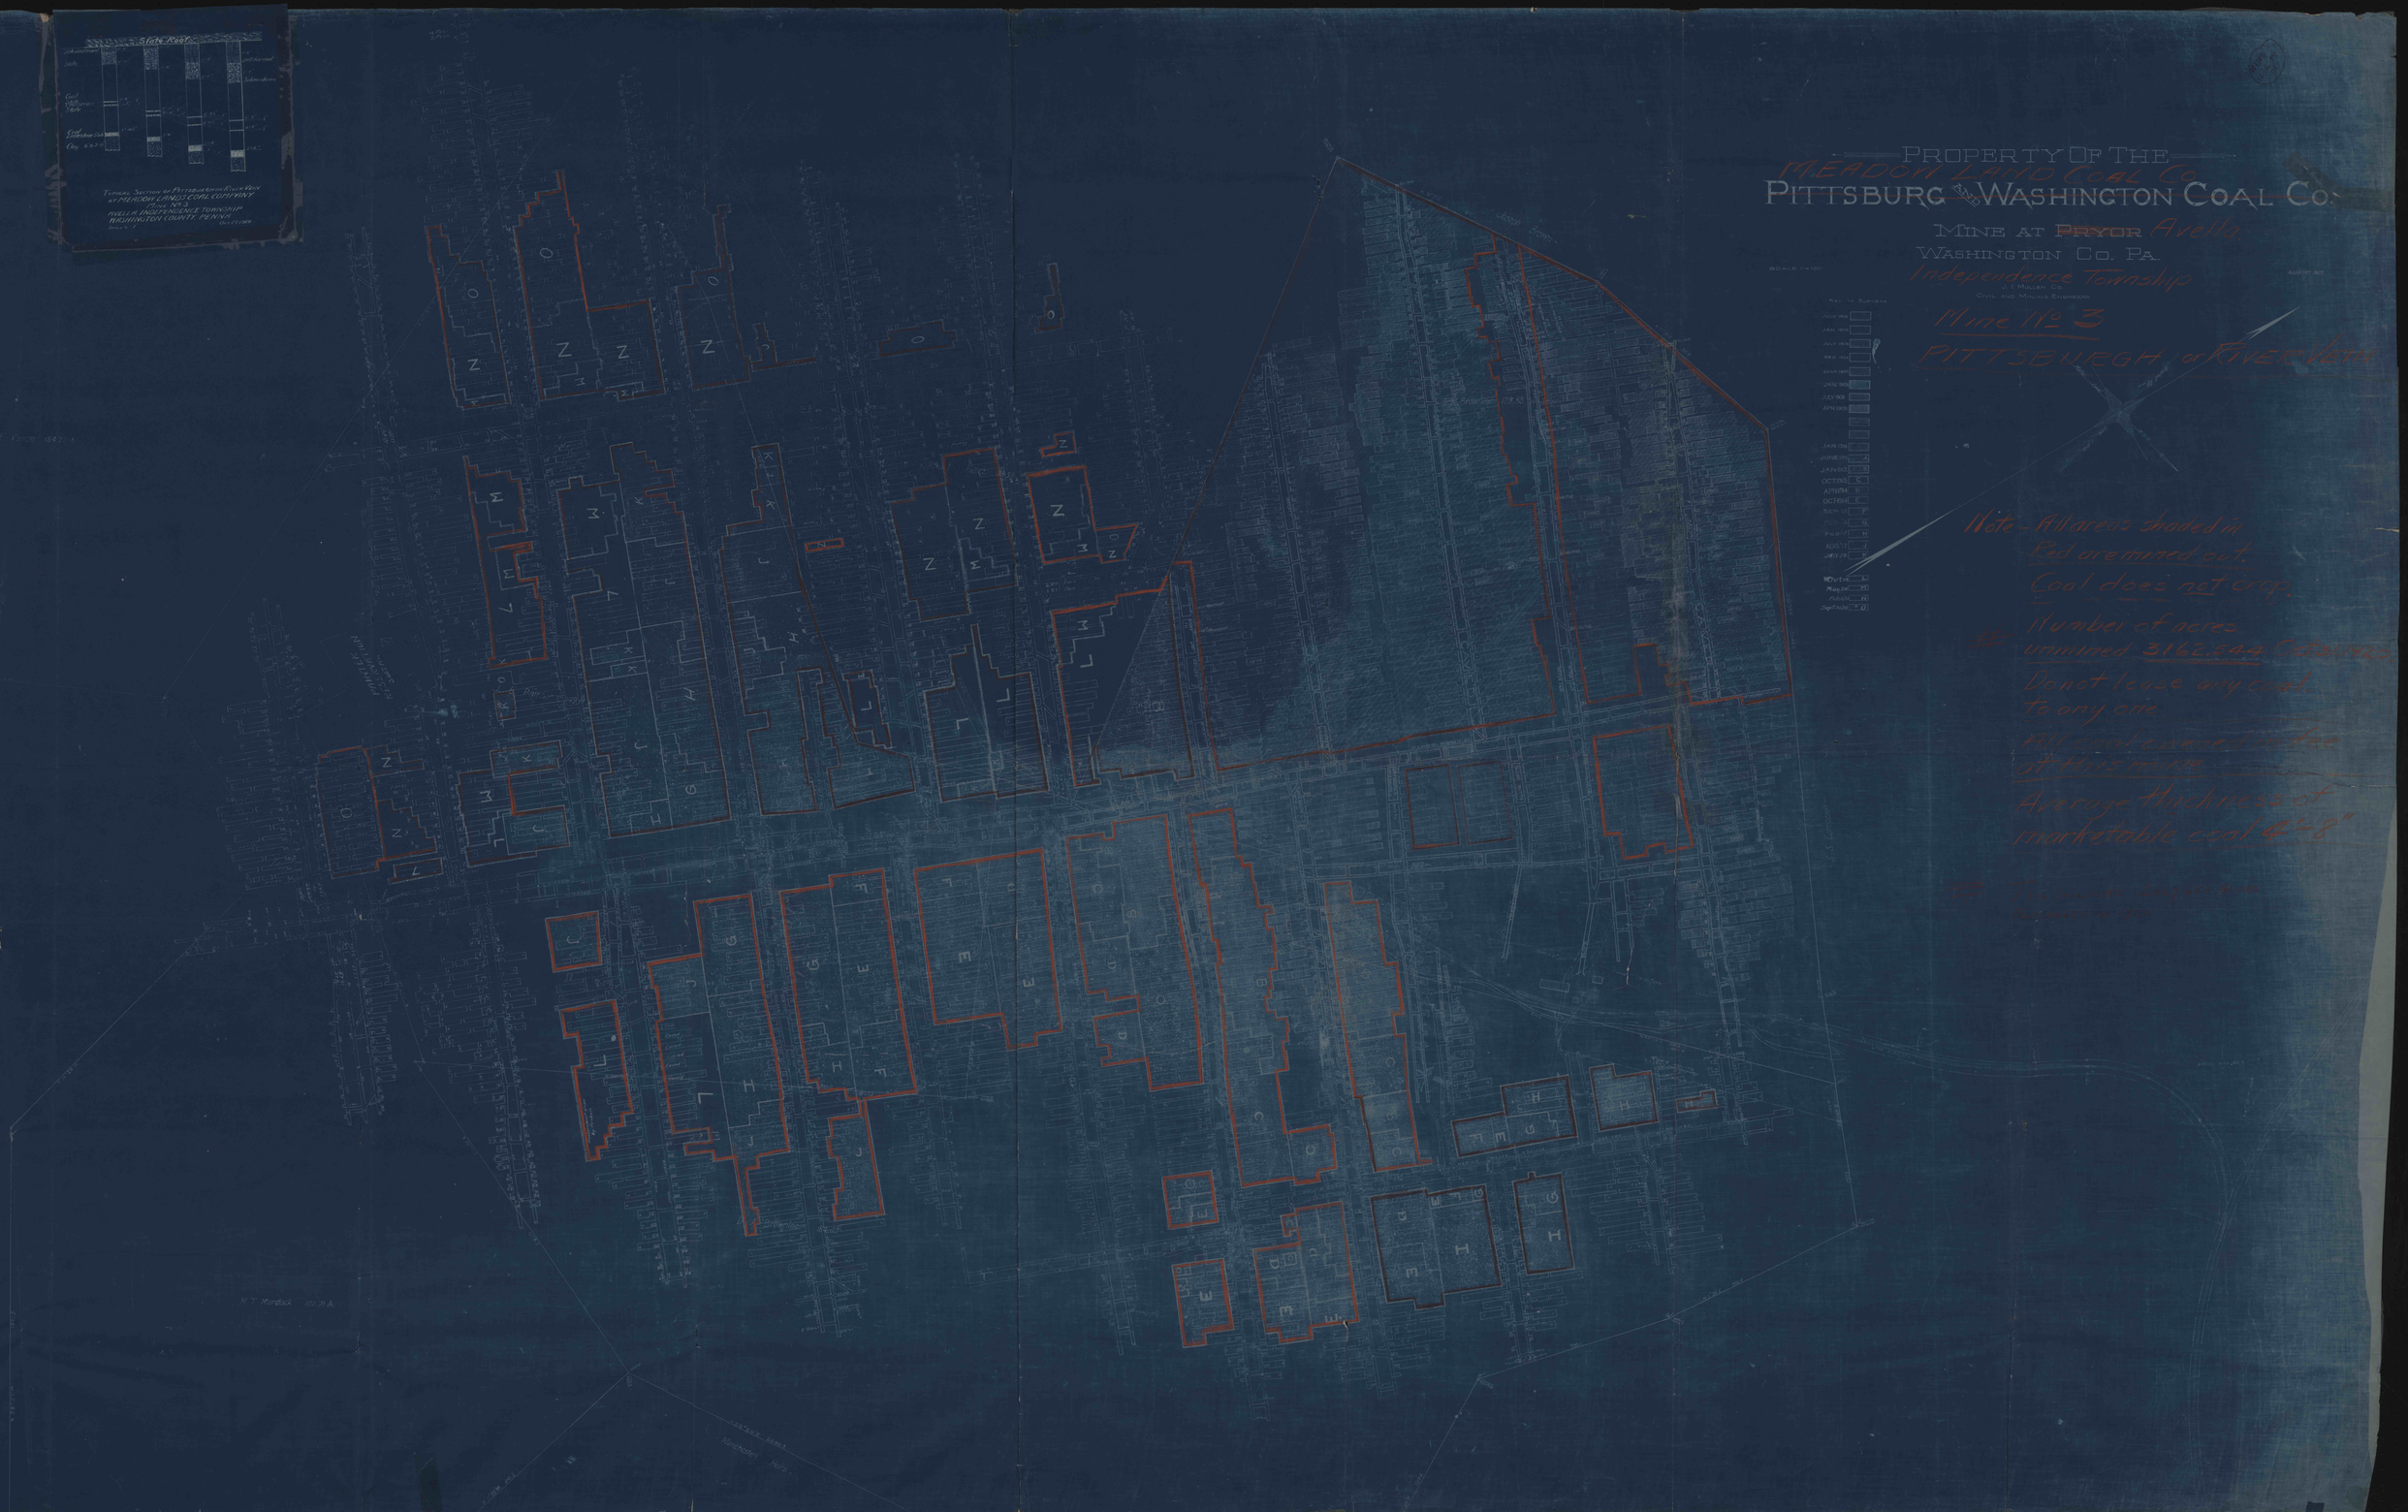
PROPERTY OF THE
MEADOW LAND COAL CO.
PITTSBURG AND WASHINGTON COAL CO.
MINE AT ~~PRYOR~~ Avella
WASHINGTON CO. PA.
Independence Township
J. I. MULLEN CO.
CIVIL AND MINING ENGINEERS
Mine No 3
PITTSBURGH or RIVER VALLEY
Note - All areas shaded in Red are mined out.
Coal does not crop.
Number of acres unmined 3162.544 Cubic Yds
Do not lease any coal to any one
Average thickness of marketable coal 4'-8"