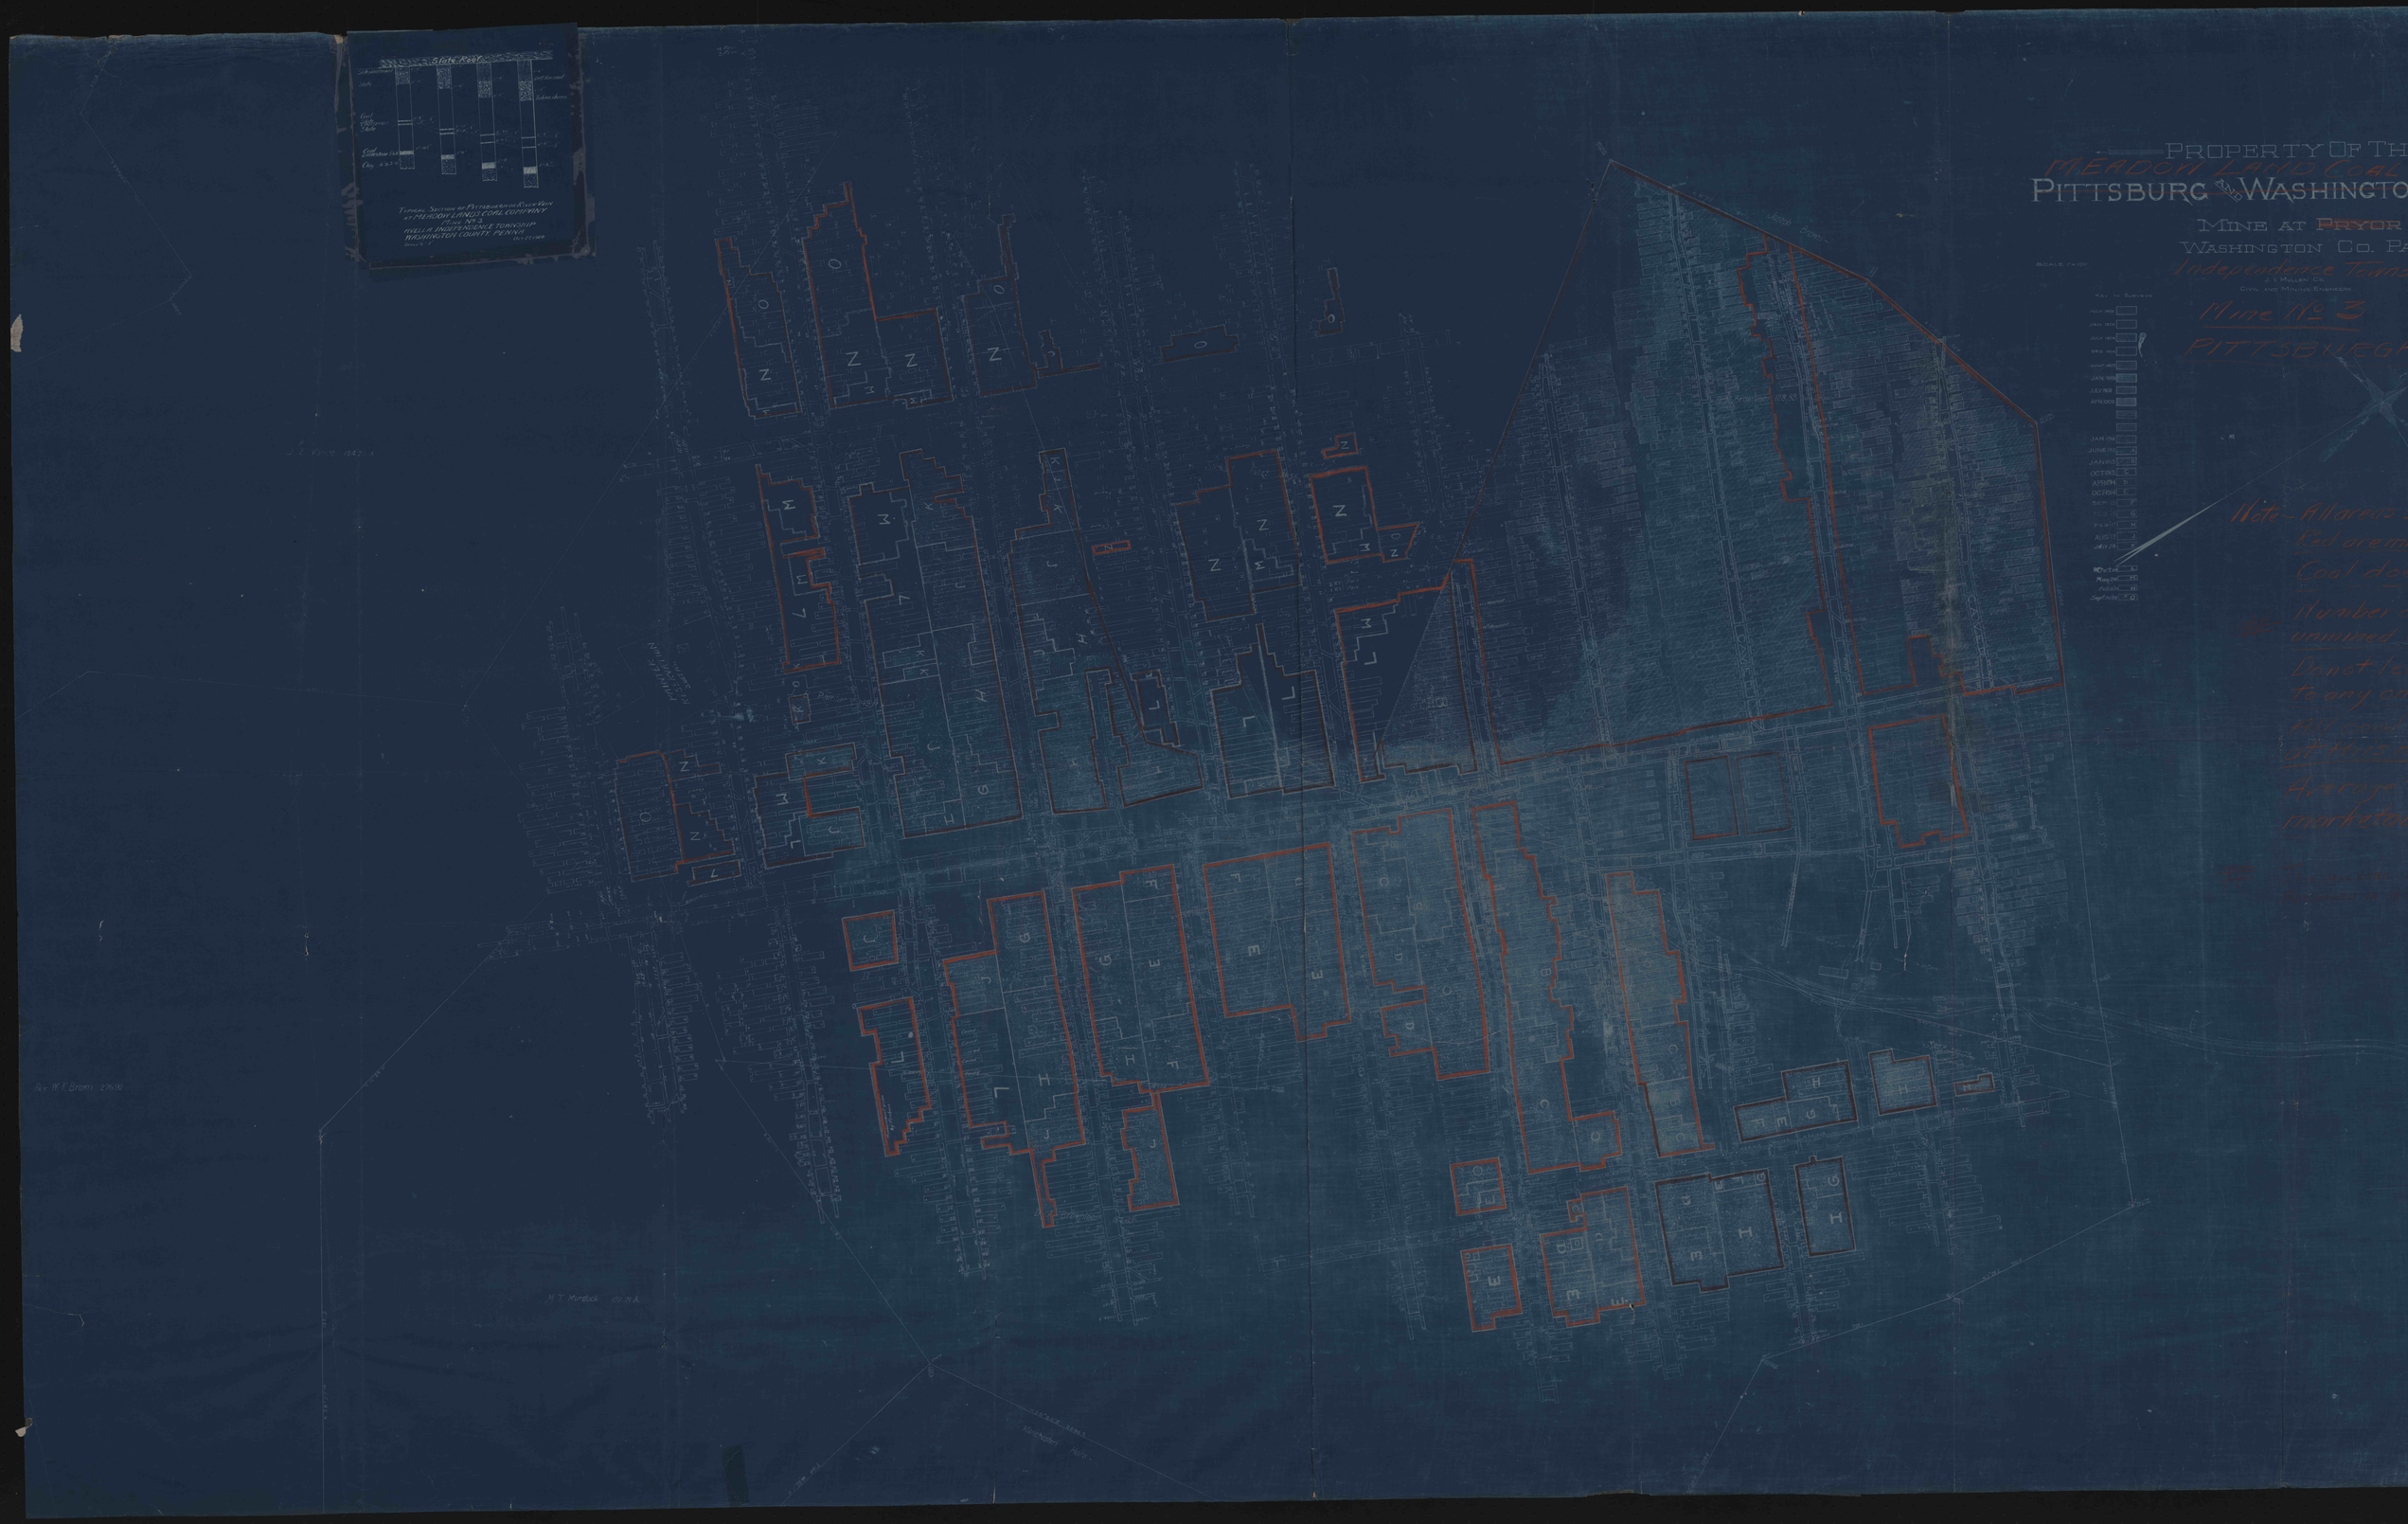

PROPERTY OF TH
MEADOW LAND COAL
PITTSBURG AND WASHINGTO
MINE AT PRYOR
WASHINGTON CO. PA
Independence Towns
J. I. MULLEN CO.
CIVIL AND MINING ENGINEERS
Mine No 3
PITTSBURG
Note - All areas
Red are
Coal do
Number
unmined
Do not
to any
Average
marketa