


MELCROFT COAL CO

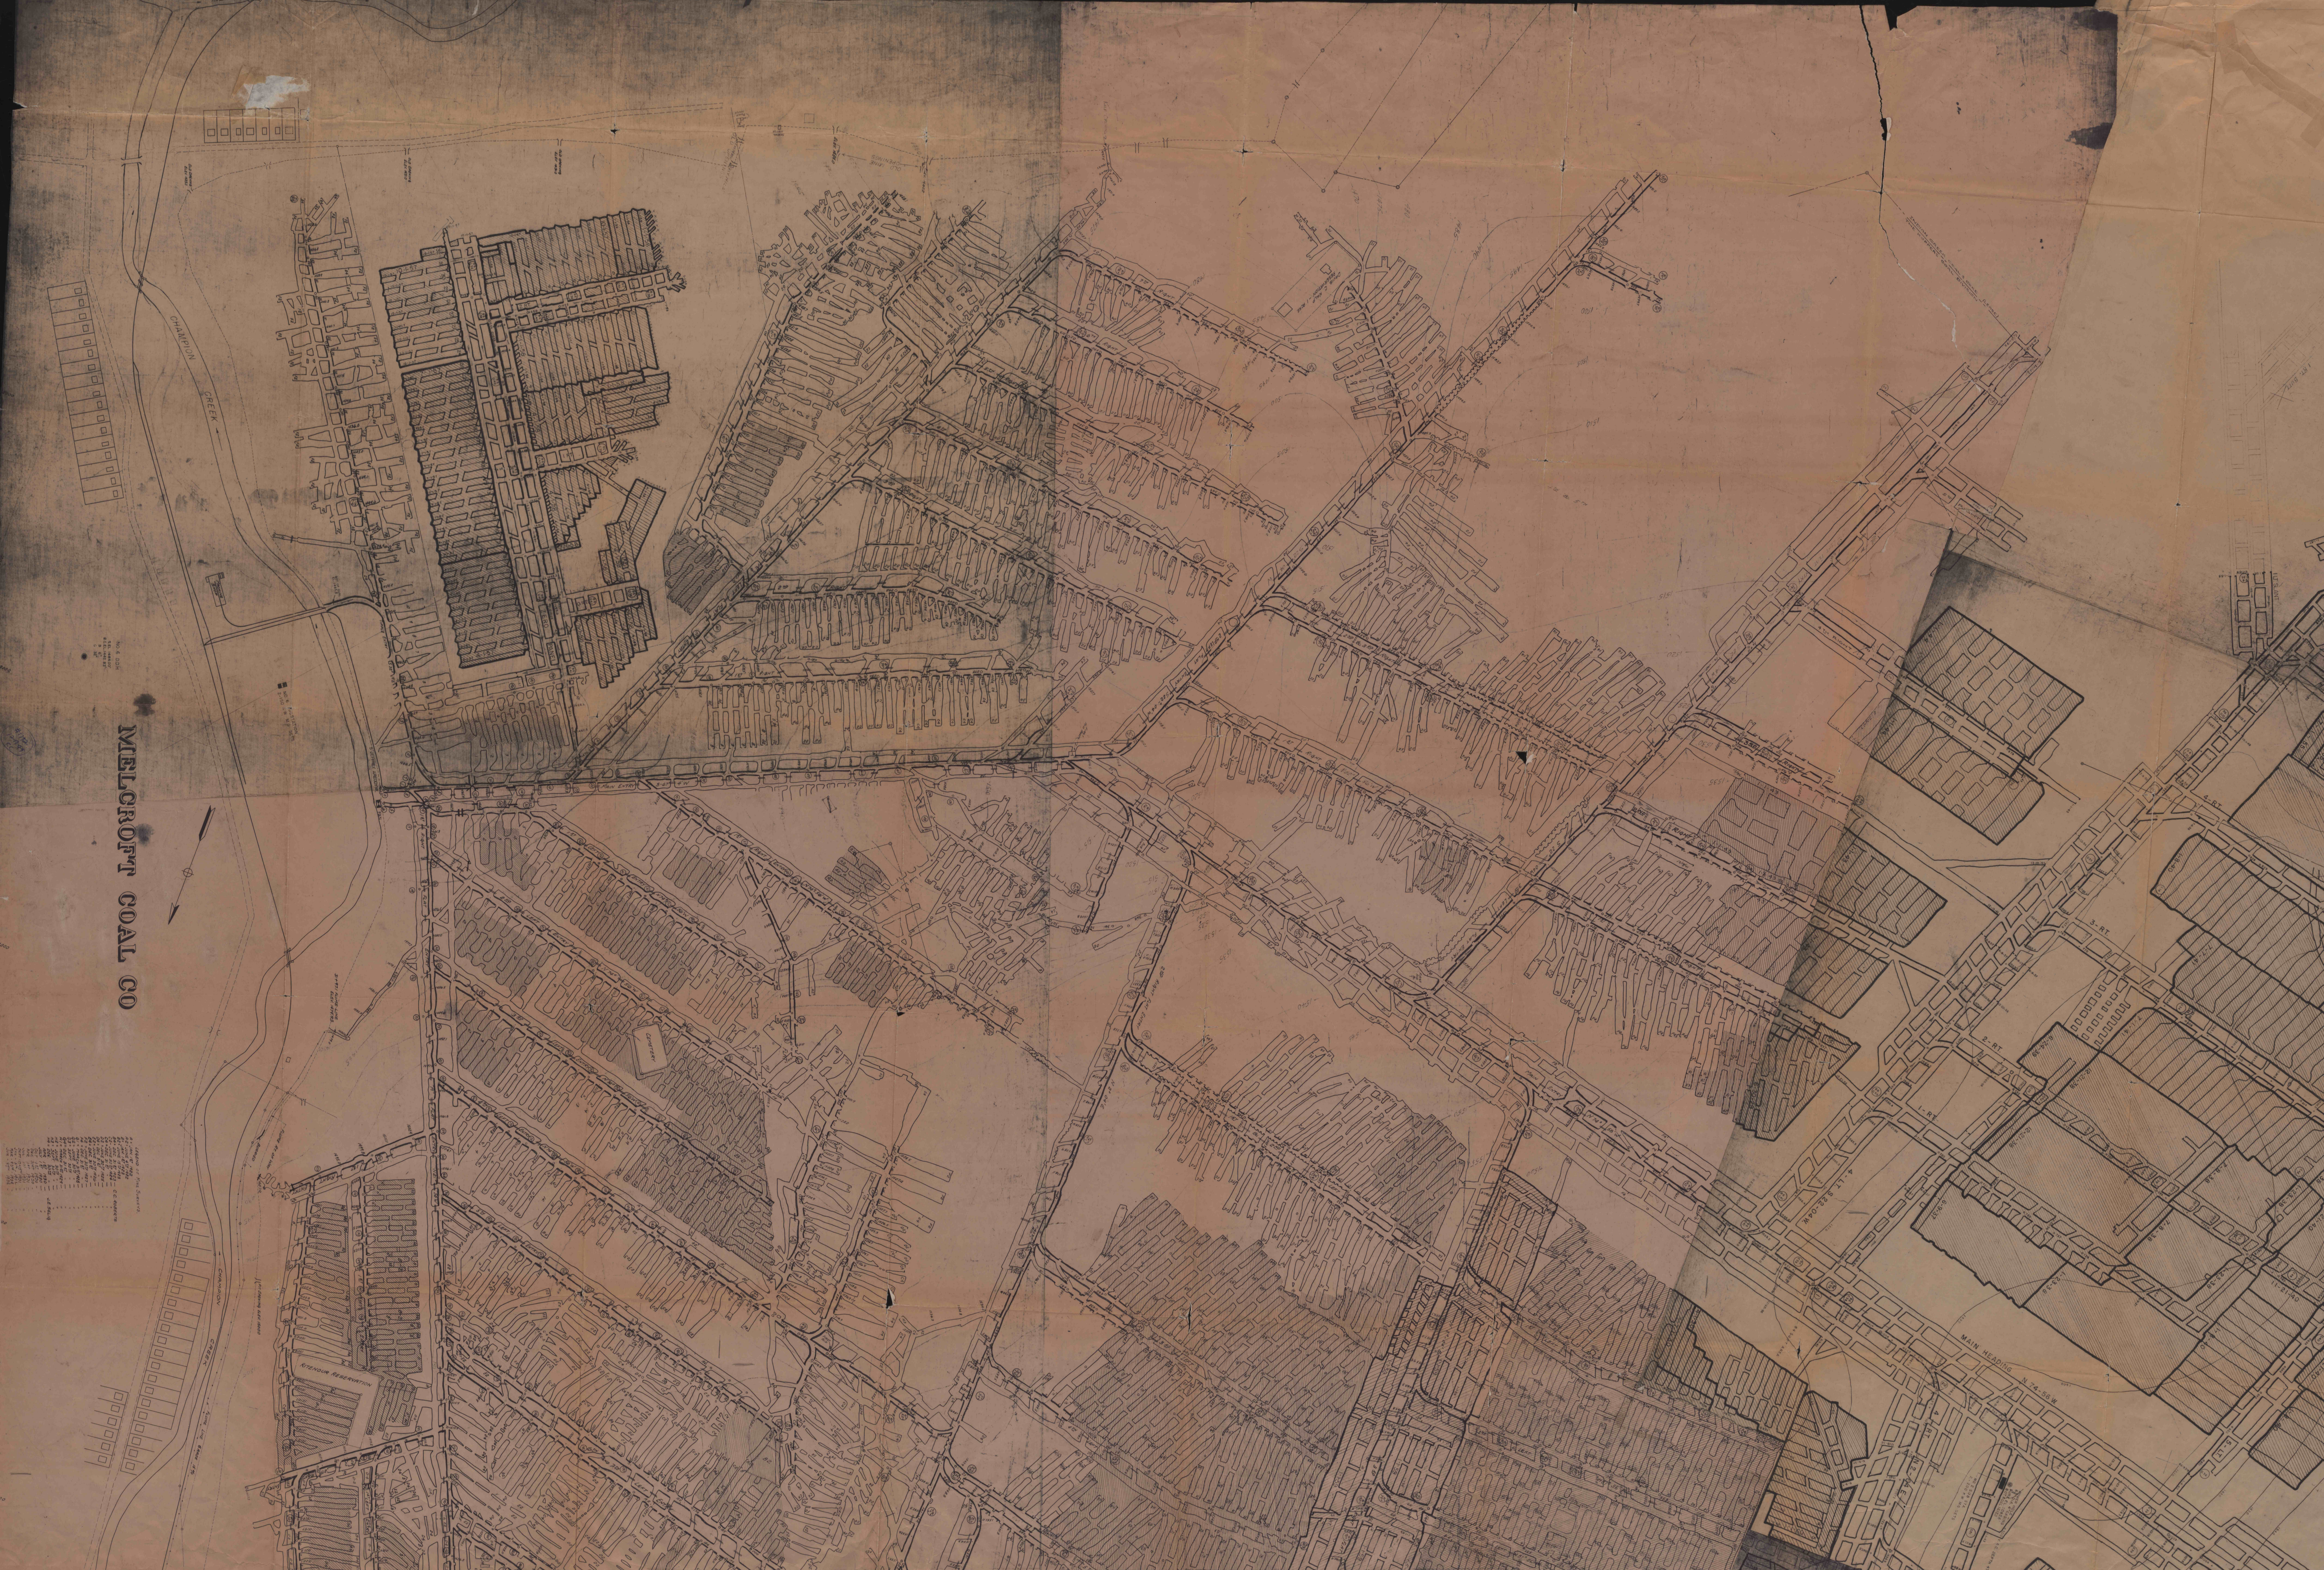

