

MELROSE MINE


SOUTH FAYETTE COAL CO.

SCALE 1"=100'

MAR 1915

ANDREWS & SOUTHARD
CURRY BLDG. PITTS. PA.

Worked Out and Abandoned, Aug 31, 1921

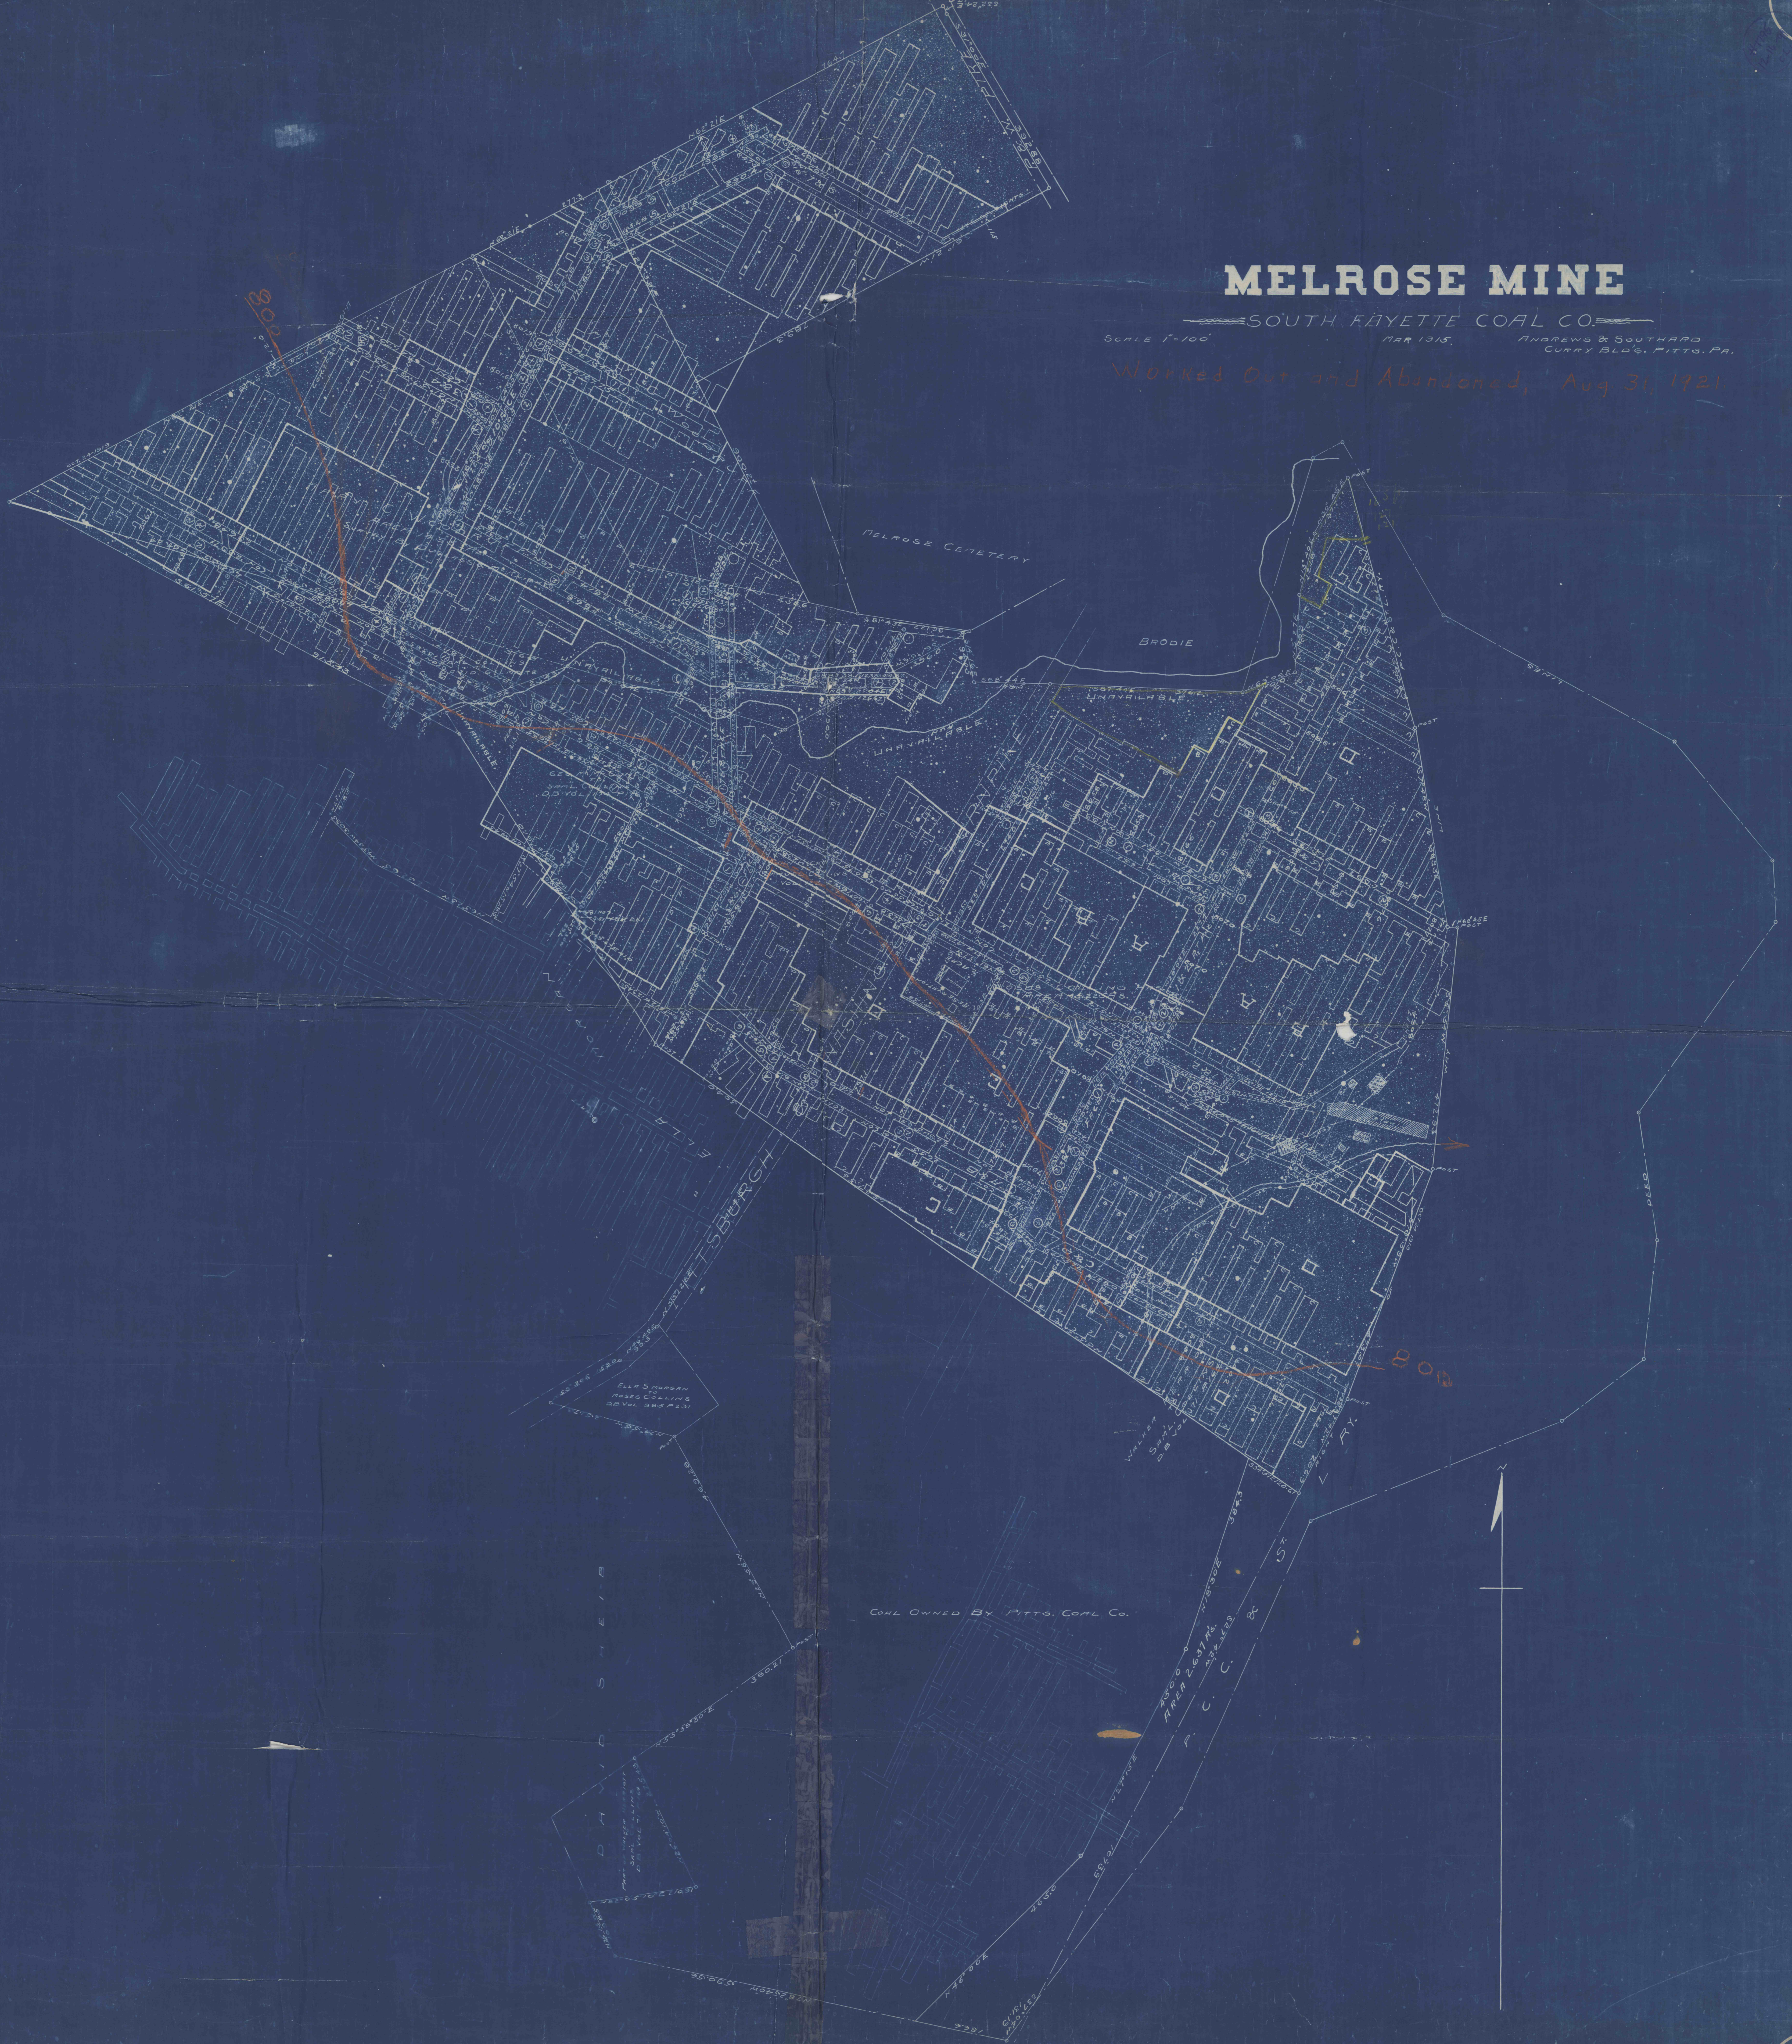

ELI'S SHEDS
ROCK CELLARS
DEVAL 385 P131

COAL OWNED BY PITTS. COAL CO.

WALKER
SHAFT
DEVAL 385 P131

AREA 2, 6, 7, 8,100

P. C. C.

ST

