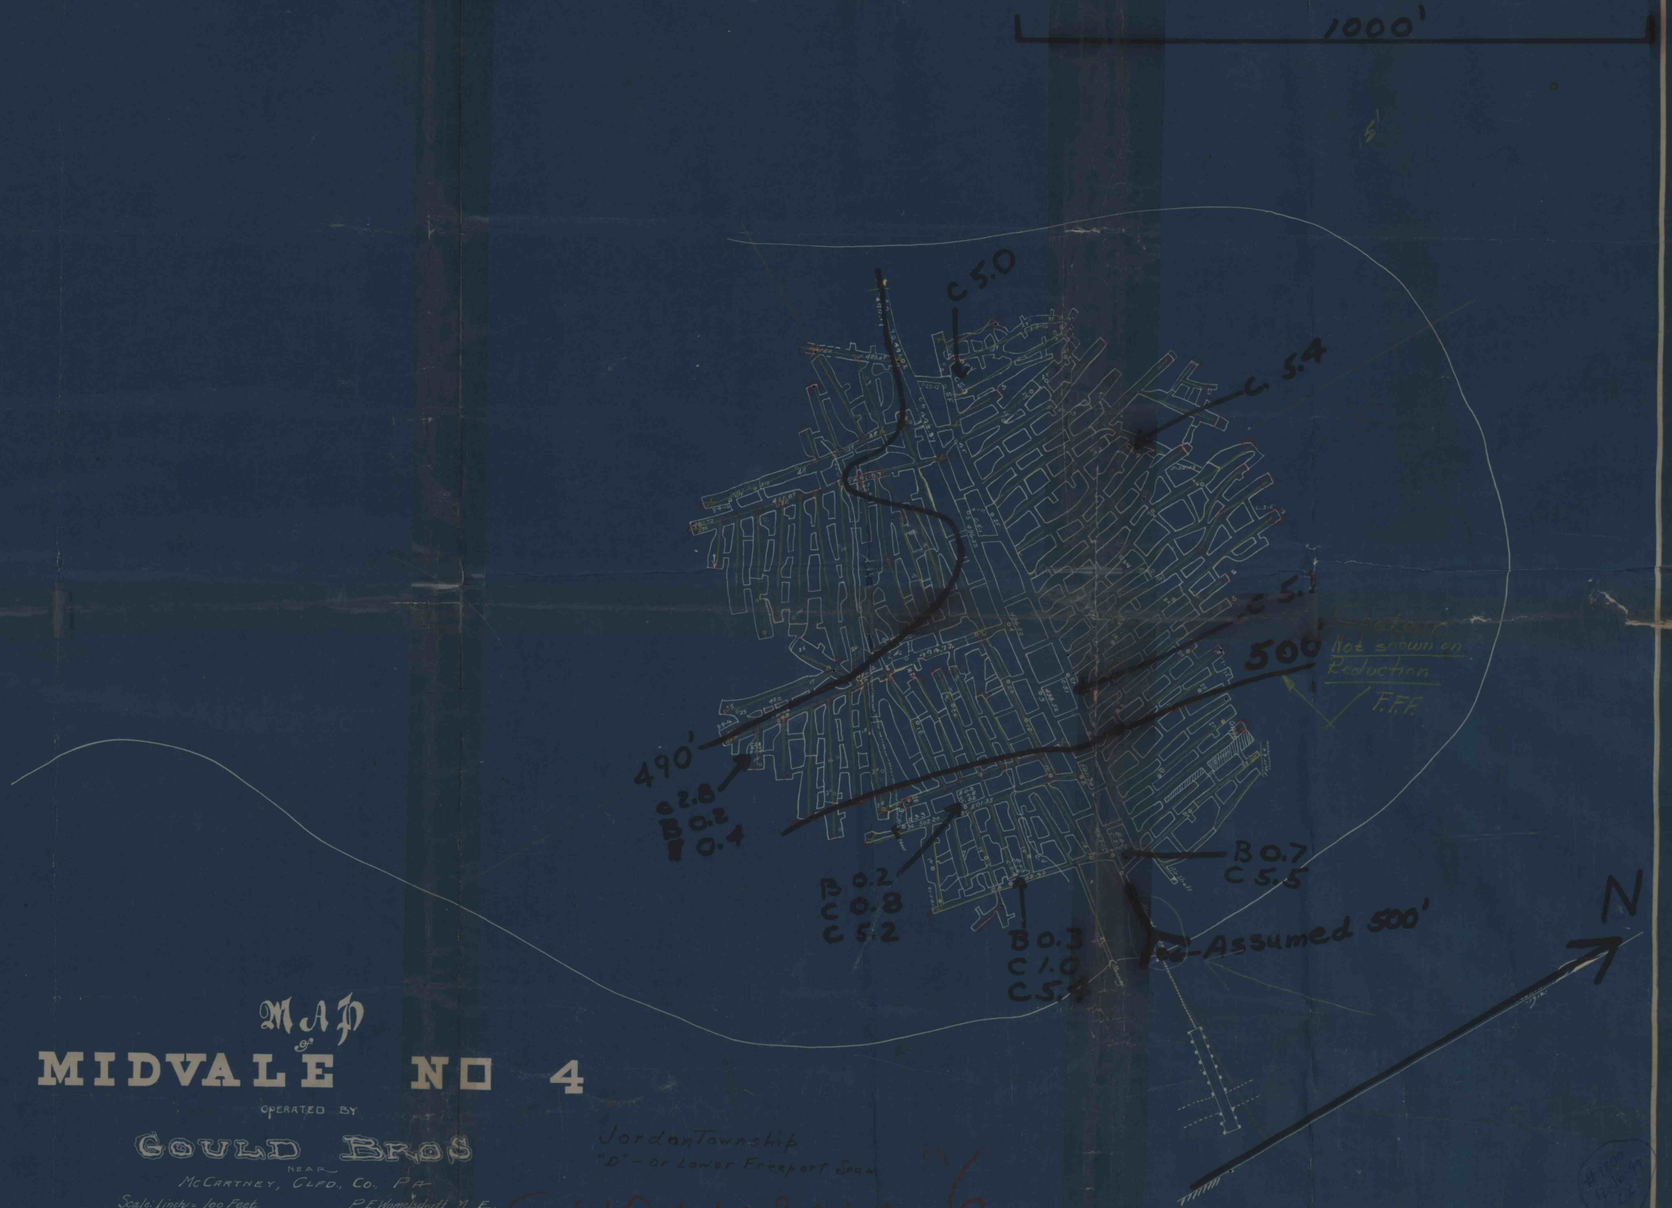

MAP of MIDVALE NO 4

OPERATED BY

GOULD BROS

NEAR

McCARTNEY, CLFD. CO. PA

Scale: 1 inch = 100 Feet

-1912-

P.E. Homesdorff M.E.

Jordan Township
"D" or Lower Freeport Seam

Surveying 6

Index