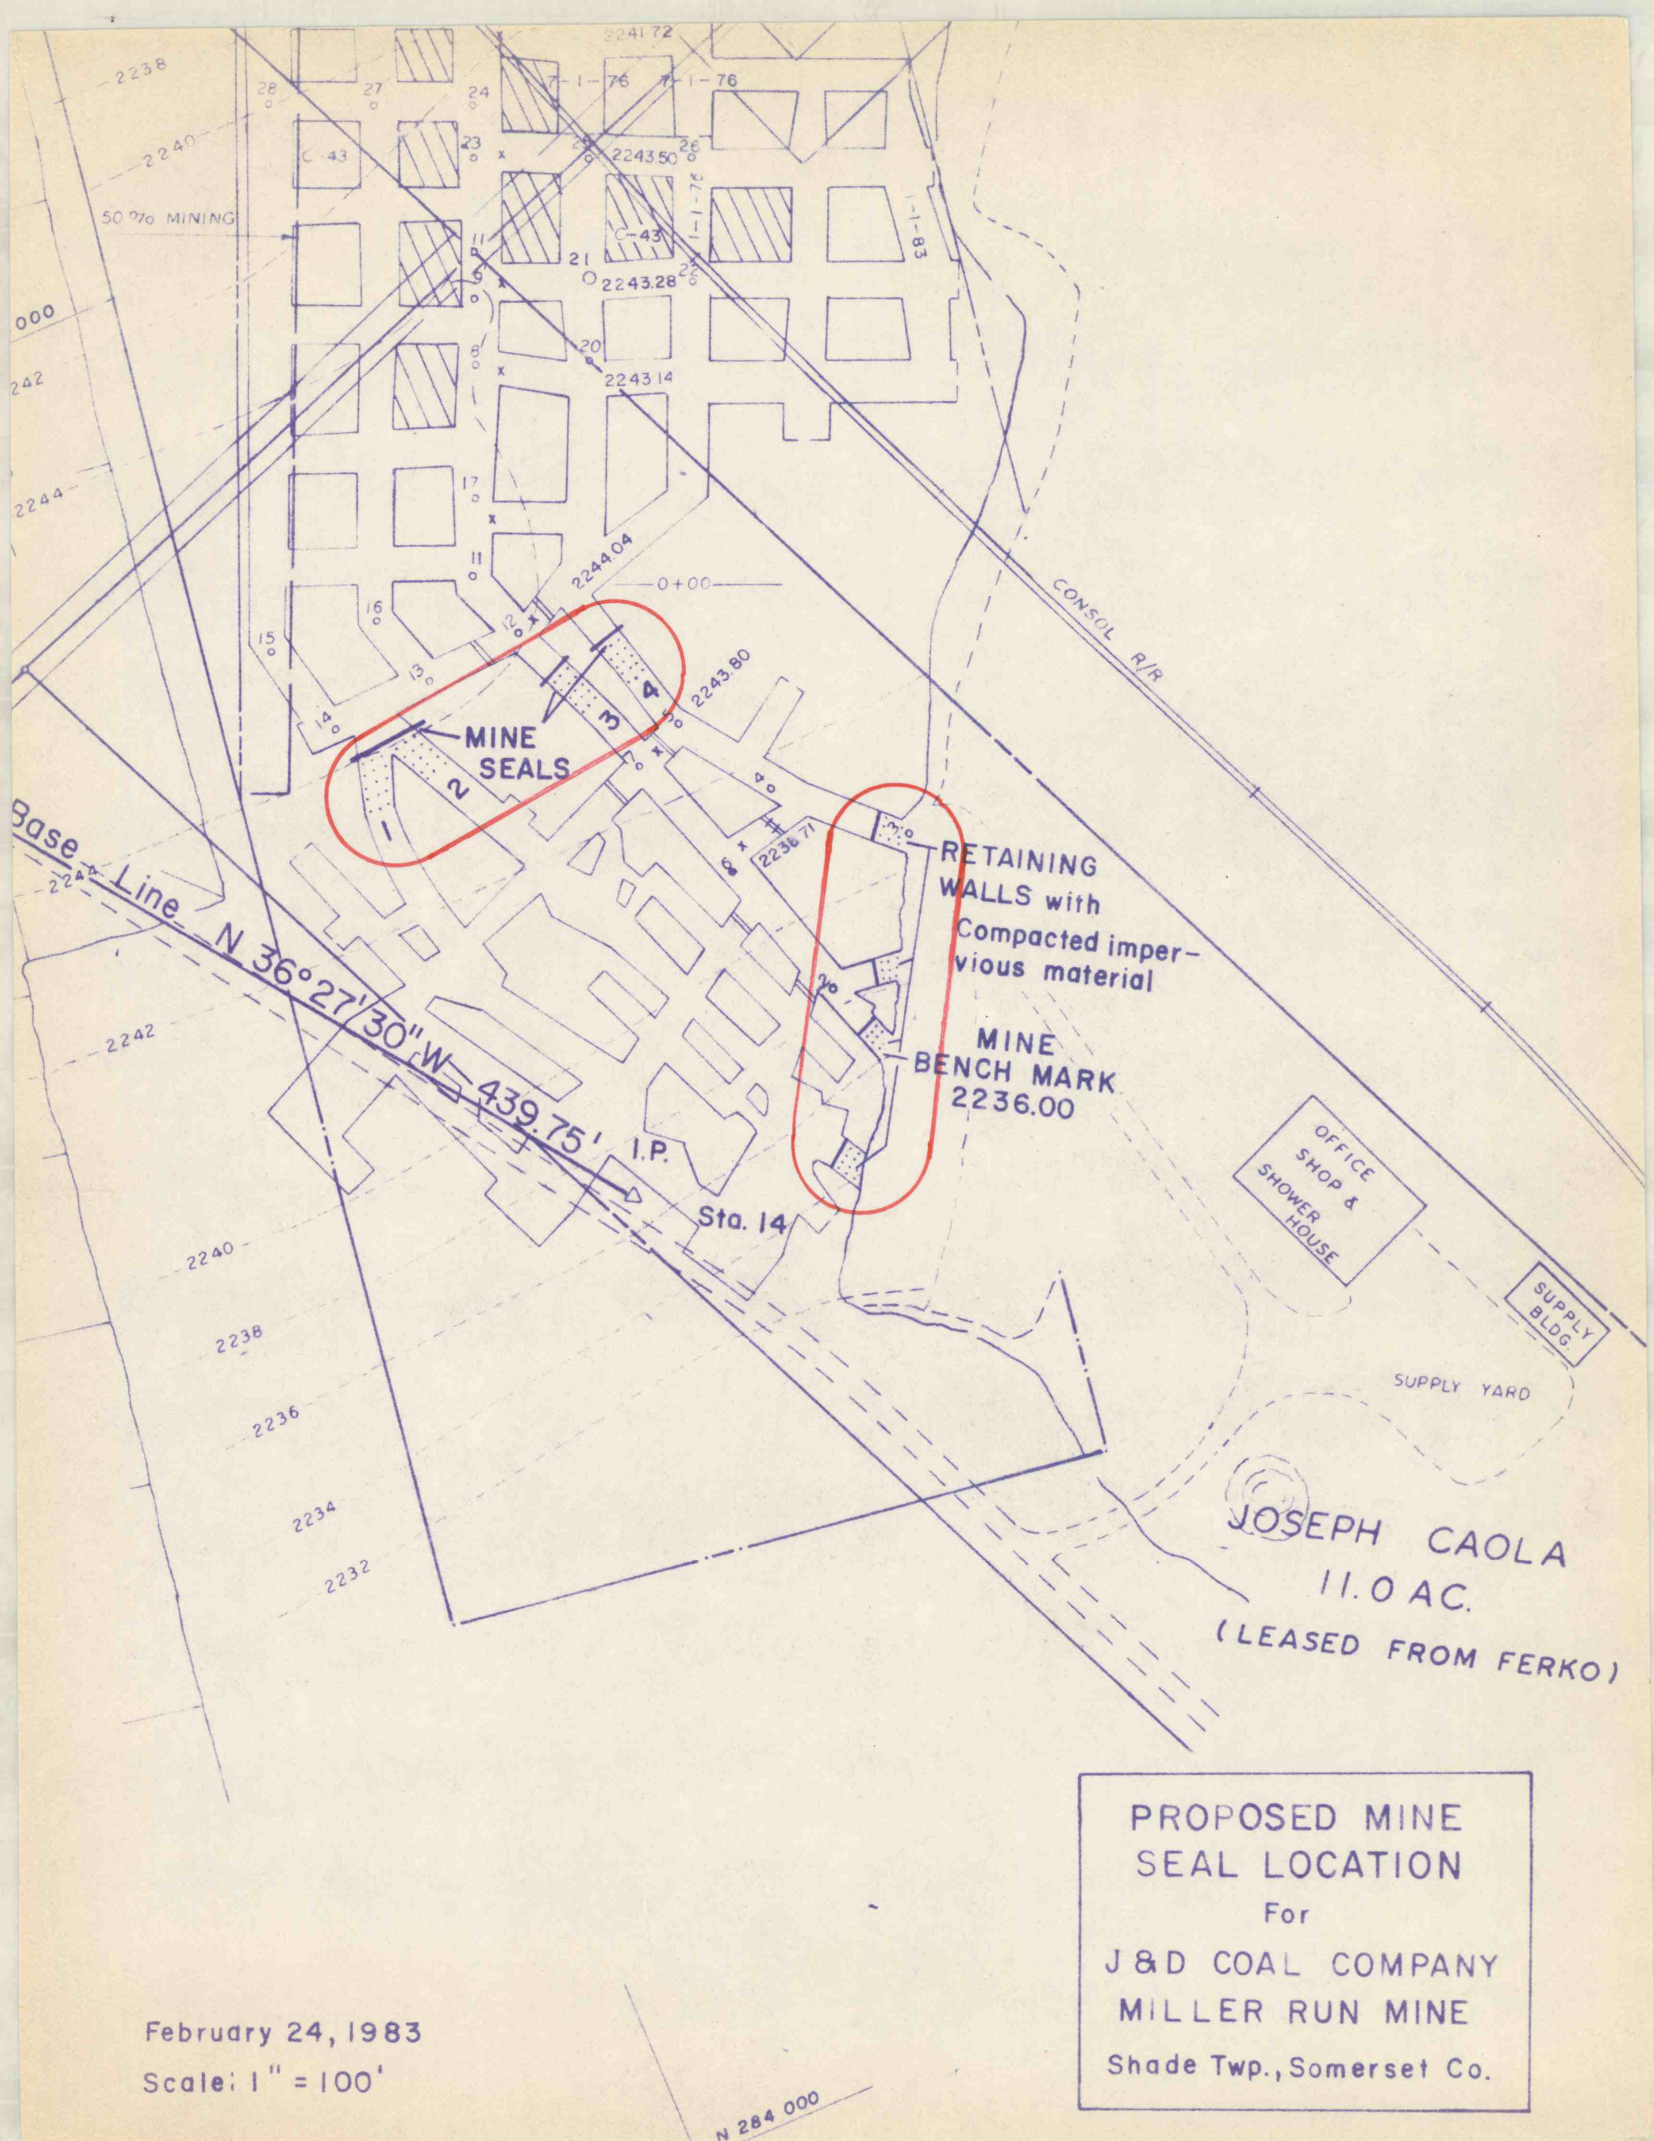

PROPOSED MINE SEAL LOCATION

For

J&D COAL COMPANY

MILLER RUN MINE

Shade Twp., Somerset Co.

February 24, 1983

Scale: 1" = 100'