


CLYDE COAL CO.

CLYDE COAL CO.

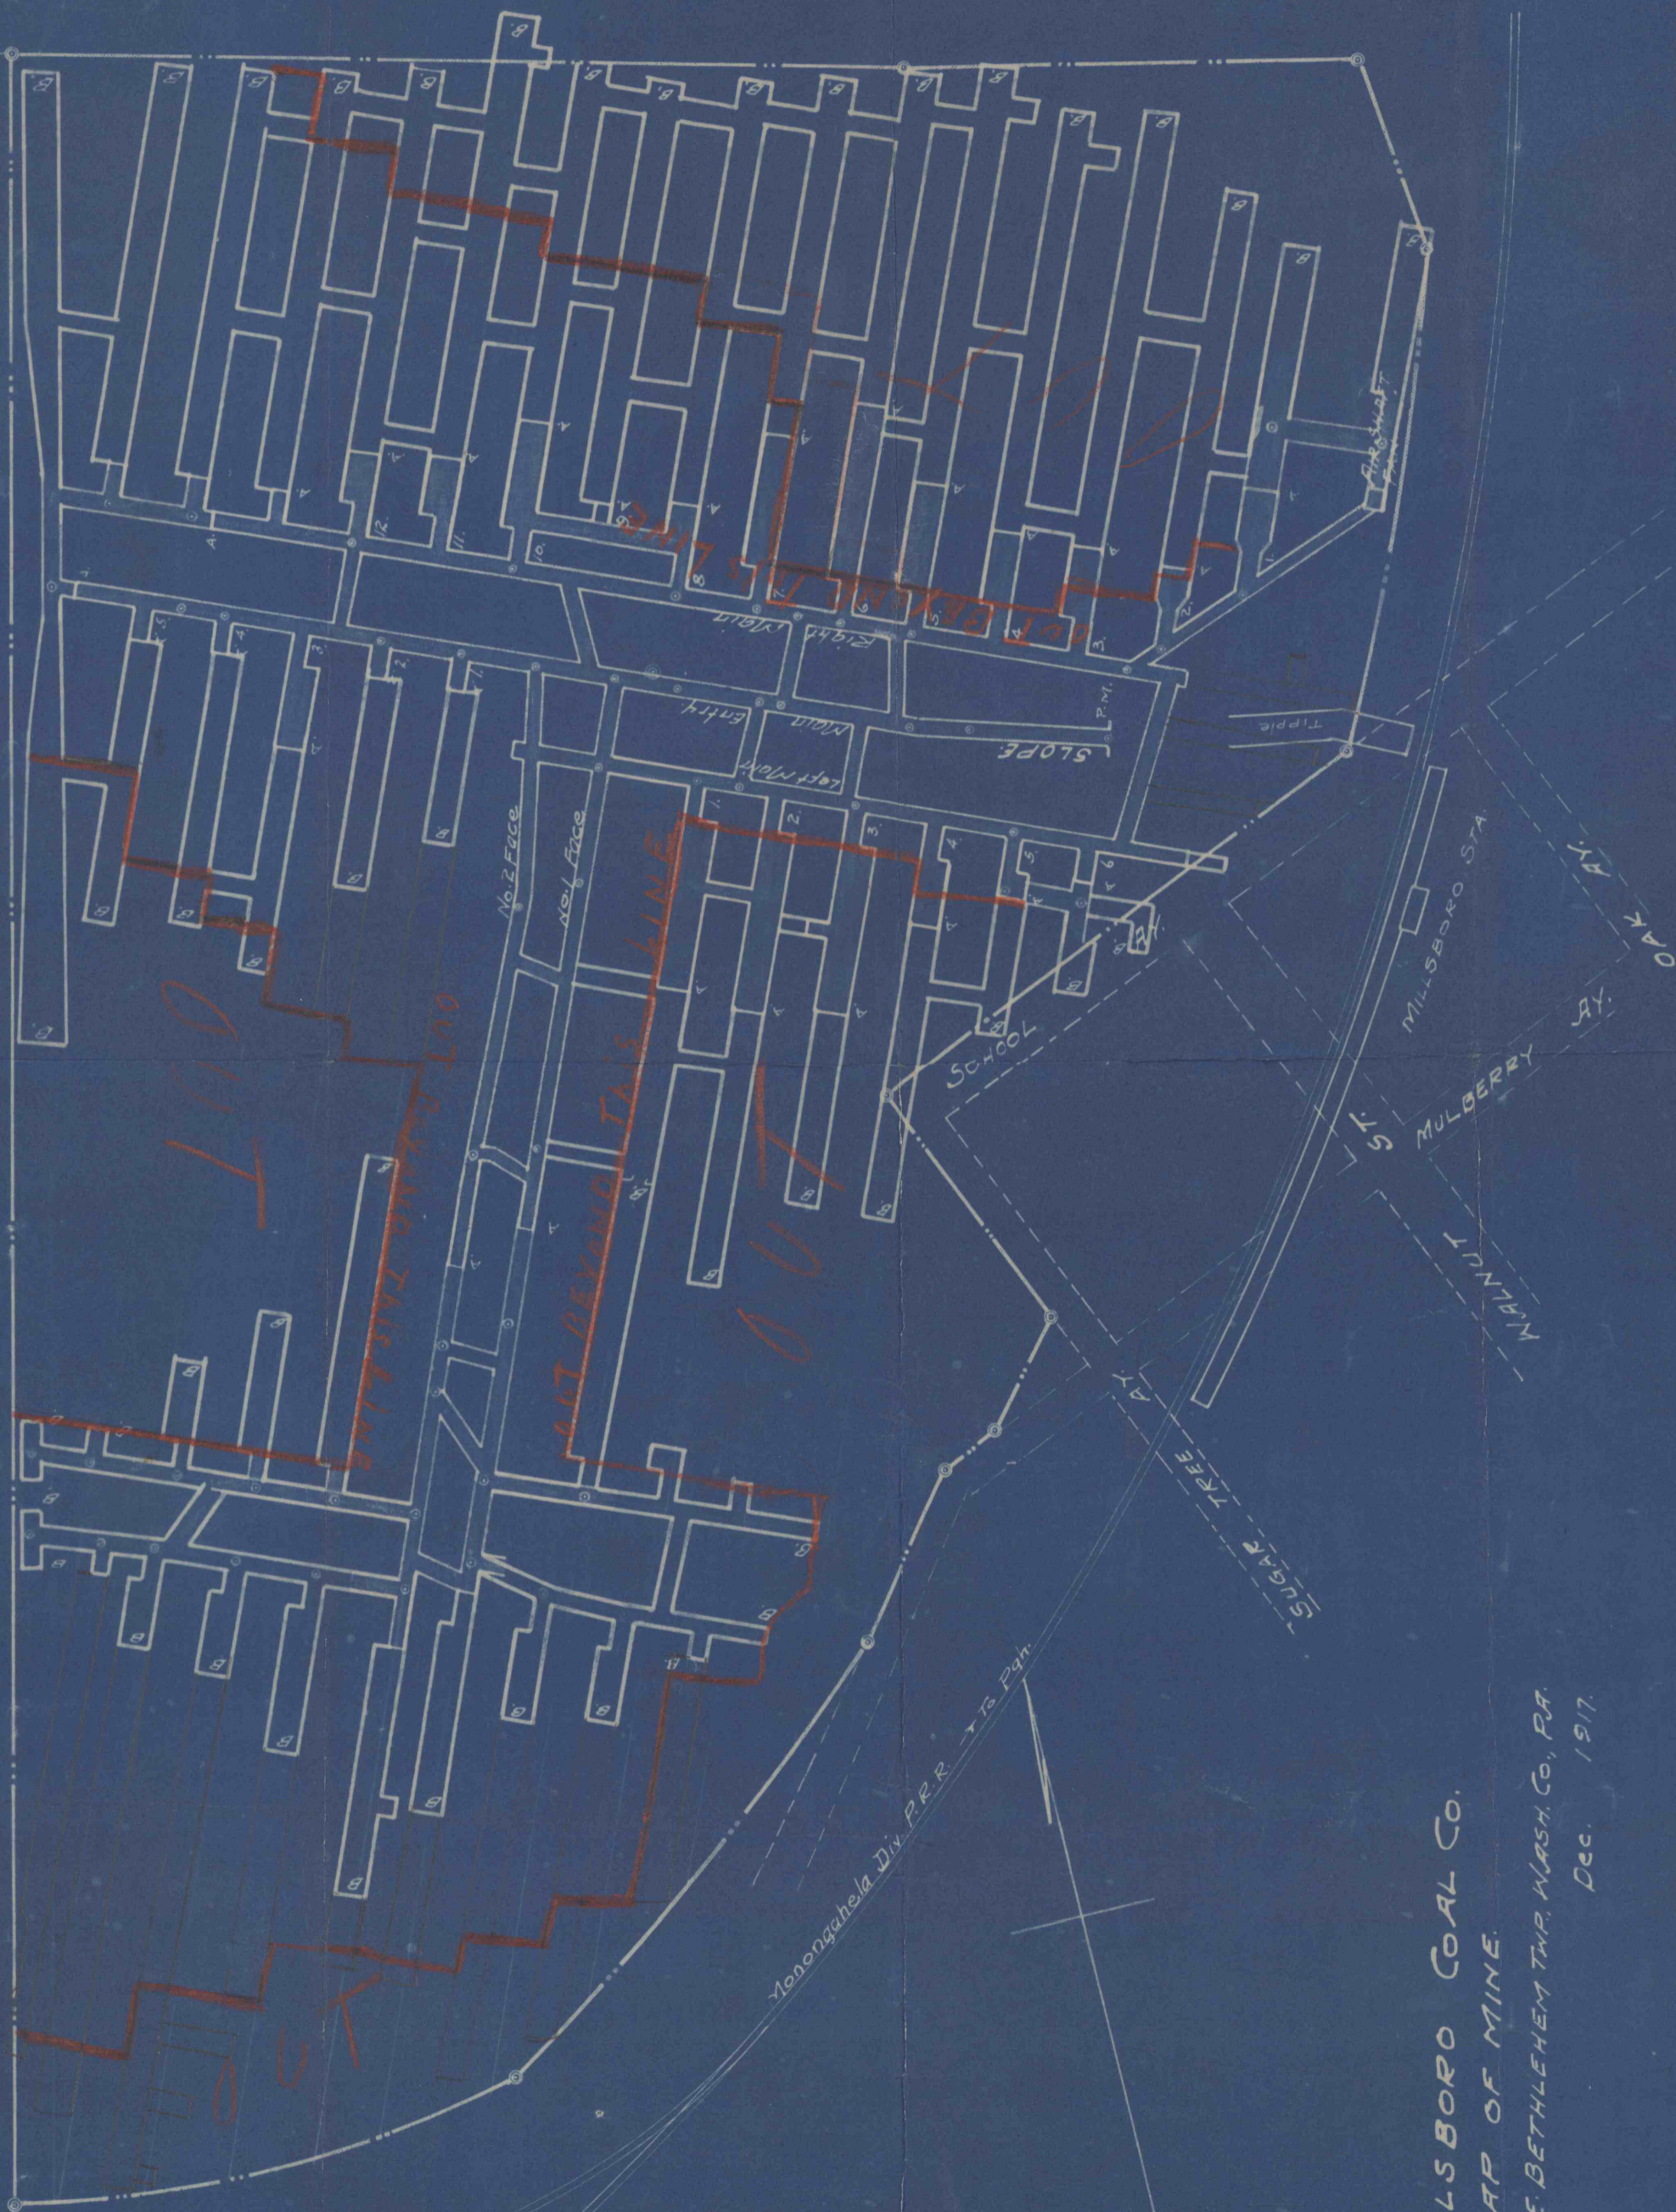

DATE OF SURVEY  
 Dec. 19, 1917 = A.  
 Oct. 15, 1918 = B.

MILLSBORO COAL CO.  
 MAP OF MINE.

SITUATE IN E. BETHLEHEM TWP., WASH. CO., PA.  
 Scale 1" = 100'

Dec. 1917.

L. G. MOSLENER, BROWNSVILLE, PA.

Millsboro Coal & Coke Co.  
 Millsboro, Pa.

1918  
 10/15