


MATCH LINE SHEET ONE

INDIANA COUNTY - WEST MAHONING TWP.
JEFFERSON COUNTY - PORTER TWP.

LEGEND
 - - - - - AREA TO BE MINED TO 4/1/63
 ——— ENTRIES
 ——— PROTECTED STRUCTURE
 ■ SUPPORT AREA
 □ MINING COMPLETED

RECEIVED
 OCT 8 1958
 PENNSYLVANIA DEPT. OF MINES
 STATE SUBSIDENCE DIVISION

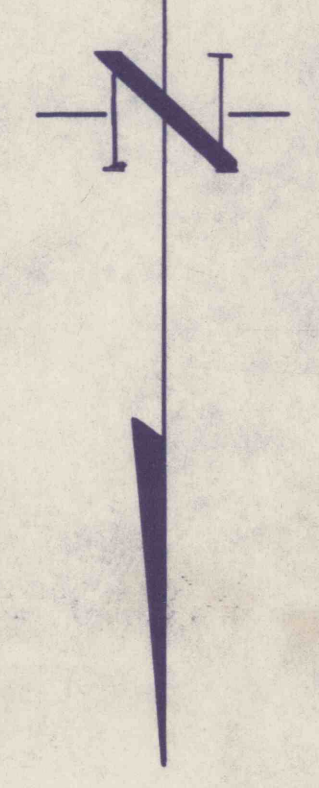

Jack W. Hubbard
 10-22-68

MINE MAP
MILTON No. 1 MINE
FREEDOM MINING CO., INC.
PORTER TWP. JEFFERSON CO.
PENNSYLVANIA

scale 1"=100'

#101
 12-17-59
 26