


#1819
C.S.
12-17-99

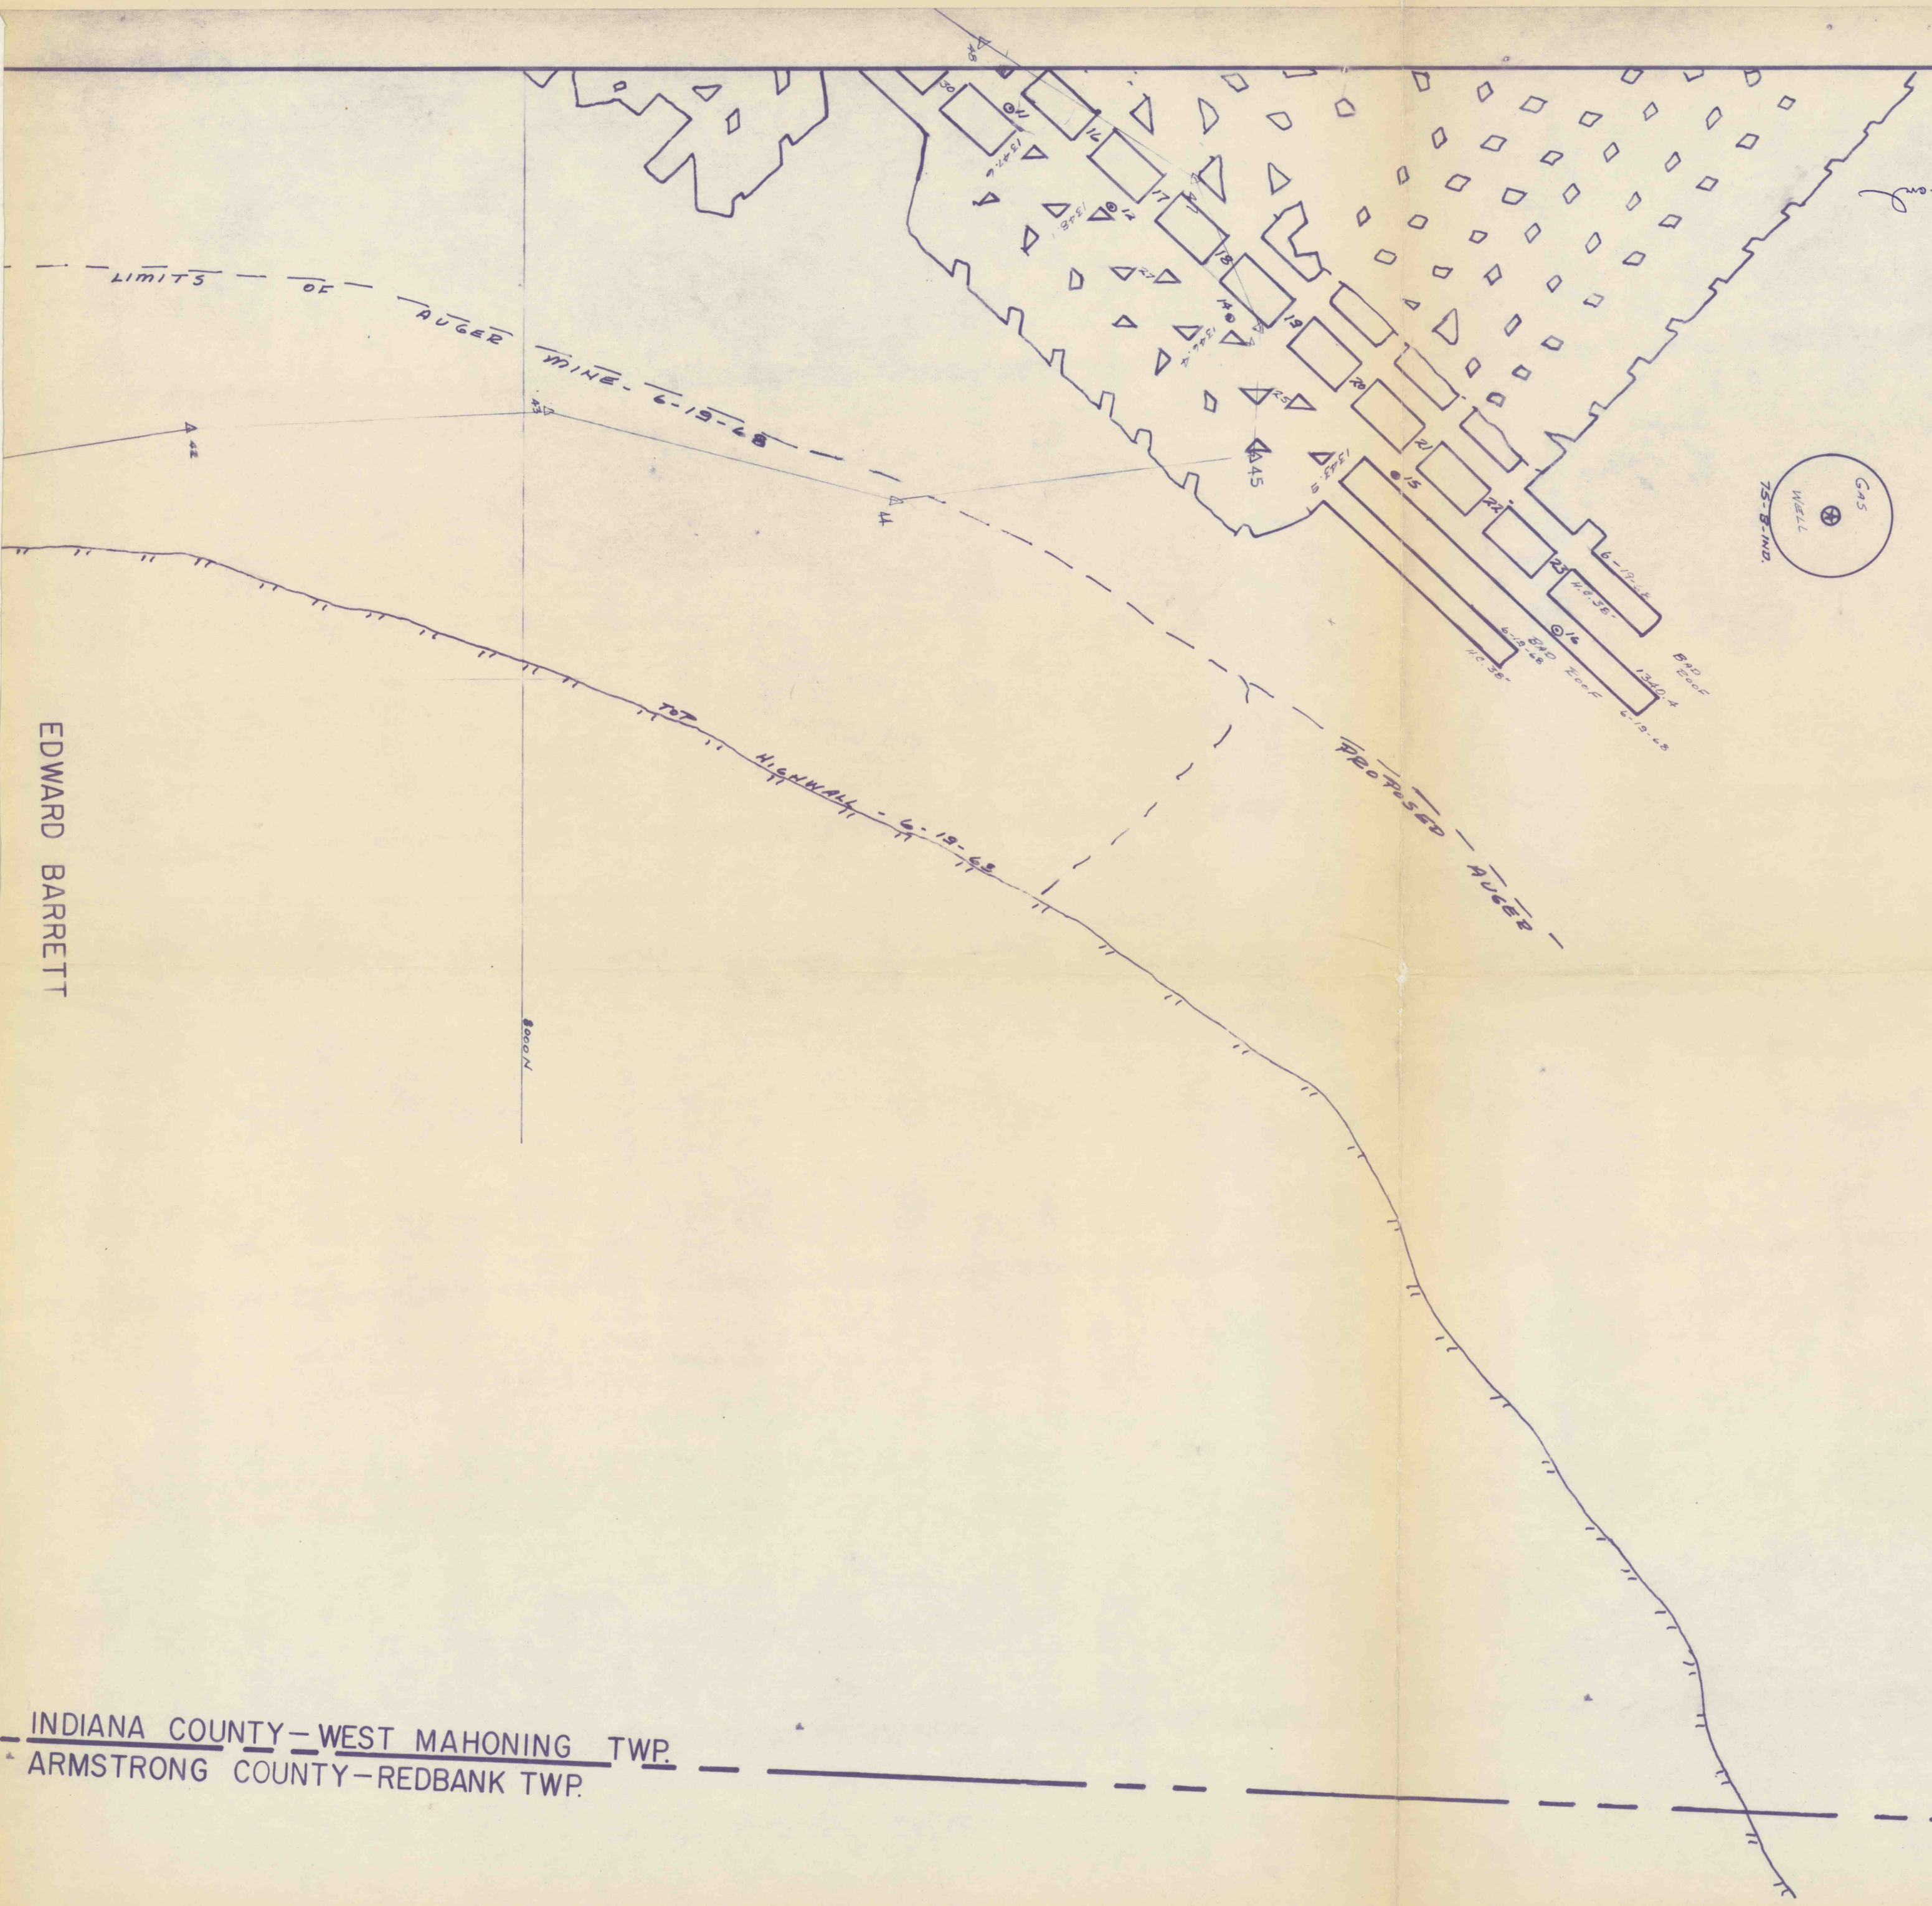

EDWARD BARRETT

INDIANA COUNTY - WEST MAHONING TWP.
ARMSTRONG COUNTY - REDBANK TWP.

