


N

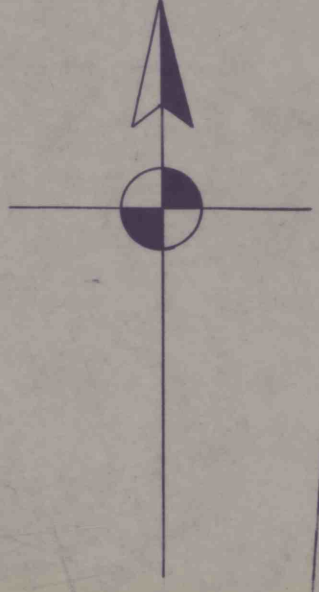

BOOZER

EDWARD HINDERLITER

M. D. HARTMAN

JOHN D. MINICH

ARMSTRONG CO.  
JEFFERSON CO.



LIMITS OF MINE

MINE MAP of "MINICH No. 1 MINE"  
FREEDOM MINING COMPANY  
RINGGOLD TWP, JEFFERSON CO.  
PENNSYLVANIA scale 1"=100'  
May 1, 1967  
MINING COMPLETED 9/14/67

*Carl W. Fullen*  
10-16-67

