


PITTSBURGH COAL CO.

HENDERSON COAL CO.

Note:-  
X Added to Survey Letter  
Indicates Area Mined By  
Others Or Not Recoverable  
and Charged Off on that  
Date.

SURVEY LETTER	DATE OF SURVEY
AB	Dec. 30, 1926
AC	June 29, 1927
AD	Dec. 17, 1927
AE	June 22, 1928
AF	Dec. 27, 1928
AG	June 26, 1929
AH	Dec. 23, 1929
AI	June 28, 1930
AJ	Dec. 24, 1930
AK	June 25, 1931
AL	Dec. 25, 1931
AM	June 26, 1932
AN	Dec. 26, 1932
BFX	June 18, 1940

ROBINSON & SMITH  
(FORMERLY DEEDLE & WILSON)

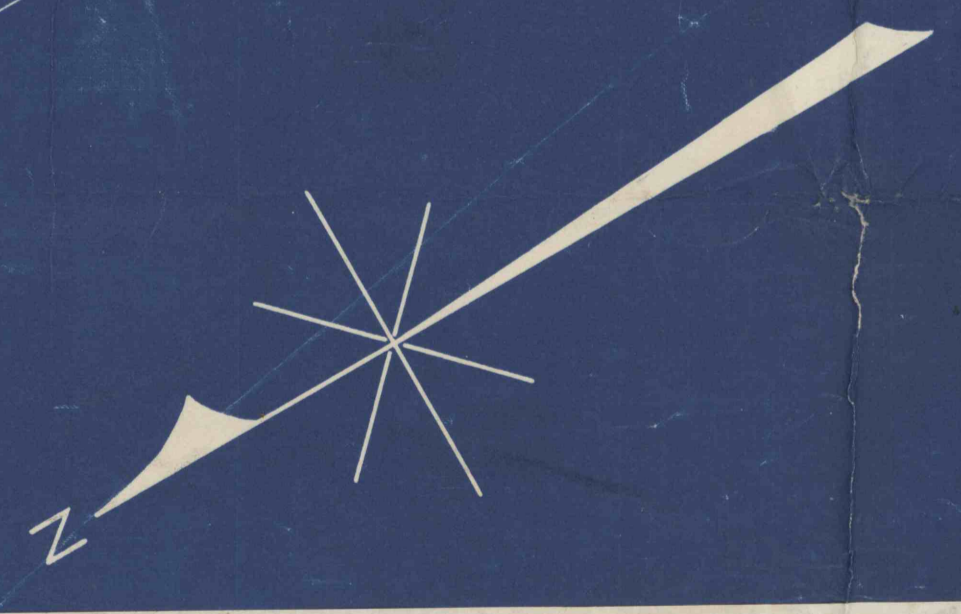

HILLMAN GAS COAL COMPANY

GRANT BUILDING  
PITTSBURGH, PA.

October 7, 1940.

In accordance with Section 6 of Article II of the Pennsylvania Bituminous Mining Law, No. 1, of 1902, I, Affiant, Vice President of the Hillman Gas Coal Company of Pittsburgh, Penn., do hereby certify as follows:

1. That the Hillman Gas Coal Company operated the Monessen Mine of the Pittsburgh Steel Company as Lessee.

2. That the Monessen Mine, which is located in Rostraver Township, Westmoreland County, Pennsylvania, was exhausted as of July 18, 1940, which was the date the last coal was shipped. The pit south has been covered and the surface plant is now being dismantled.

3. That the 100' scale blue print of the Monessen Mine map, to which this certificate is made a part thereof, is a true and correct copy of the mine map and shows the excavations made and the mine workings in the Pittsburgh seam as of July 18, 1940.

HILLMAN GAS COAL COMPANY  
*W. H. Hillman*  
Vice President

Commonwealth of Pennsylvania )  
County of Allegheny )

Sworn to and subscribed before me this 8th day of October, 1940.

*W. H. Hillman*  
Notary Public  
No. 10, District of Allegheny  
NY COMMISSION EXPIRES  
APRIL 14, 1943

MONESSEN COAL AND COKE CO.  
ALLEGANY, PA.

SUBJECT MINE MAP

FOR MONESSEN MINE  
ROSTRAYER TOWNSHIP,  
WESTMORELAND COUNTY, PA.

SCALE 1" = 100'  
DRAWN BY M. A. A. DATE 8-1-1926  
CHECKED BY  
REVISED - SEE DATA CHART

DATE PRINTED DRAWING NUMBER  
12299

SHEET NO. 2 OF 3 SHEETS  
DRAWER NO. 43

MONONGAHELA RIVER

MINED OUT

MINED OUT

MINED OUT

MINED OUT

MINED OUT

MINED OUT

MINED OUT

MINED OUT

MINED OUT