

WINGHAM

14-Rt.

14-Lt.

14-Rt.

14-Lt.

15-Rt.

15-Lt.

15-Rt.

15-Lt.

16-Rt.

16-Lt.

16-Rt.

16-Lt.

17-Rt.


17-Lt.

17-Rt.

17-Lt.

WINDIP

gas leaks  
thru a small door  
17' high from boiler  
on intake air

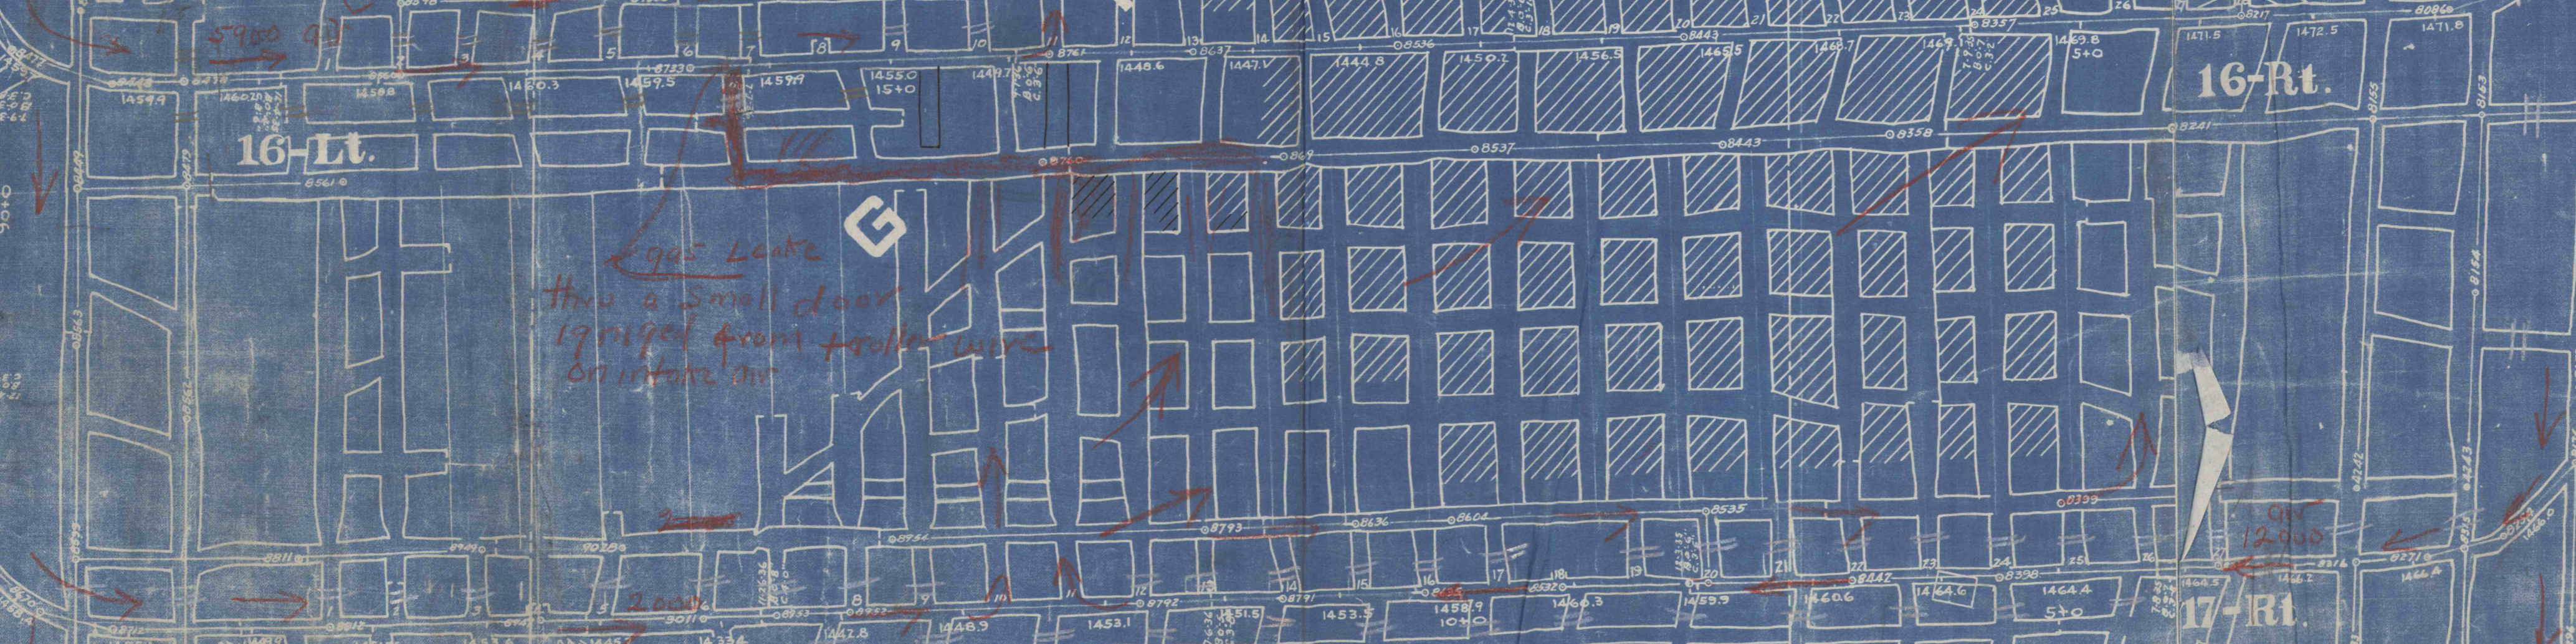

G

12000

2000

