


JOHN MILLER  
5971 Ac  
P.C. TO P.G.C.O.

J. D. WALL  
4.662 Ac  
9.740  
13.501 Ac Total Coal  
35.697 Ac Surf

FRANK SEBOLT  
16.00 Ac

HOLMES HARGER

UNMINED COAL OF THE PITTSBURGH VEIN  
CONVEYED BY THE P.C. TO CARL W. BENTZEL  
DEED 123-59

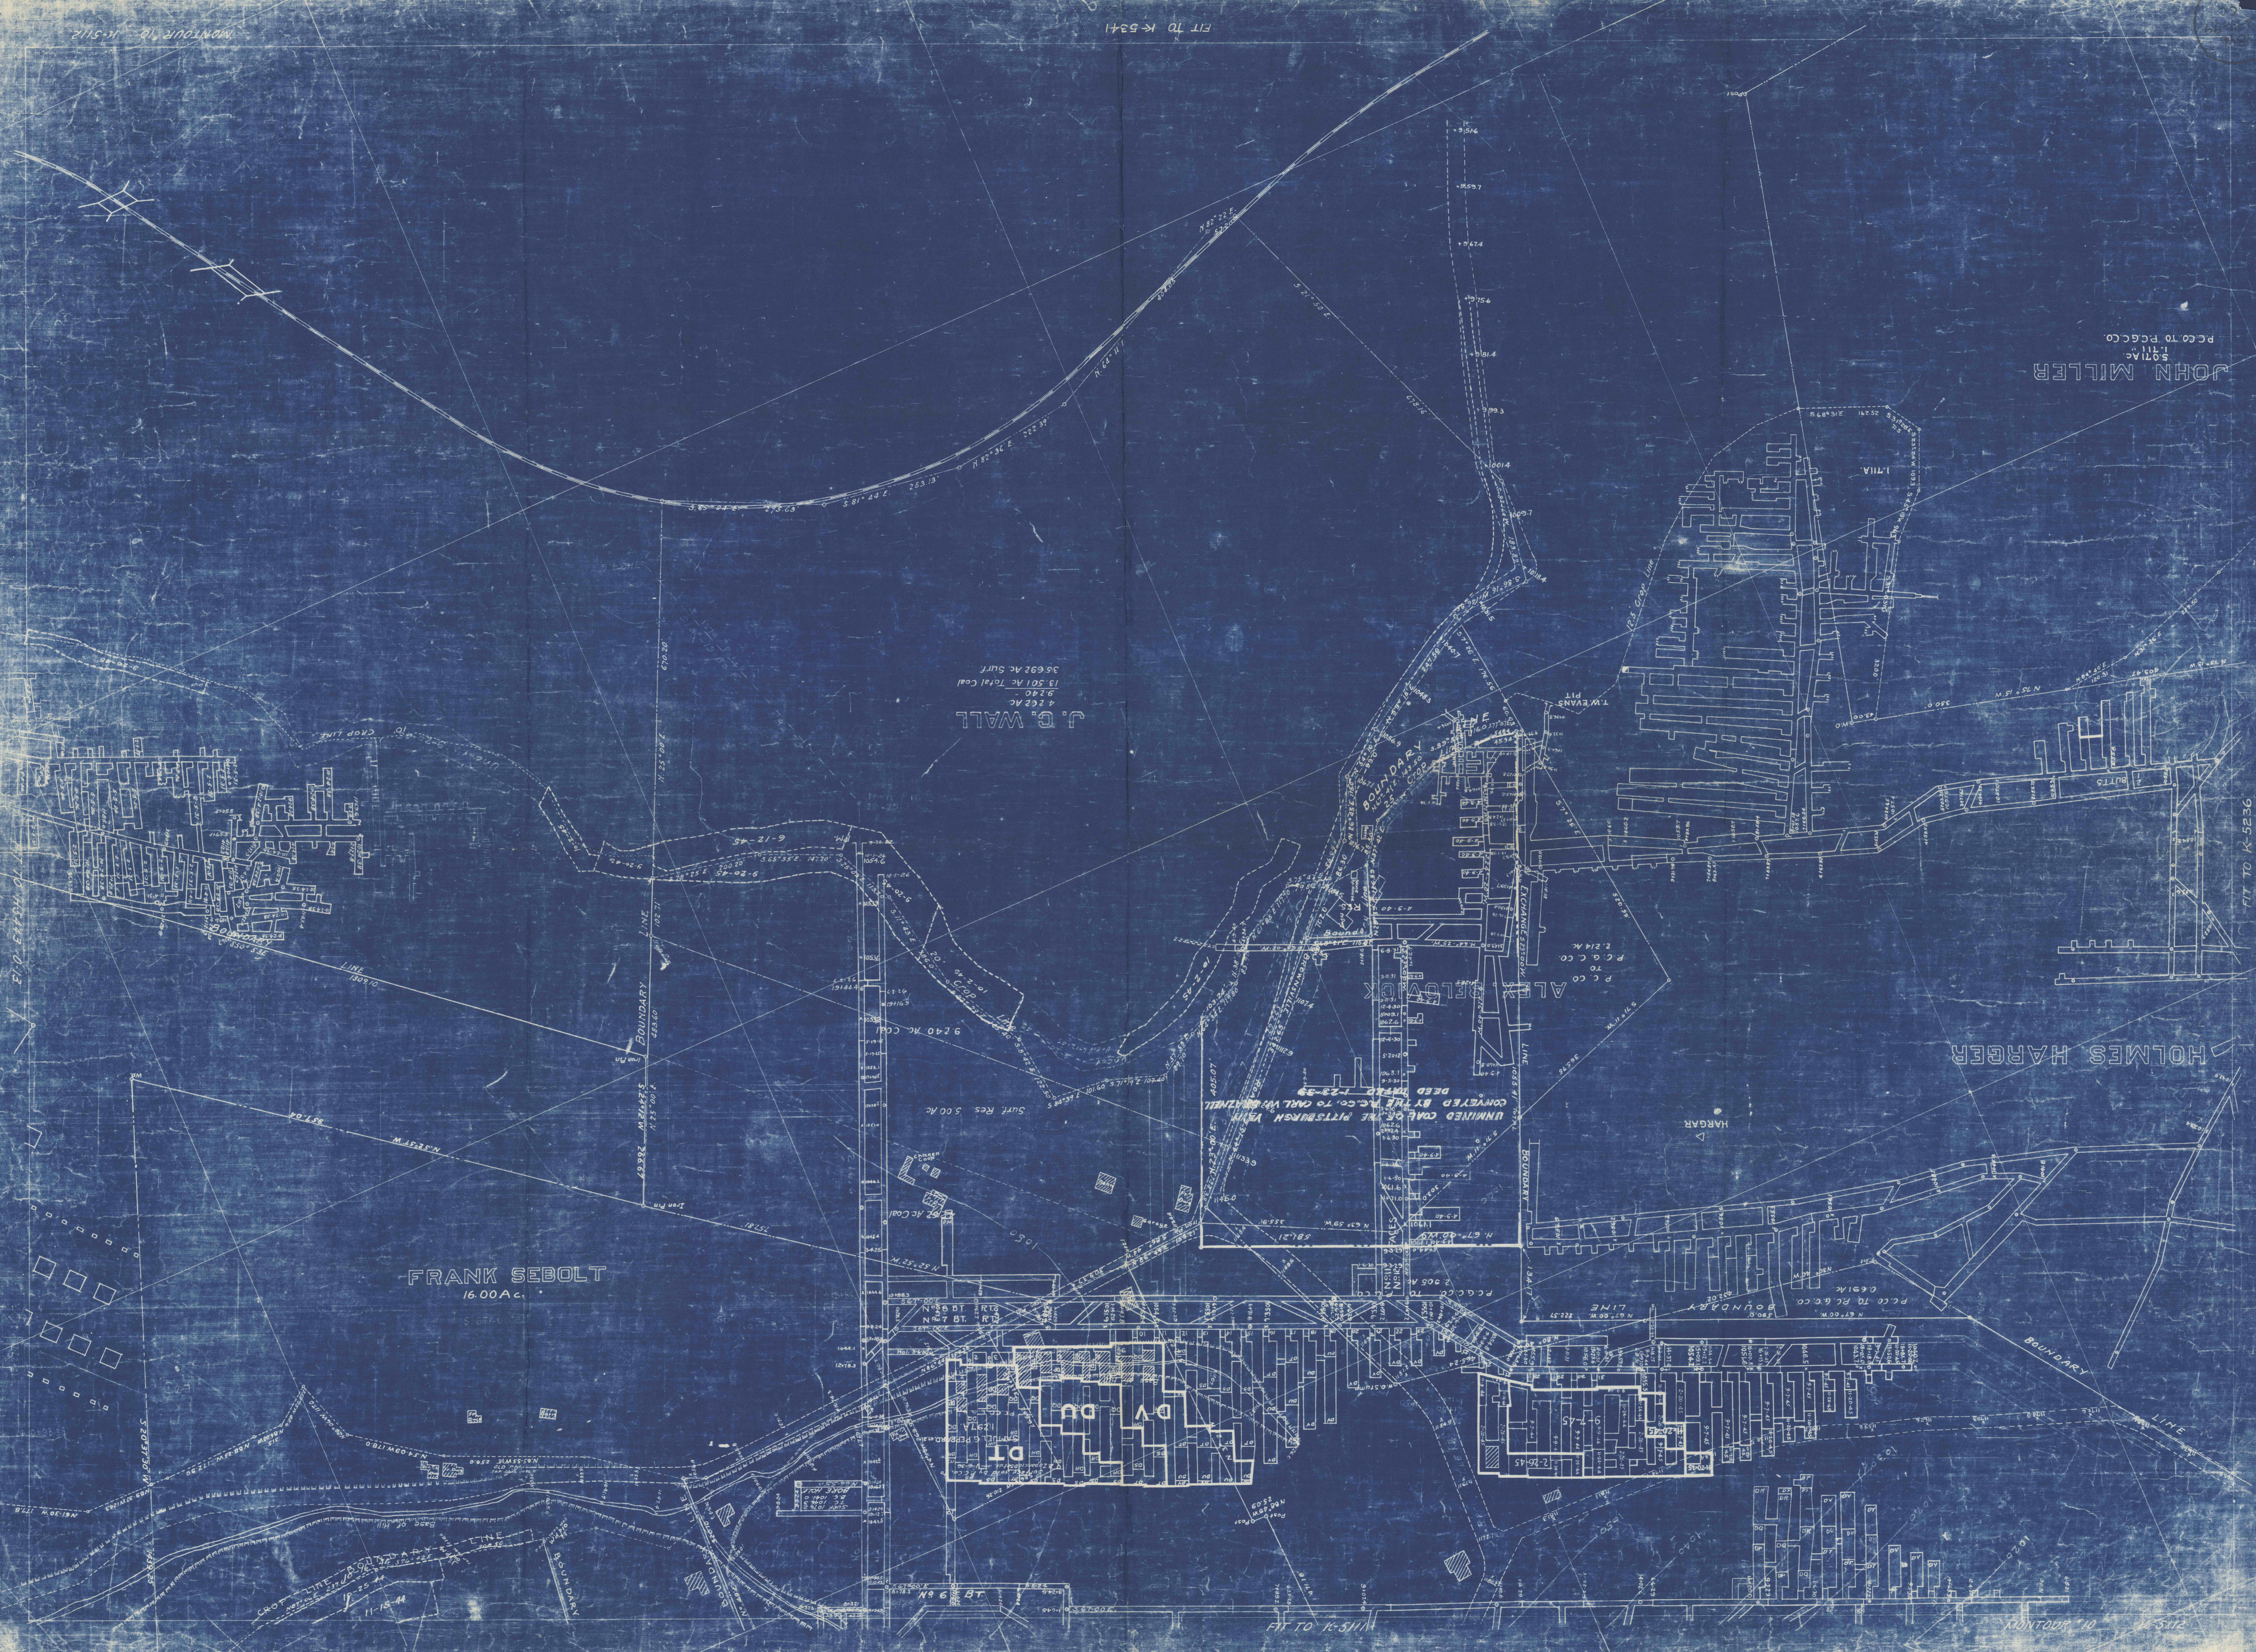

Fit to K-5112

Fit to K-5236