


27-1956
Beccaria Twp.

NO 3 MINE, CLEARFIELD CO.
DEEP MINE WORKINGS OF
MOSHANNON, SMITHING NO 3 MINE
1"=100 JULY 15, 1958

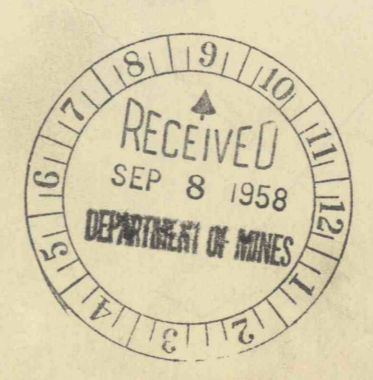

#1873
12-20-99
CC