


ONLY ONE LIFT MAY BE MINED ON EACH BLOCK AS PROJECTED. MINE MANAGEMENT MAY CHANGE THE DIRECTION OF LIFTS WHEN ABNORMAL CONDITIONS OCCUR. NOT MORE THAN THREE LIFTS MAY BE MINED IN THE SAME DIRECTION ON ADJACENT BLOCKS.

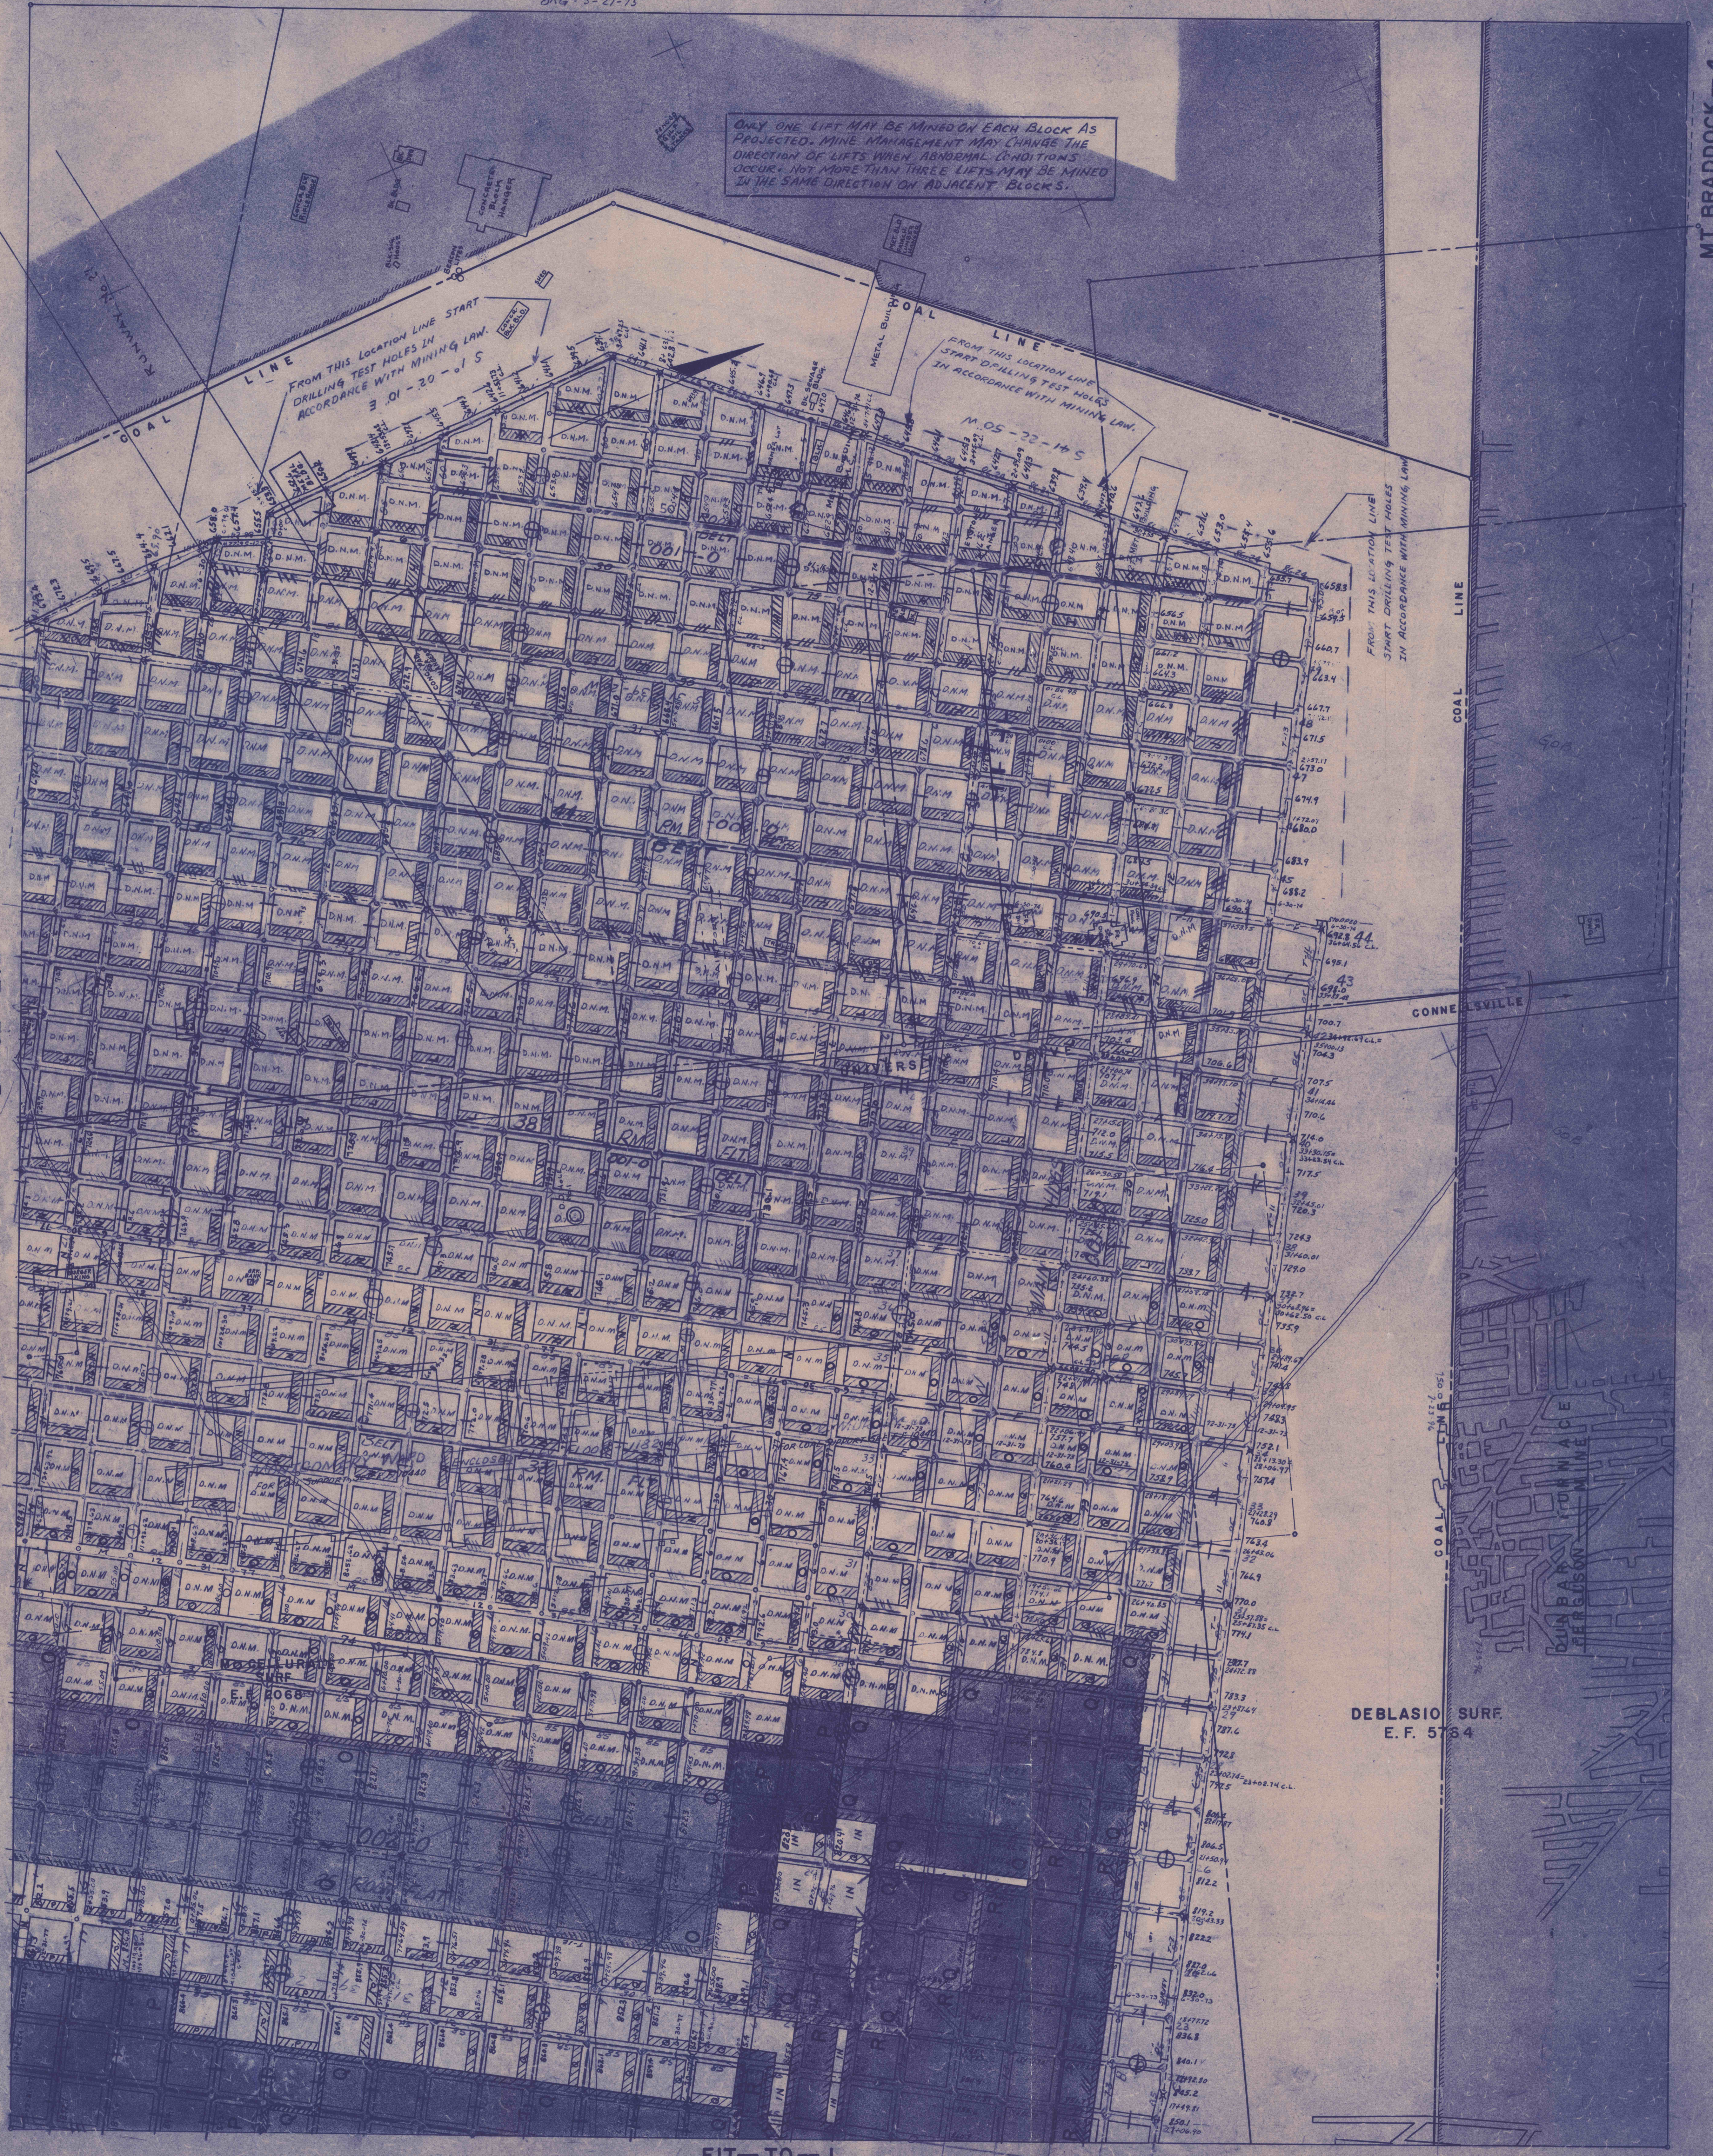

FIT-TO-3

FIT-TO-1

DEBLASIO SURF  
E.F. 5764

CONNELLSVILLE

COAL LINE

DEBBY  
FERGUSON  
TOM WACE