


ONLY ONE LIFT MAY BE MINED ON EACH BLOCK AS PROJECTED. MINE MANAGEMENT MAY CHANGE THE DIRECTION OF LIFTS WHEN ABNORMAL CONDITIONS OCCUR. NOT MORE THAN THREE LIFTS MAY BE MINED IN THE SAME DIRECTION ON ADJACENT BLOCKS.

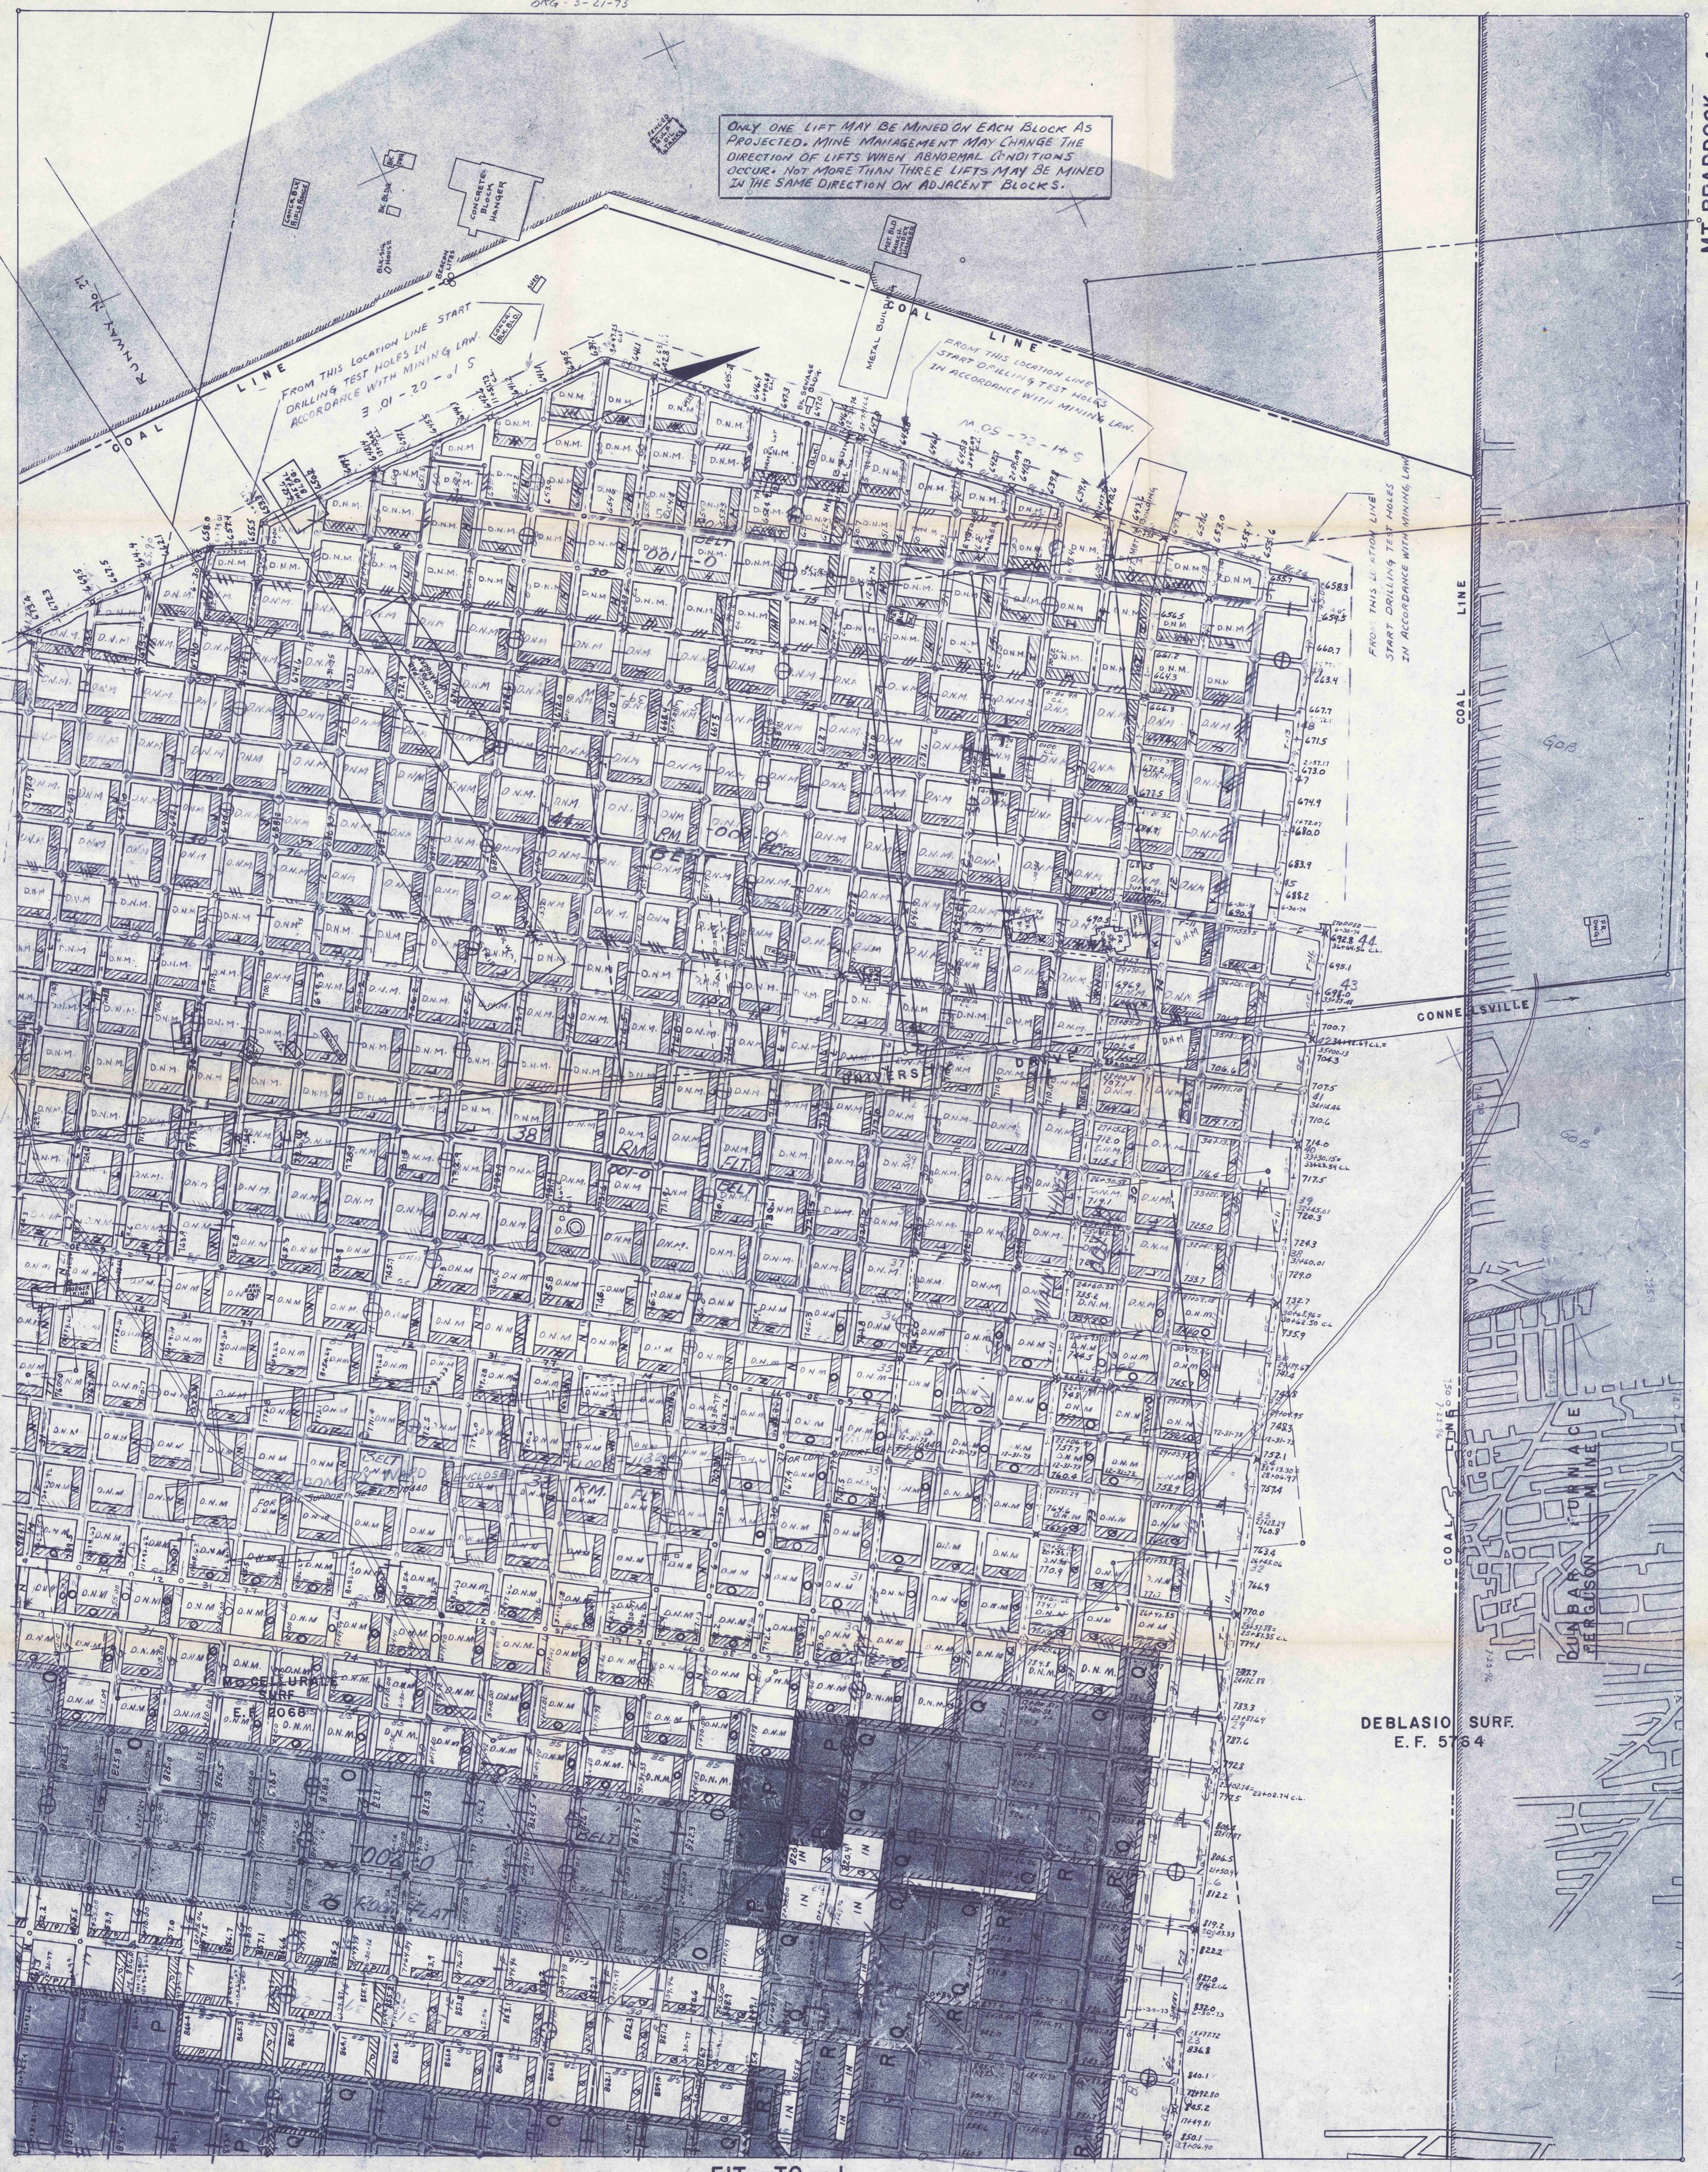

FIT-10-3

FIT-10-1