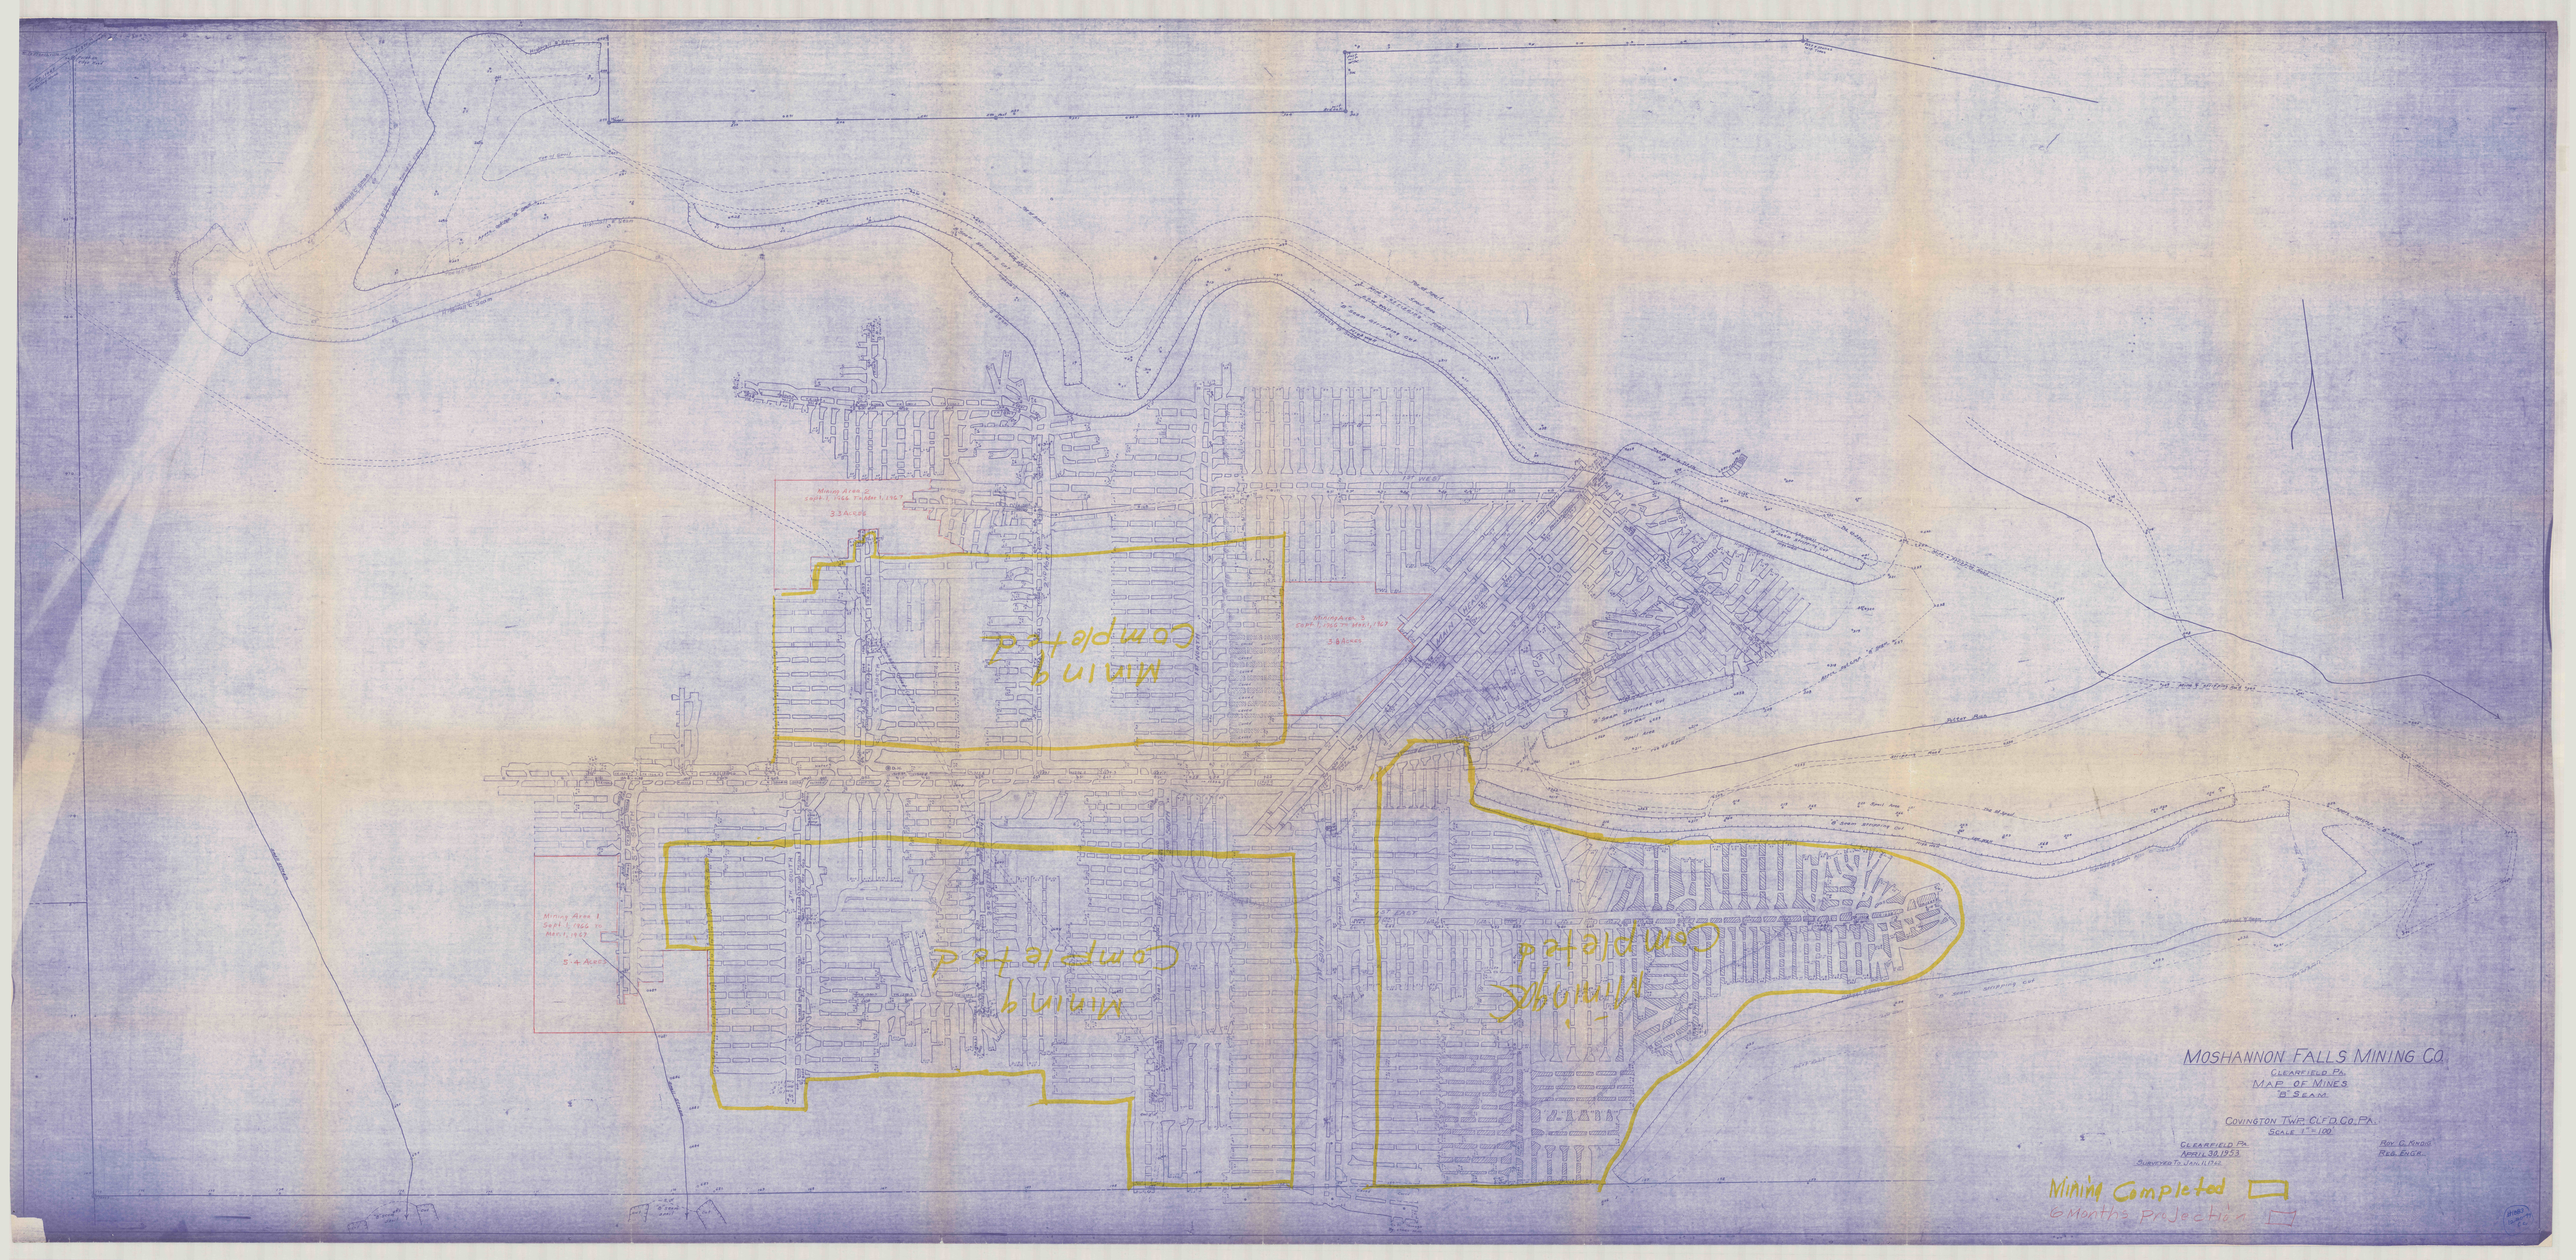

Mining Area 2
Sept 1, 1966 To Date
3.3 Acres
Mining Area 3
Sept 1, 1965 To April 1, 1967
5.8 Acres
Mining Area 1
Sept 1, 1962 To March 1, 1967
5.4 Acres
Mining Completed
Mining Completed
Mining Completed
Mining Completed
MOSHANNON FALLS MINING CO.
CLEARFIELD PA.
MAP OF MINES
"B" SEAM
COVINGTON TWP. CLF'D CO. PA.
SCALE 1" = 100'
CLEARFIELD PA.
APRIL 30, 1953
SURVEYED TO JAN. 1, 1962
ROY C. MORRIS
REG. ENGR.
Mining Completed
6 Months Projection