


TO CLEARFIELD
Mount Vernon Top
The Krupper Inspector
April 27th 1887

[Faint handwritten notes]

Deuling Estate

Kittanning Coal Co.

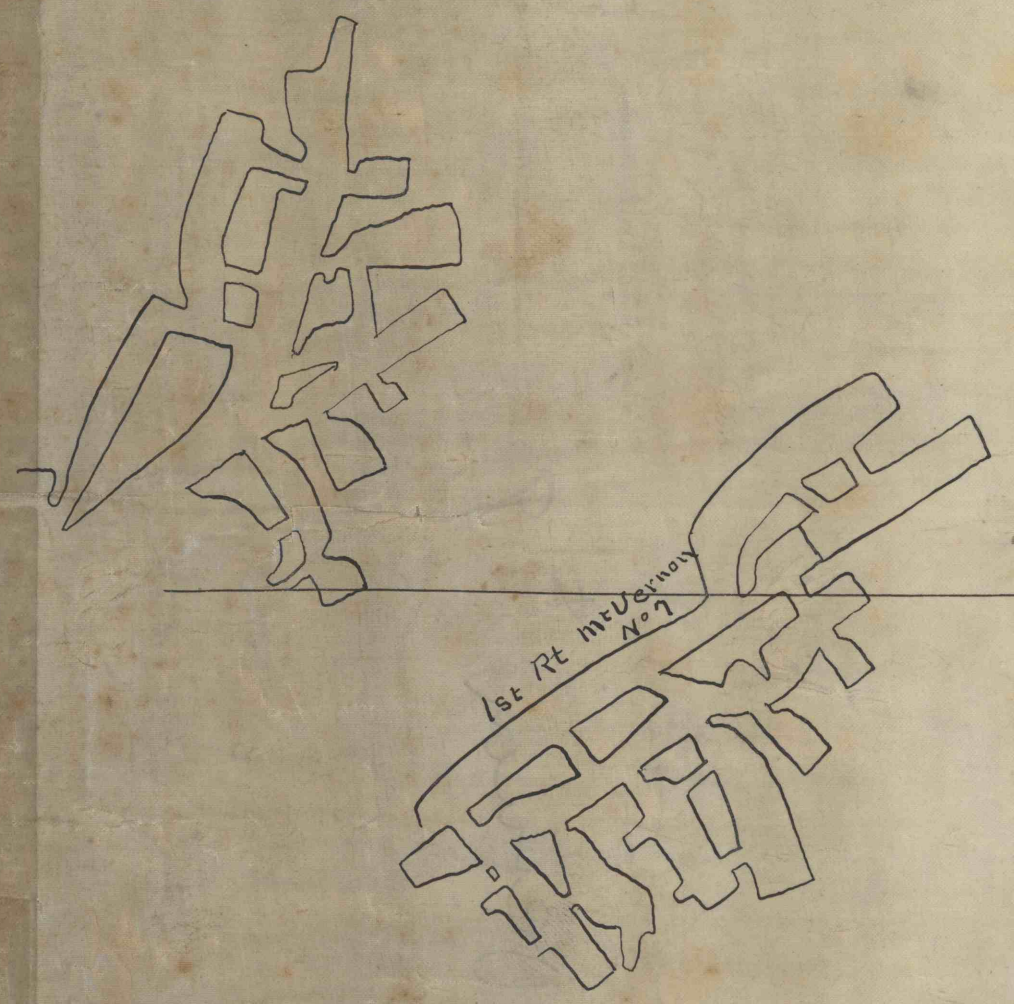

XALIA

S.D. Robeson.

PLAN
OF
M^TVERNON N^o 9 COLLIERY
SITUATED IN
CLEARFIELD CO PENNA
OPERATED BY
THE UNITED COLLIERIES C^o

EUREKA N^o 23

Scale 1" = 100 Ft

Chas. B. Maxwell, M.E.

#1887
12-20-11
66