

DELANEY No 5

G. J. MYERS
25+ ACRES

ABANDONED SURFACE

MINED OUT FIRST MINING

MINED OUT FIRST MINING

MINED OUT FIRST MINING

RESERVE

4TH LEFT

MINED OUT FIRST MINING


THIS MINE WORKED
1900 TO 1920

KENNER LEASE
35 ACRES
55% MINED OUT
FIRST MINING

MINED OUT FIRST MINING

BLUE - FEE
RED - LEASE
BLACK - 6 MONTH PROJECT
BROWN - ABANDONED

MINE INACTIVE,
NO PRODUCTION
DURING PERIOD
NOV. 21, 1967

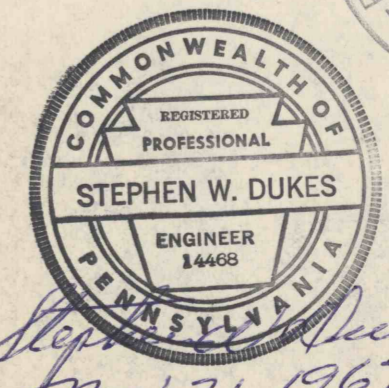

Stephen W. Duker
Nov. 21, 1967

PORTION OF
DELANEY No 5 MINE
AND
MYERS MINE
GALLITZIN TWP. CAMBRIA CO. PA.
SCALE 1" = 100' 12-12-62

REPRODUCED FROM OLD BLUEPRINT
AND SURVEYS OF MYERS MINE.

FIELD COPY
LEGO, JAMES

#1692
12-20-69