


Formerly WRAY

SURVEY OF MINE MADE FOR MYERS COAL CO.

Situate partly in North Huntingdon Twp. Westmoreland
Co. & partly in Versailles Twp. Allegheny Co. Pa.

Scale 1"=100'
July 1921
Jan. 1922
Aug. 1925

R.C. Bayne, Engineer.

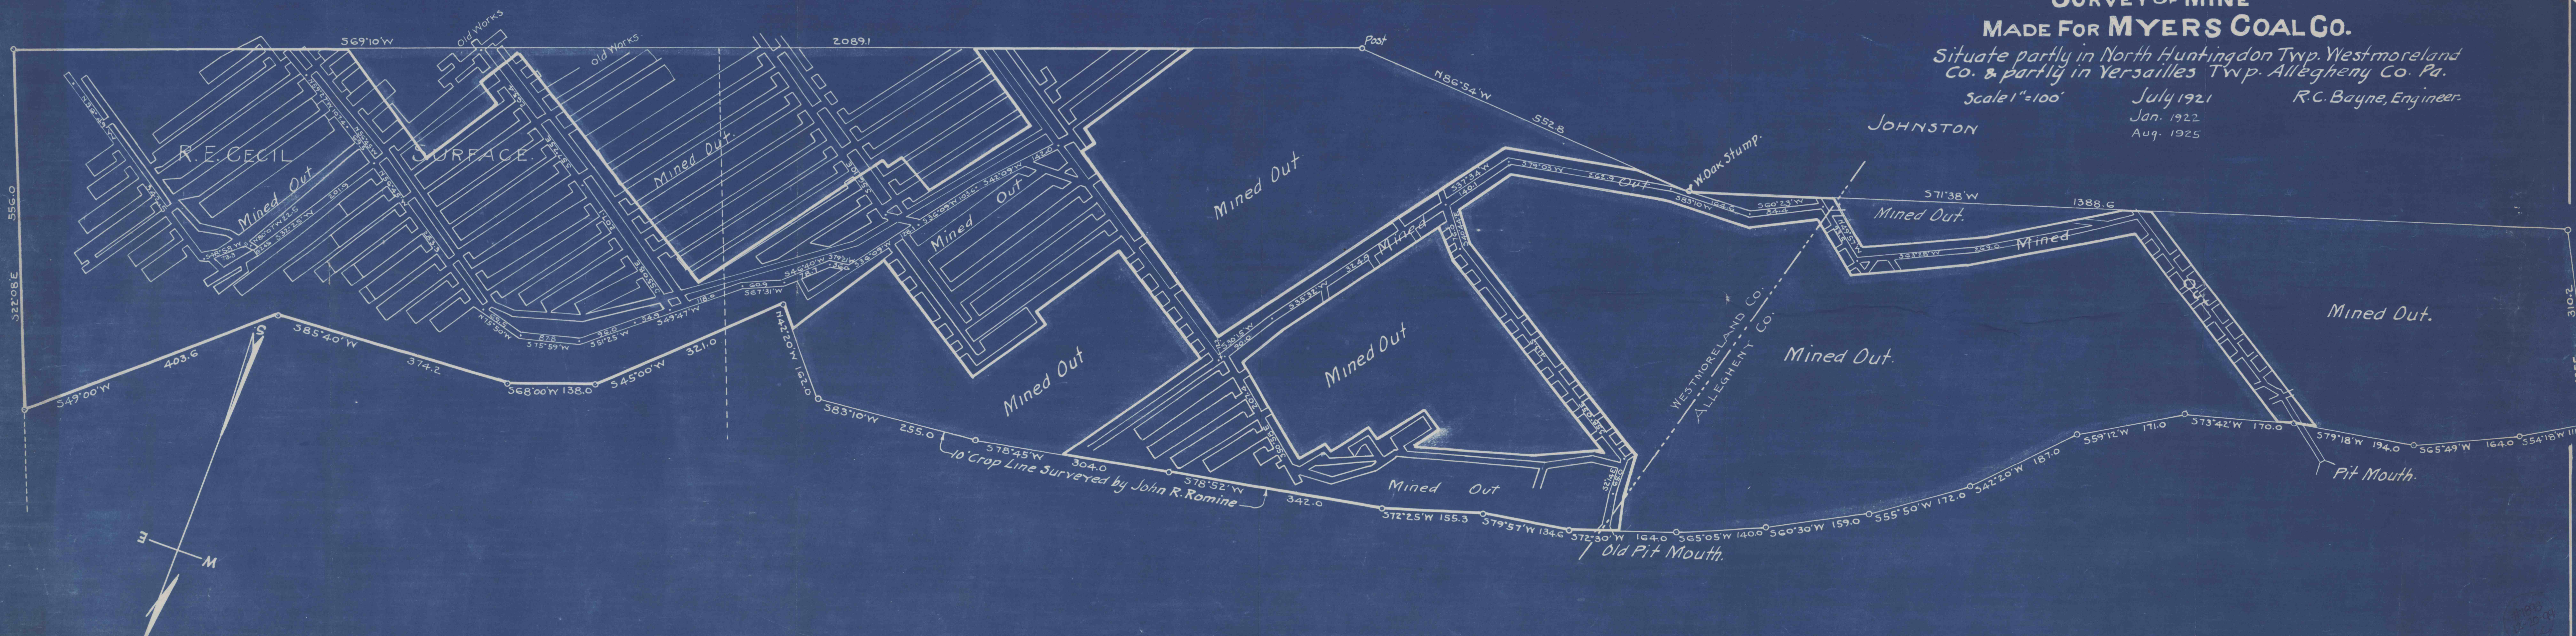

1185
12-20-21
R.C.