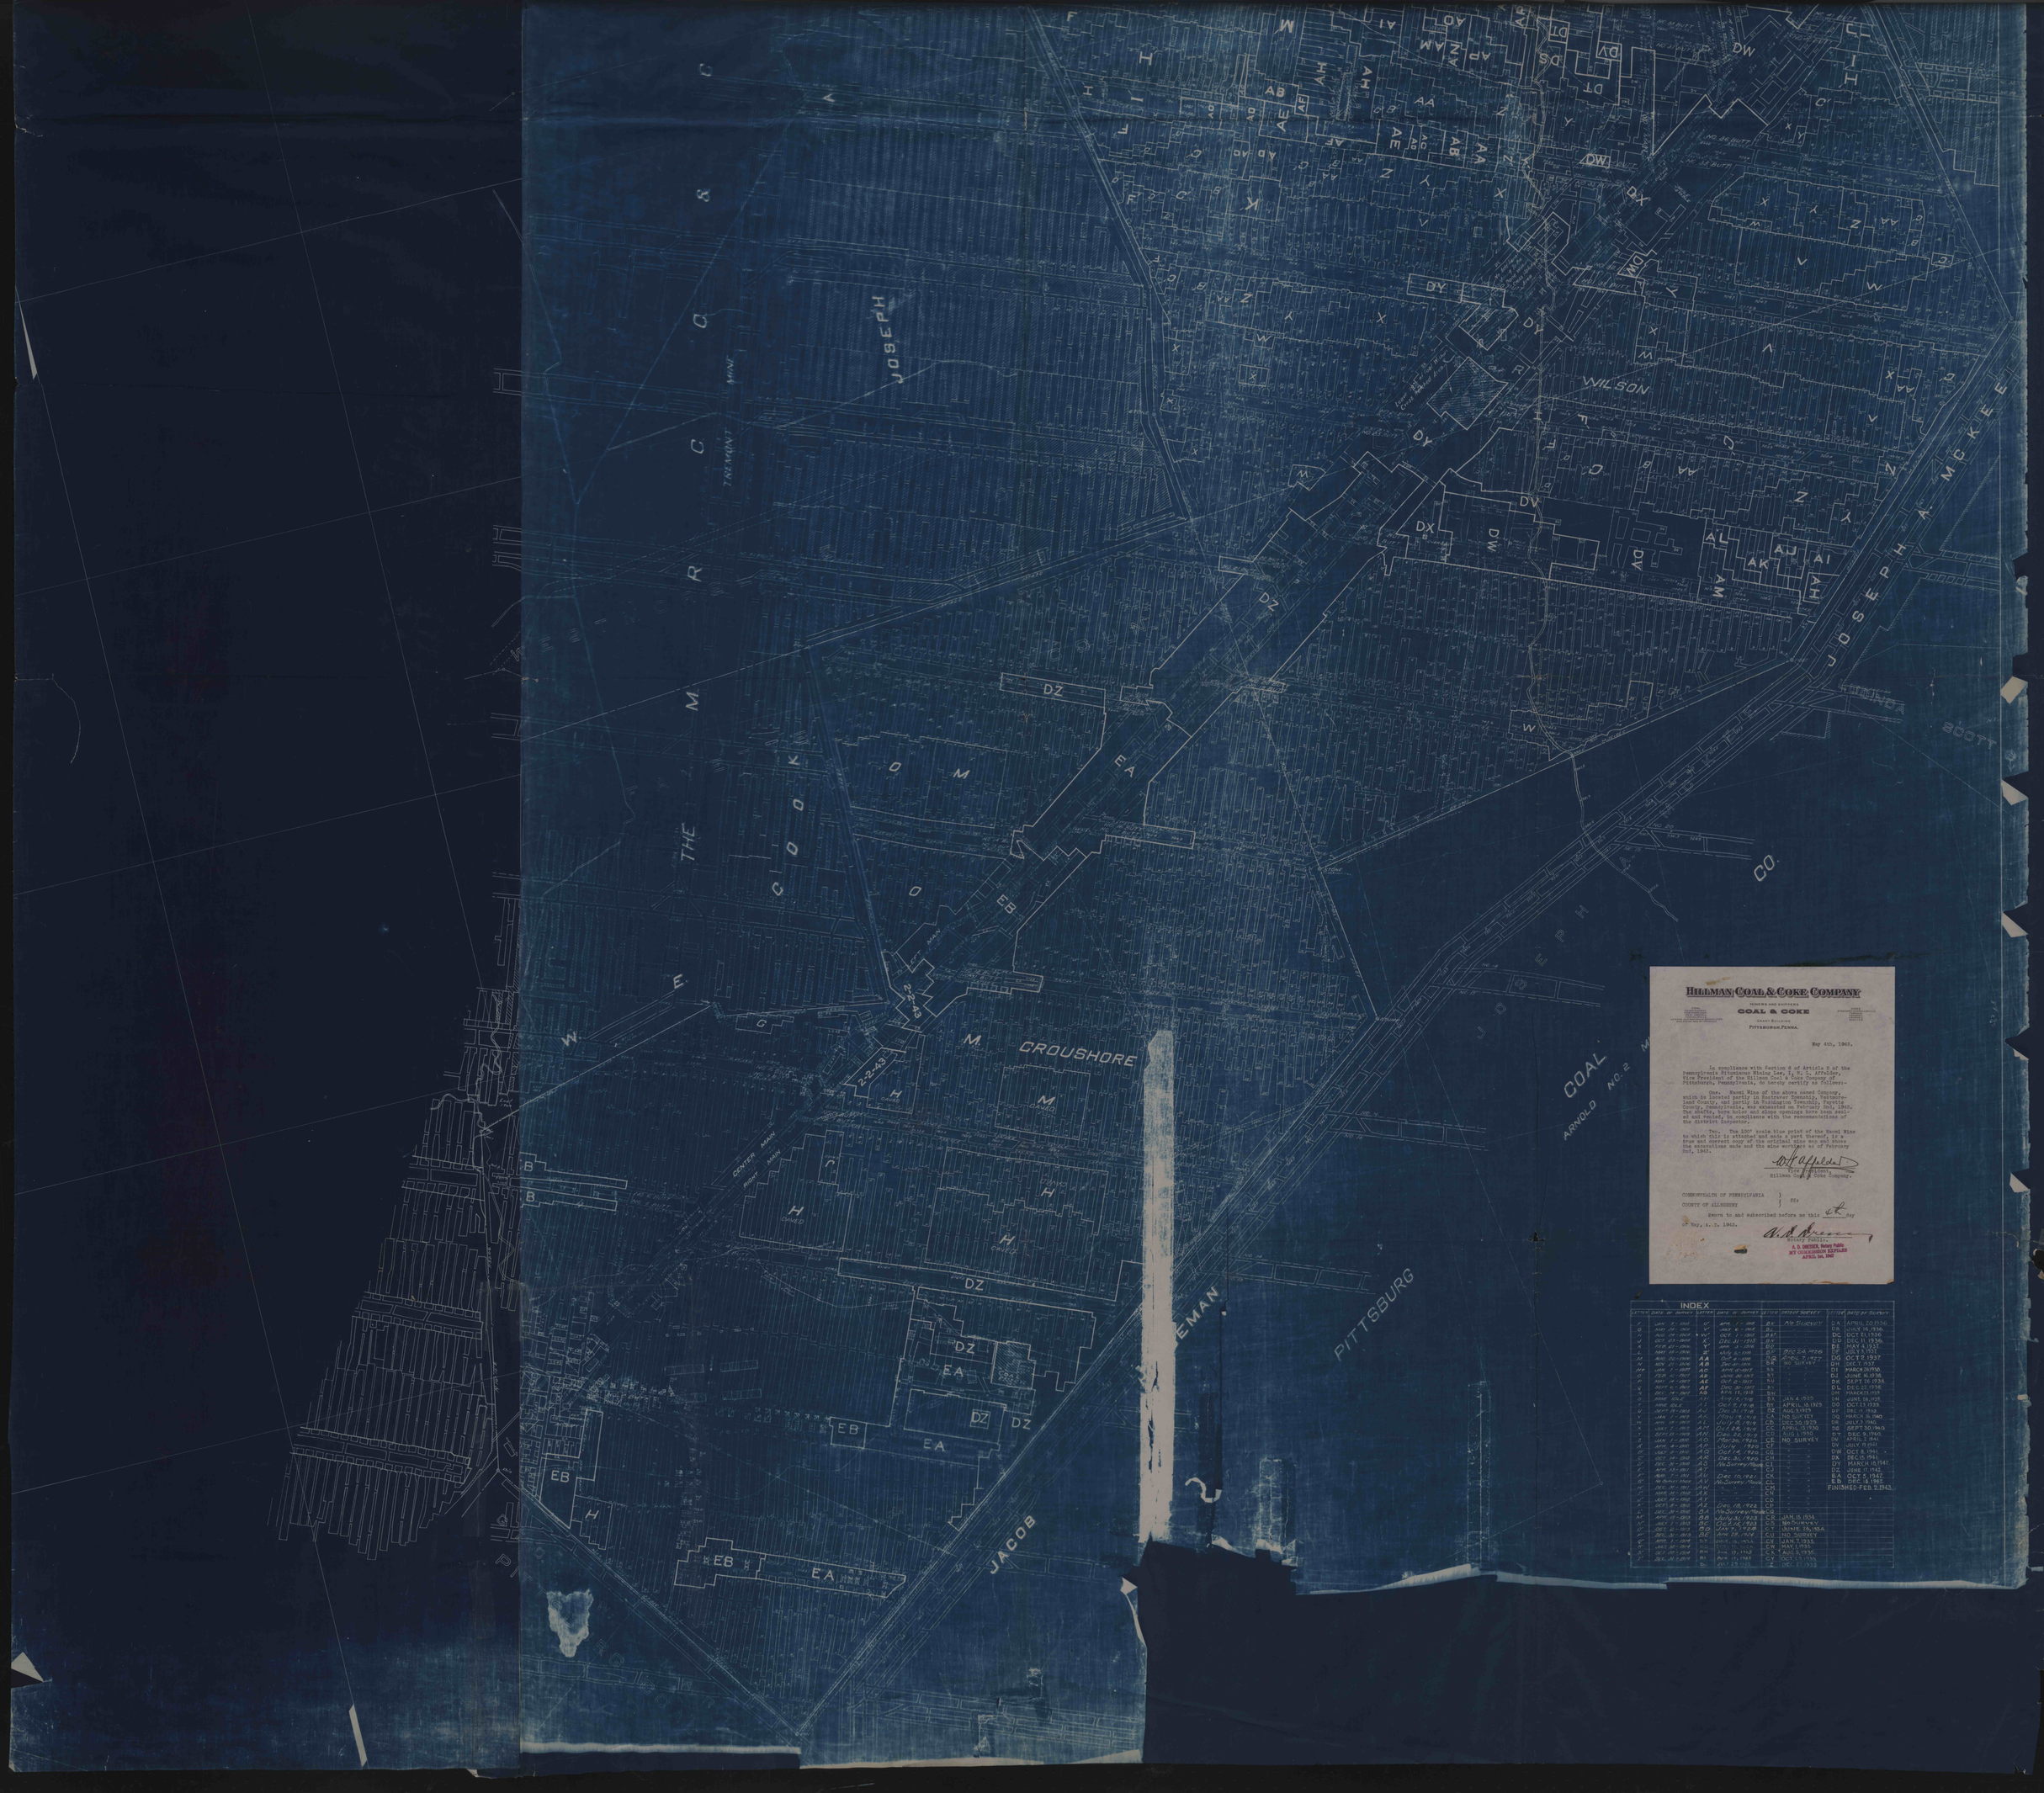


HILLMAN COAL & COKE COMPANY

OWNERS AND SHIPPERS

COAL & COKE

GRANT BUILDING

PITTSBURGH, PENNA.

May 4th, 1943.

In compliance with Section 6 of Article 5 of the Pennsylvania Bituminous Mining Law, A. D. Affolder, Vice President of the Hillman Coal & Coke Company of Pittsburgh, Pennsylvania, do hereby certify as follows:-

One. Vacant Mine of the above named Company, which is located partly in Scatraver Township, Westmoreland County, and partly in Washington Township, Fayette County, Pennsylvania, was abandoned on February 2nd, 1943. The shafts, bore holes and slope openings have been sealed and filled in accordance with the recommendations of the district inspector.

Two. The 100' scale blue print of the Vacant Mine to which this is attached and made a part thereof, is a true and correct copy of the original mine map and shows the excavations made and the mine workings as of February 2nd, 1943.

A. D. Affolder
Vice President,
Hillman Coal & Coke Company.

COMMONWEALTH OF PENNSYLVANIA )
) SS:
COUNTY OF ALLEGHENY )

Sworn to and subscribed before me this 4th day of May, A. D. 1943.

A. D. Dreher
Notary Public.

A. D. DREHER, Notary Public
MY COMMISSION EXPIRES
APRIL 1st, 1947

INDEX

| LETTER | DATE OF SURVEY | LETTER | DATE OF SURVEY | LETTER | ABSENT SURVEY | LETTER | DATE OF SURVEY |
|---|---|---|---|---|---|---|---|
| C | JAN. 1-1910 | V | APR. 1-1918 | BX | NO SURVEY | CA | APRIL 2, 1930 |
| D | MAY 24-1910 | W | JULY 1-1918 | BY | | CB | OCT. 10, 1936 |
| E | AUG. 29-1910 | WW | OCT. 1-1918 | BW | | DC | OCT. 10, 1936 |
| F | NOV. 1-1910 | X | DEC. 31-1918 | BV | | DB | DEC. 31, 1936 |
| G | SEPT. 27-1910 | Y | JAN. 1-1919 | BU | | DA | MAY 11, 1937 |
| H | MAY 15-1911 | Z | JULY 1-1919 | BT | DEC. 24, 1926 | DZ | JULY 5, 1937 |
| I | NOV. 20-1911 | AA | OCT. 1-1919 | BS | DEC. 7, 1927 | DX | OCT. 9, 1937 |
| M | NOV. 1-1911 | AB | JAN. 1-1920 | BR | NO SURVEY | DW | OCT. 1937 |
| MM | JAN. 1-1912 | AC | JULY 1-1920 | BQ | | DV | MARCH, 1938 |
| L | FEB. 1-1912 | AD | JAN. 1-1921 | BP | | DT | JUNE 10, 1938 |
| O | MAY 1-1912 | AE | OCT. 1-1921 | BN | | DS | SEPT. 10, 1938 |
| K | SEPT. 1-1912 | AF | DEC. 31-1921 | BM | | DL | DEC. 22, 1938 |
| S | OCT. 1-1912 | AG | APR. 15, 1918 | BL | | DI | MARCH, 1939 |
| R | NONE SOLD | AI | JULY 1, 1918 | BK | JAN. 1, 1929 | DJ | JUNE 10, 1938 |
| P | NONE SOLD | J | OCT. 1, 1918 | BX | APRIL 15, 1929 | DH | OCT. 10, 1938 |
| U | SEPT. 17-1913 | AJ | DEC. 31, 1918 | BZ | AUG. 9, 1929 | DF | DEC. 9, 1940 |
| T | JAN. 1-1913 | AK | JULY 1, 1919 | CA | NO SURVEY | DE | MARCH 15, 1940 |
| N | NOV. 1-1913 | AL | JULY 8, 1919 | CB | DEC. 30, 1929 | DD | JULY 3, 1940 |
| Q | DEC. 1-1913 | AM | OCT. 28, 1919 | CC | APRIL 15, 1930 | DC | SEPT. 30, 1940 |
| V | SEPT. 15-1913 | AN | DEC. 24, 1919 | CD | AUG. 1, 1930 | DB | DEC. 9, 1940 |
| W | JAN. 1-1914 | AO | MARCH, 1920 | CE | NO SURVEY | DA | APRIL 2, 1941 |
| X | NOV. 1-1914 | AP | JULY, 1920 | CF | " | DY | JULY 9, 1941 |
| Y | DEC. 1-1914 | AQ | OCT. 6, 1920 | CG | " | DW | OCT. 8, 1941 |
| Z | DEC. 31-1914 | AR | DEC. 30, 1920 | CH | " | DX | DEC. 15, 1941 |
| C' | DEC. 31-1914 | AT | No Survey Made | CI | " | DY | MARCH 10, 1942 |
| D' | NOV. 23-1915 | AU | " " | CJ | " | DZ | JUNE 17, 1942 |
| E' | DEC. 31-1915 | AV | DEC. 10, 1921 | CK | " | EA | DEC. 9, 1942 |
| F' | NO SURVEY MADE | AW | No Survey Made | CL | " | EB | JAN. 19, 1942 |
| H' | DEC. 31-1915 | AX | " " | CM | " | | FINISHED-FEB. 2, 1943. |
| I' | MAR. 31-1916 | AY | " " | CN | " | | " |
| L' | OCT. 31-1916 | AZ | DEC. 18, 1922 | CO | " | | |
| M' | DEC. 31-1916 | BA | No Survey Made | CP | " | | |
| N' | APR. 15-1917 | BB | JULY 1, 1923 | CR | JAN. 15, 1934 | | |
| O' | JULY 1-1917 | BC | OCT. 15, 1923 | CS | NO SURVEY | | |
| P' | DEC. 31-1917 | BD | JAN. 15, 1924 | CT | JUNE 15, 1934 | | |
| Q' | DEC. 31-1917 | BE | JAN. 23, 1924 | CU | NO SURVEY | | |
| R' | APR. 15-1918 | BF | JULY 1, 1924 | CV | MAR. 7, 1935 | | |
| S' | JULY 1-1918 | BG | OCT. 15, 1924 | CW | MAR. 7, 1935 | | |
| T' | OCT. 1-1918 | BH | JAN. 17, 1925 | CX | AUG. 3, 1935 | | |
| U' | DEC. 31-1918 | BI | APR. 15, 1925 | CY | OCT. 31, 1935 | | |
| | | | OCT. 15, 1925 | CZ | DEC. 17, 1935 | | |