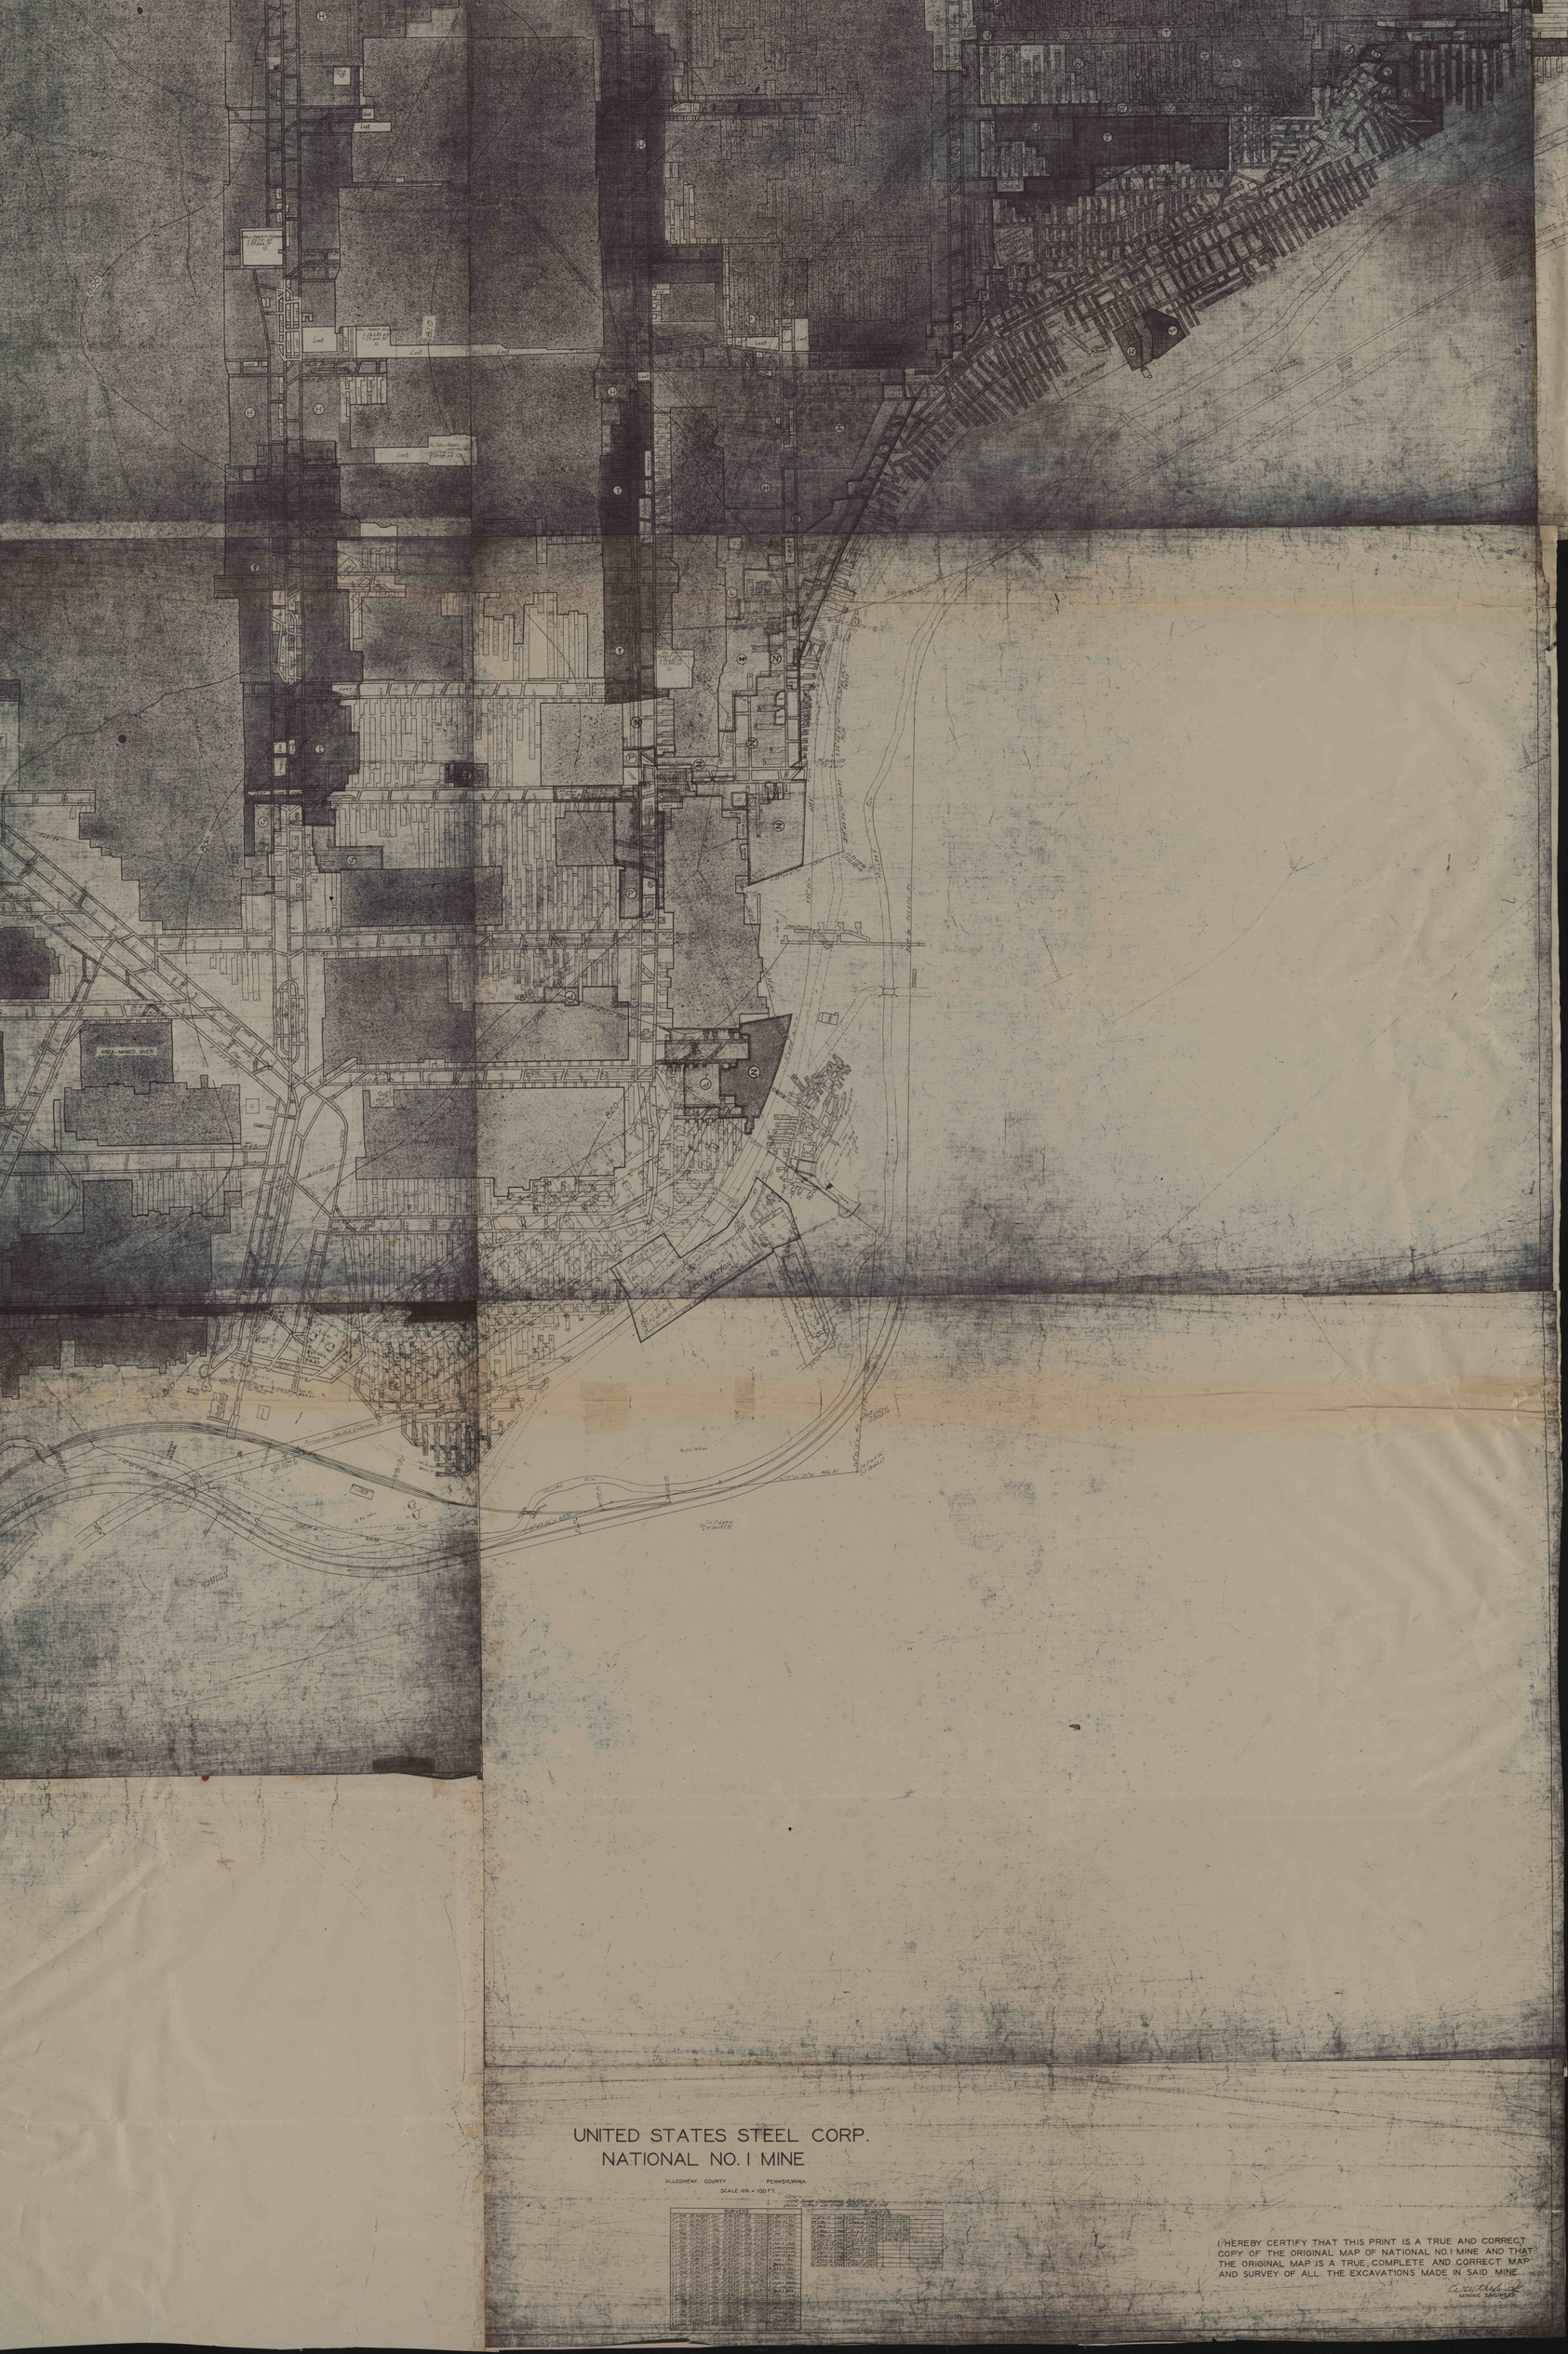

UNITED STATES STEEL CORP.
NATIONAL NO. 1 MINE

ALLEGHENY COUNTY PENNSYLVANIA

SCALE HN. = 100 FT.

I HEREBY CERTIFY THAT THIS PRINT IS A TRUE AND CORRECT COPY OF THE ORIGINAL MAP OF NATIONAL NO.1 MINE AND THAT THE ORIGINAL MAP IS A TRUE, COMPLETE AND CORRECT MAP AND SURVEY OF ALL THE EXCAVATIONS MADE IN SAID MINE.

MINING ENGINEER