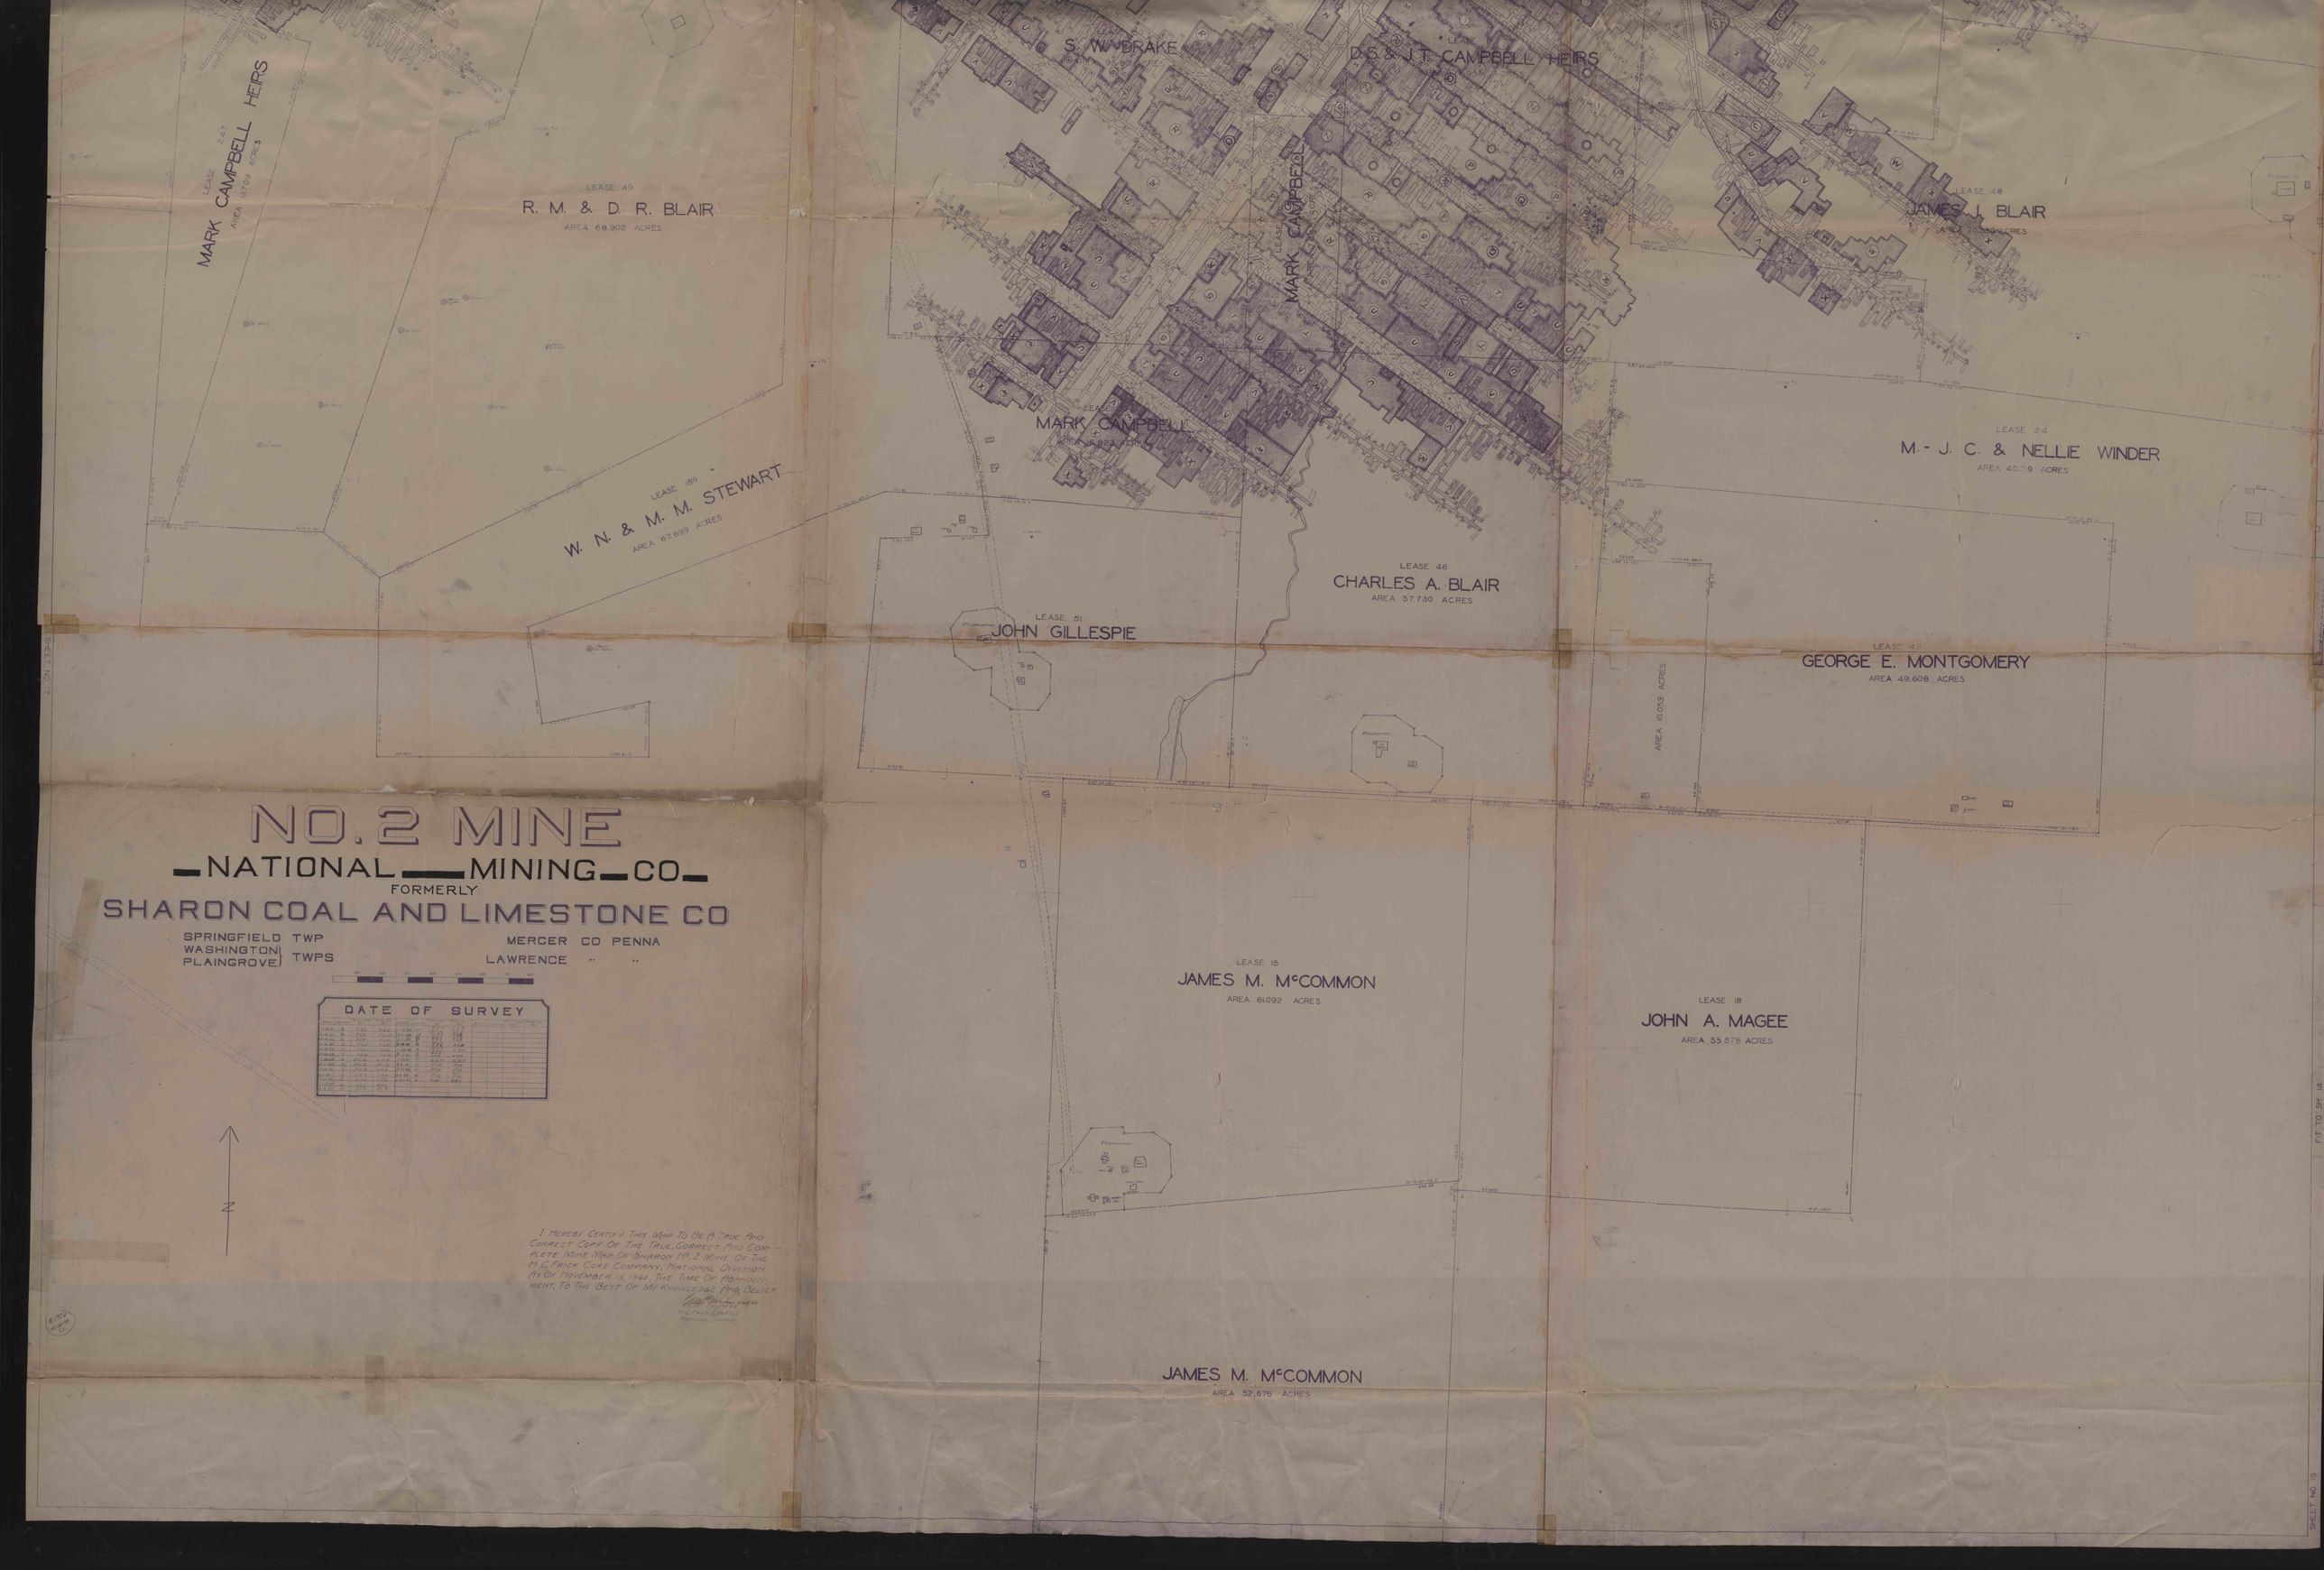
MARK CAMPBELL HEIRS
LEASE 49
R. M. & D. R. BLAIR
AREA 68.902 ACRES
W. N. & M. M. STEWART
AREA 67.699 ACRES
S. W. DRAKE
D.S. & J.T. CAMPBELL HEIRS
MARK CAMPBELL
JAMES J. BLAIR
M. - J. C. & NELLIE WINDER
AREA 40.79 ACRES
CHARLES A. BLAIR
AREA 57.730 ACRES
JOHN GILLESPIE
GEORGE E. MONTGOMERY
AREA 49.608 ACRES
JAMES M. McCOMMON
AREA 61.092 ACRES
JOHN A. MAGEE
AREA 55.578 ACRES
JAMES M. McCOMMON
AREA 52.676 ACRES
NO. 2 MINE
NATIONAL MINING CO
FORMERLY
SHARON COAL AND LIMESTONE CO
SPRINGFIELD TWP
WASHINGTON } TWPS
PLAINGROVE }
MERCER CO PENNA
LAWRENCE " "
DATE OF SURVEY
N
I HEREBY CERTIFY THIS MAP TO BE A TRUE AND CORRECT COPY OF THE TRUE CORRECT AND COMPLETE MINE MAP OF SHARON NO. 2 MINE OF THE H.C. FRICK COKE COMPANY, NATIONAL DIVISION AS OF NOVEMBER 15, 1942. THE TIME OF ADMEASUREMENT, TO THE BEST OF MY KNOWLEDGE AND BELIEF