


A. J. JACK TRACT

H . K . W I C K



HELLER TRACT

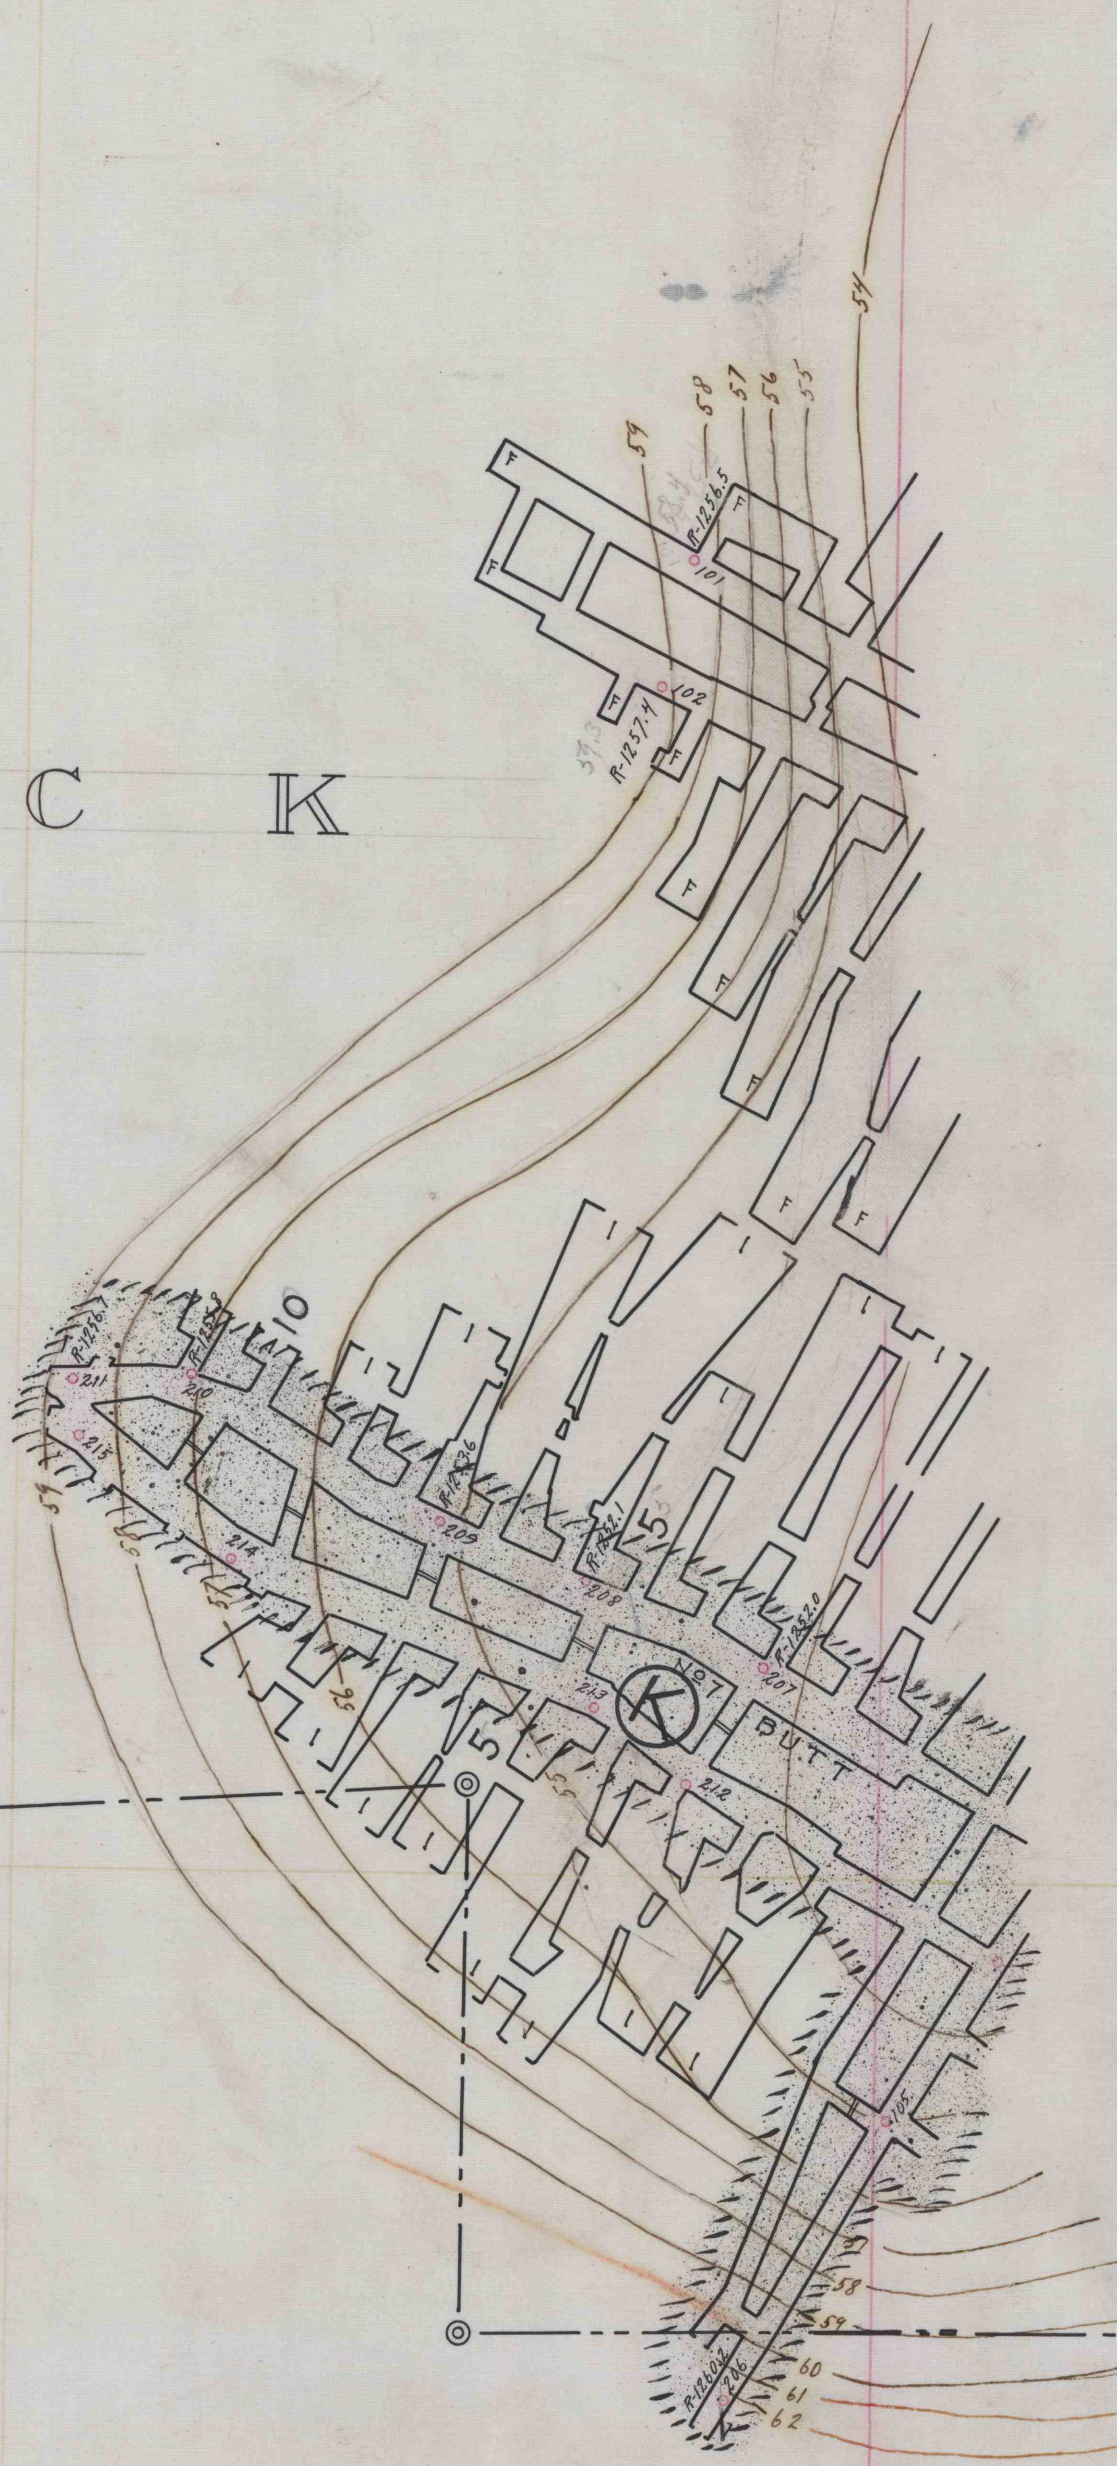

J . F O S T A D T TRACT

H . K . W I C K

T H O S . R O D G E R S TRACT

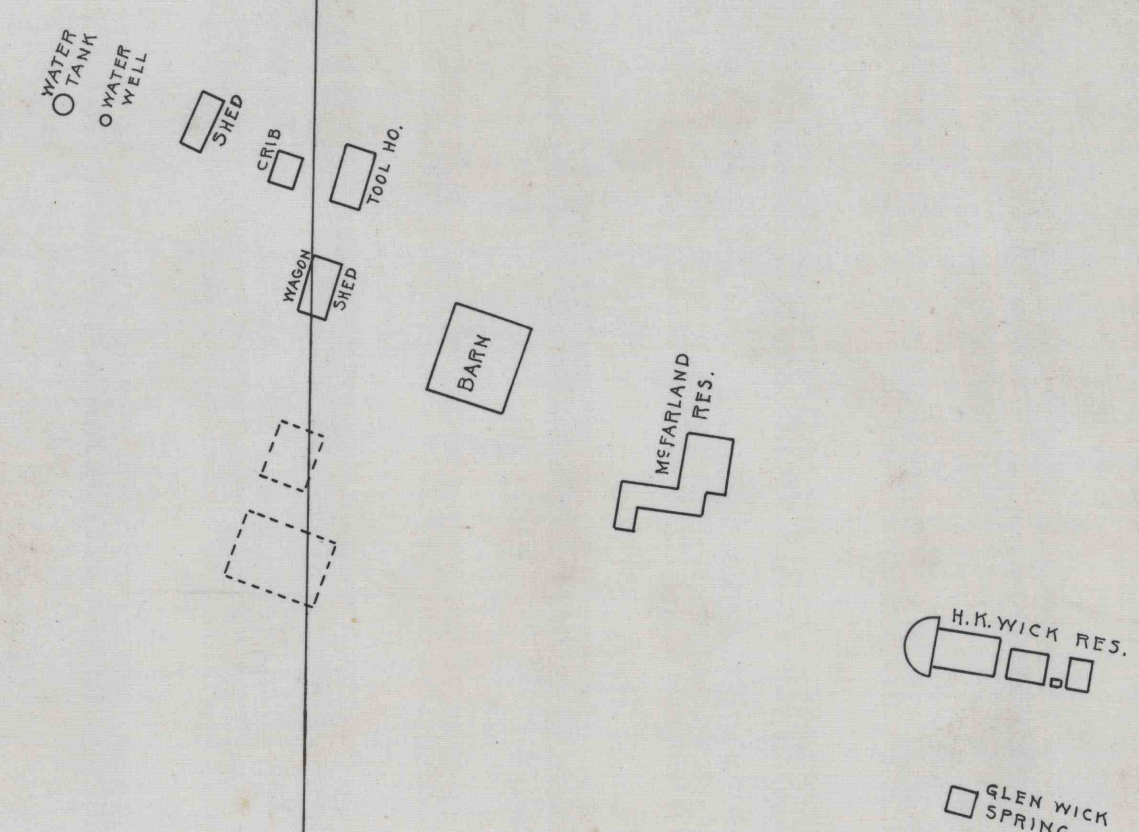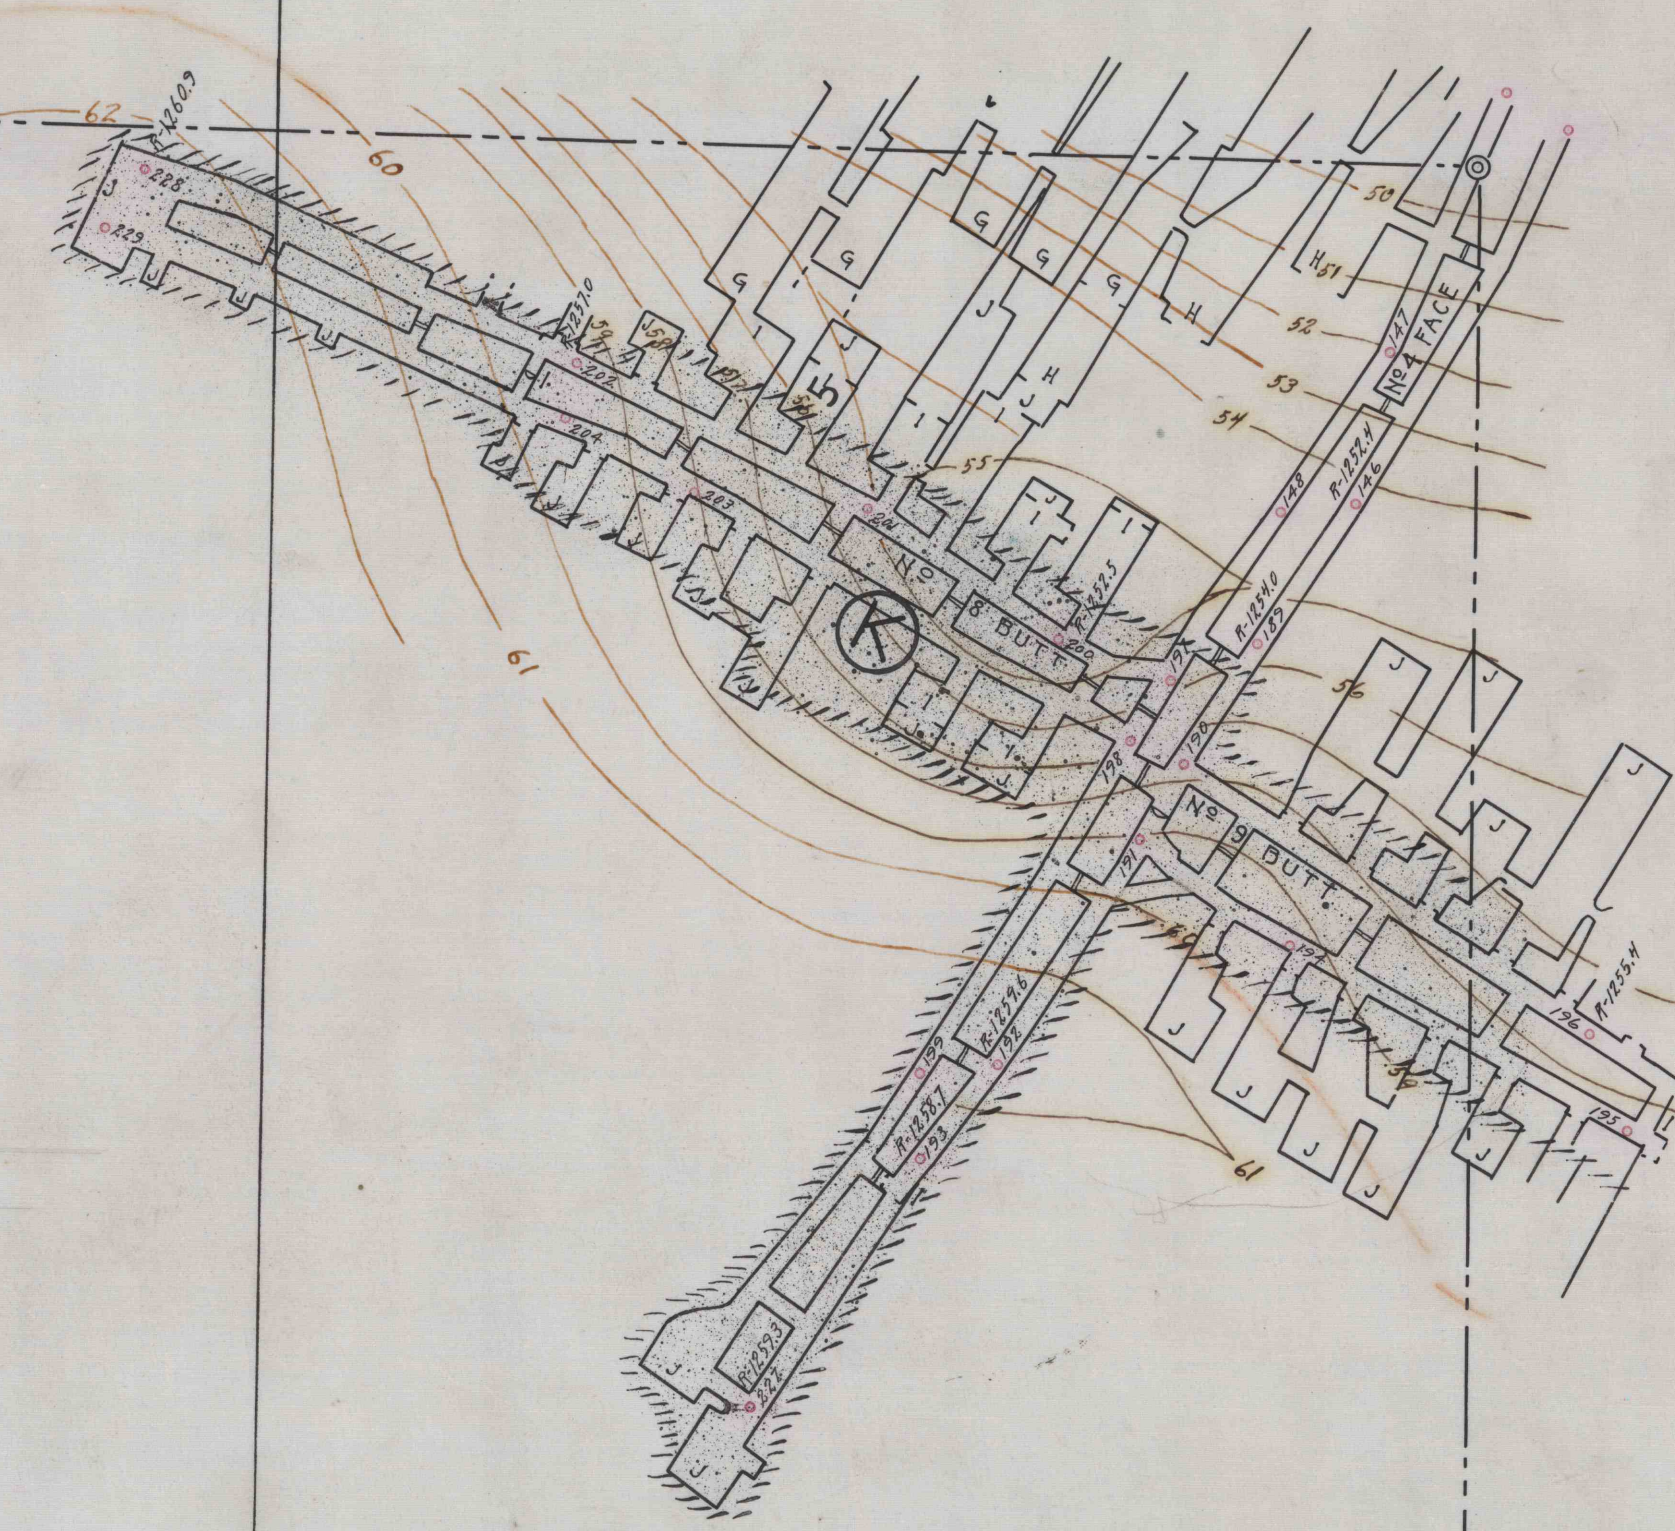

J . G . H E L L E R

H . K . W I C K
J . G I B S O N TRACT .

87008
Sheet 5 of 5