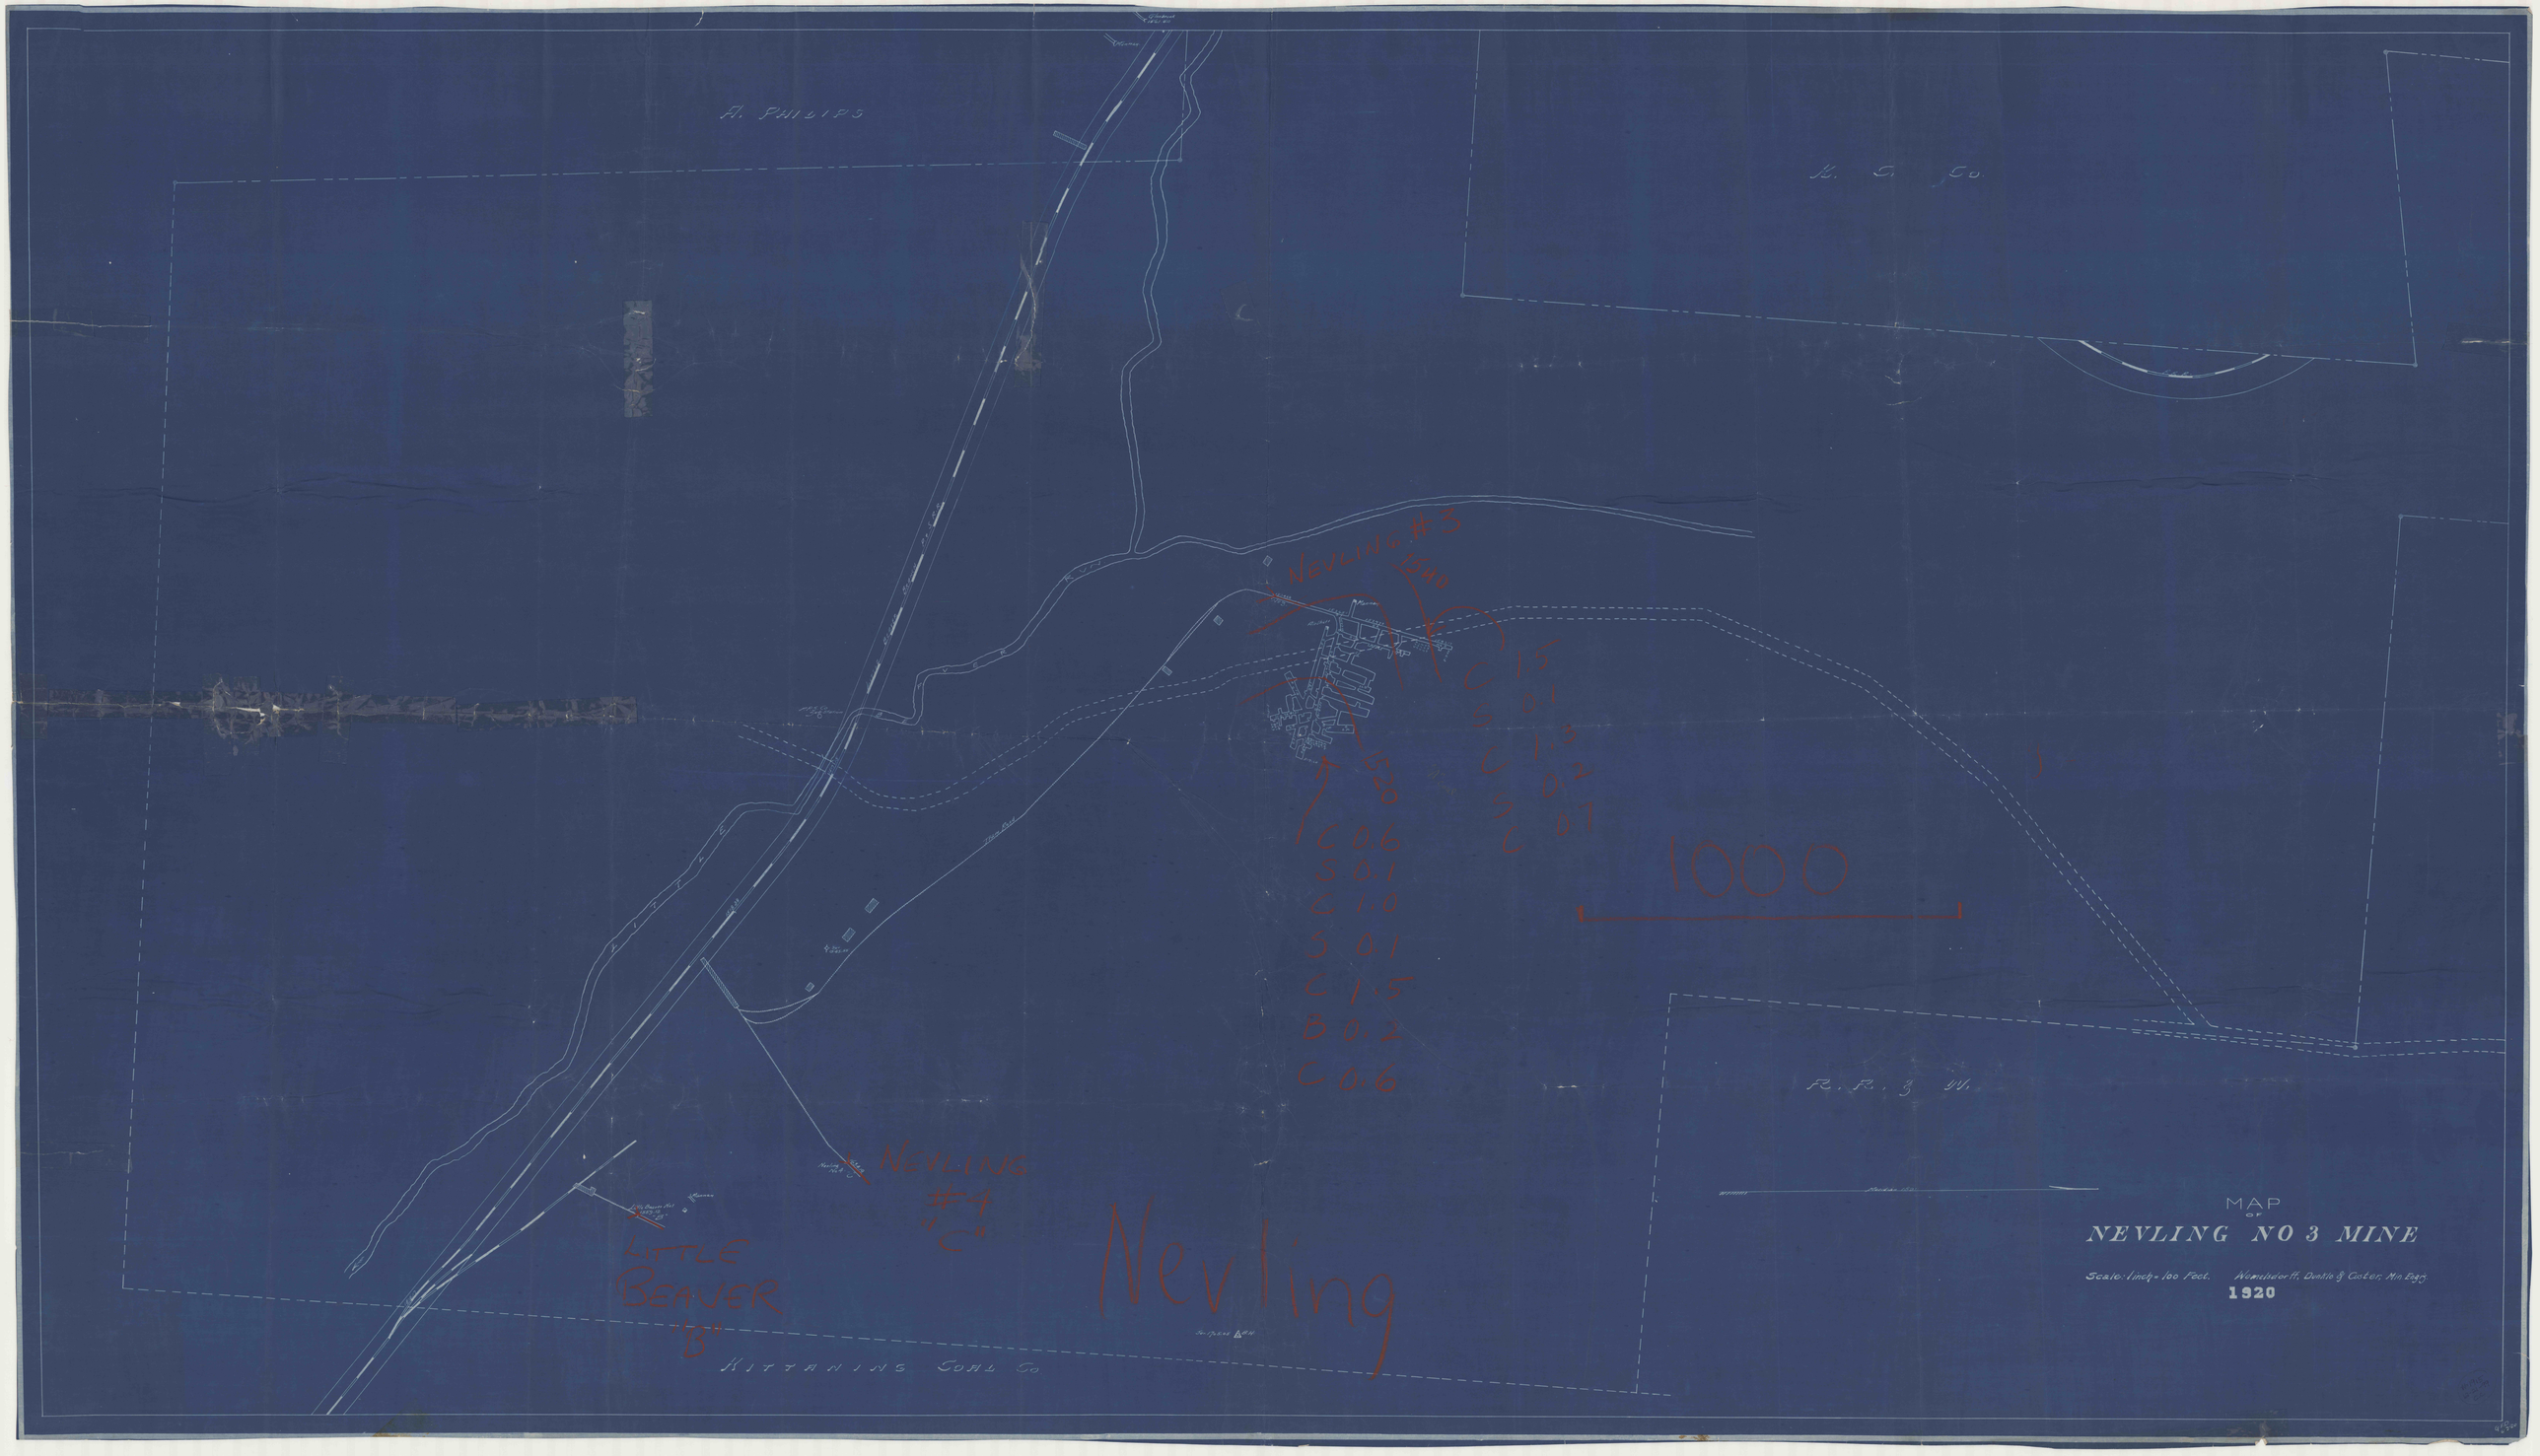
A. PHILIPS
K. C. Co.
NEVLING #3
640
C 1.5
S 0.1
C 1.3
S 0.2
C 0.7
640
C 0.6
S 0.1
C 1.0
S 0.1
C 1.5
B 0.2
C 0.6
1000
R. R. & W.
NEVLING
#4
"C"
LITTLE
BEAVER
"B"
Nevling
KITTANING COAL Co.
MAP
OF
NEVLING NO 3 MINE
Scale: 1 inch = 100 Feet.
Nomsbdorff, Dunlap & Coder, Min. Engs.
1920