


#221  
12-2-24  
CL

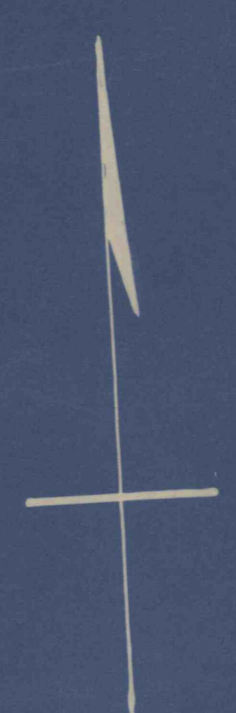

**FRANK NOERR MINE**  
Adjacent to B-Y.C.M.Co's. West Eureka N°11  
Situate in McCalmont Twp. Jeff. Co., Pa.  
Scale 1"=100'  
May 2, 1924.

H.M. Kanarr,  
Eng'r.  
Punxsutawney, Pa.

*H. J. Lewis  
Mining Inspector*

