


A.G. BARRON

V. BALLARATTO

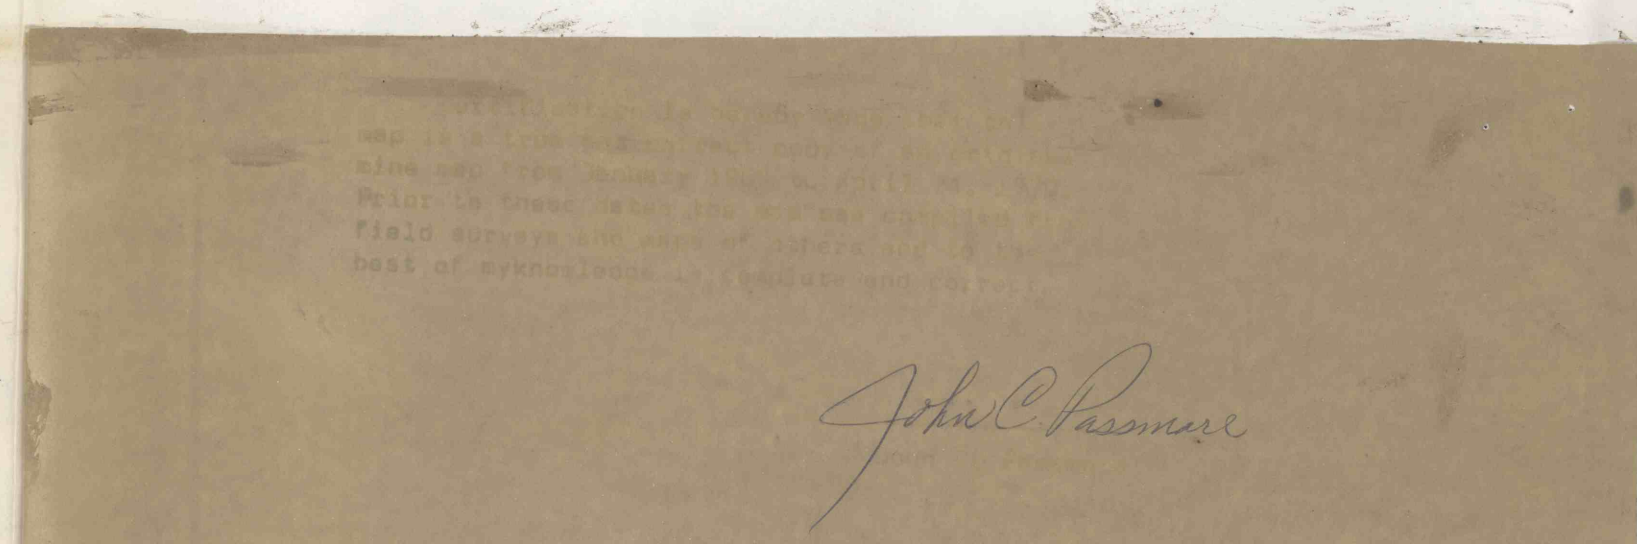

ABANDONED MINE MAP
 DEEP MINE PROPERTY MAP
 NORTH CAMP # 1 MINE
 CHEST TOWNSHIP, CLEARFIELD CO
 MIDDLE BRICKMANNING SEAM
 SCALE 1" = 100' DATE 9-24-70
 SURVEYOR JOHN C. PASSMORE
 JOHN C. PASSMORE
 SURVEYOR
 1954

MINING COMPLETED AREA 12-15-69 TO 4-24-70