




PROJECTION TO 30 JUNE 1968.  
400'

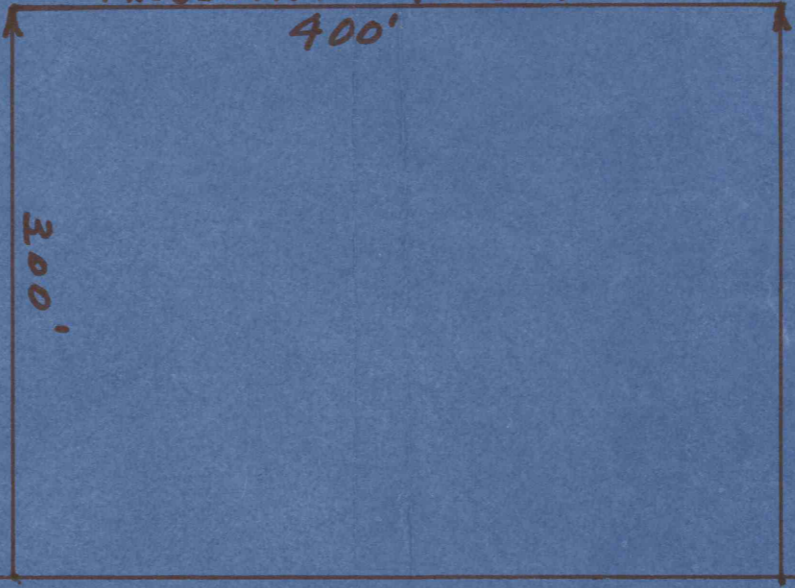

300'

NORTH CAMP #2 MINE  
OF

NORTH CAMP MINING CO.


LA JOSE, CLEFFIELD CO., PA.

SCALE - 1" = 100'

GEORGE R. JONES, P.E.  
#14254

NEW FLORENCE, PA.  
9 JUNE 1967

PROJECTION TO 30 JUNE 1968  
+925'

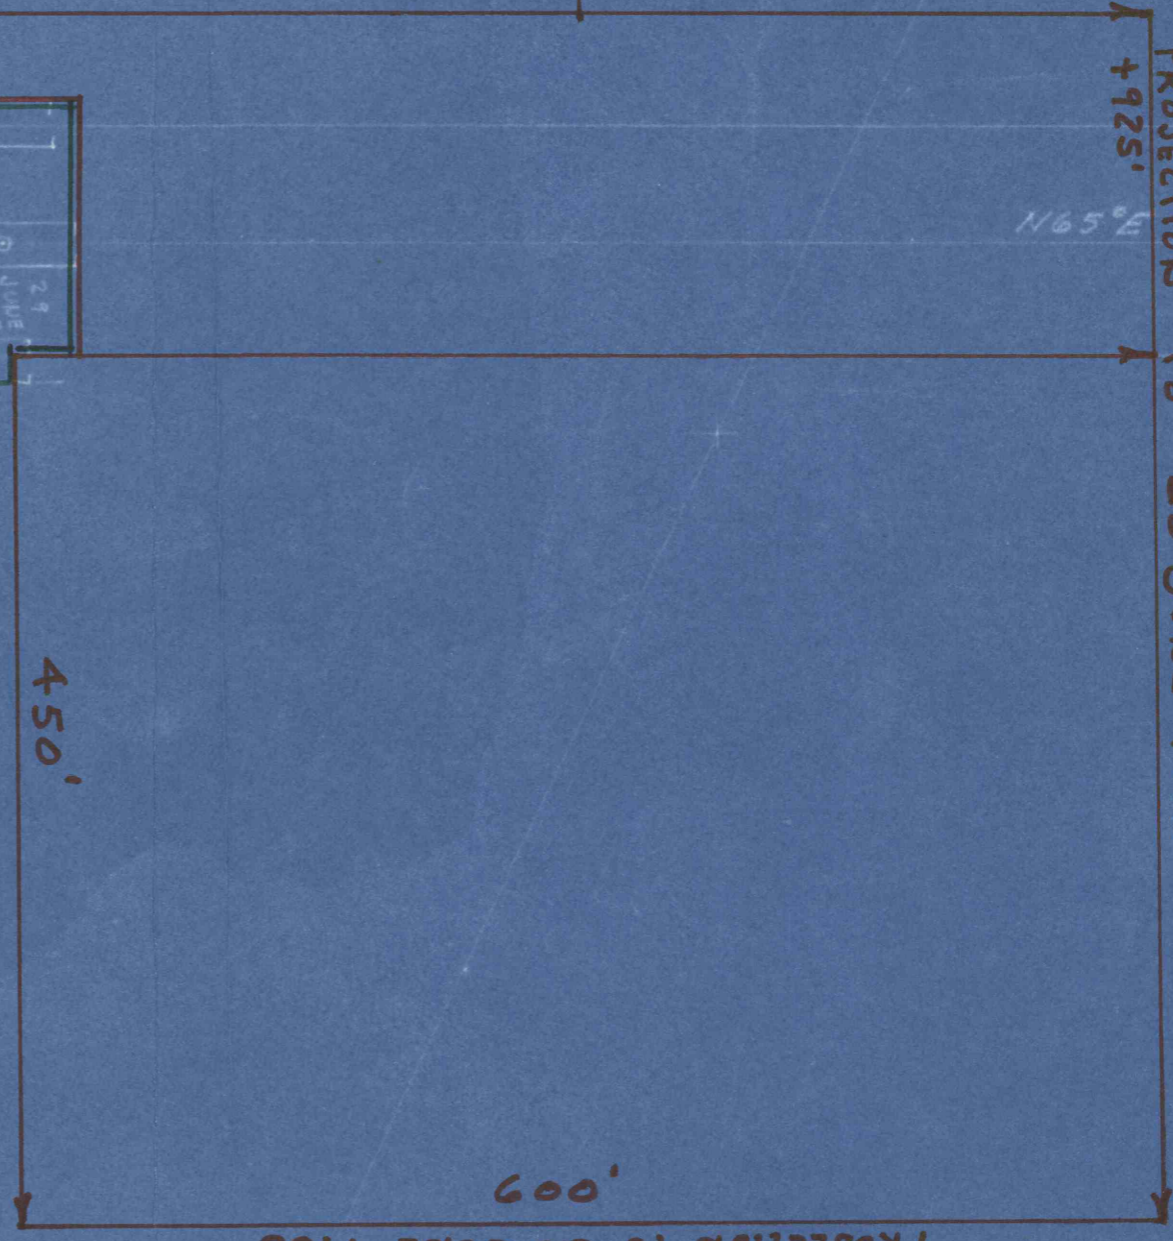

450'

PROJECTION TO 30 JUNE 1968  
'000



MINE BLDG  
31  
DEC.  
1967

29  
JUNE  
1967

C.P.A. ELEV. = 14829

B.M. = 1487.88

TO 12/31/67

PROJECTION TO 6/30/68



#1930  
12-21-67  
CC

- ③
- ②
- ①

60' 60'

N65°E