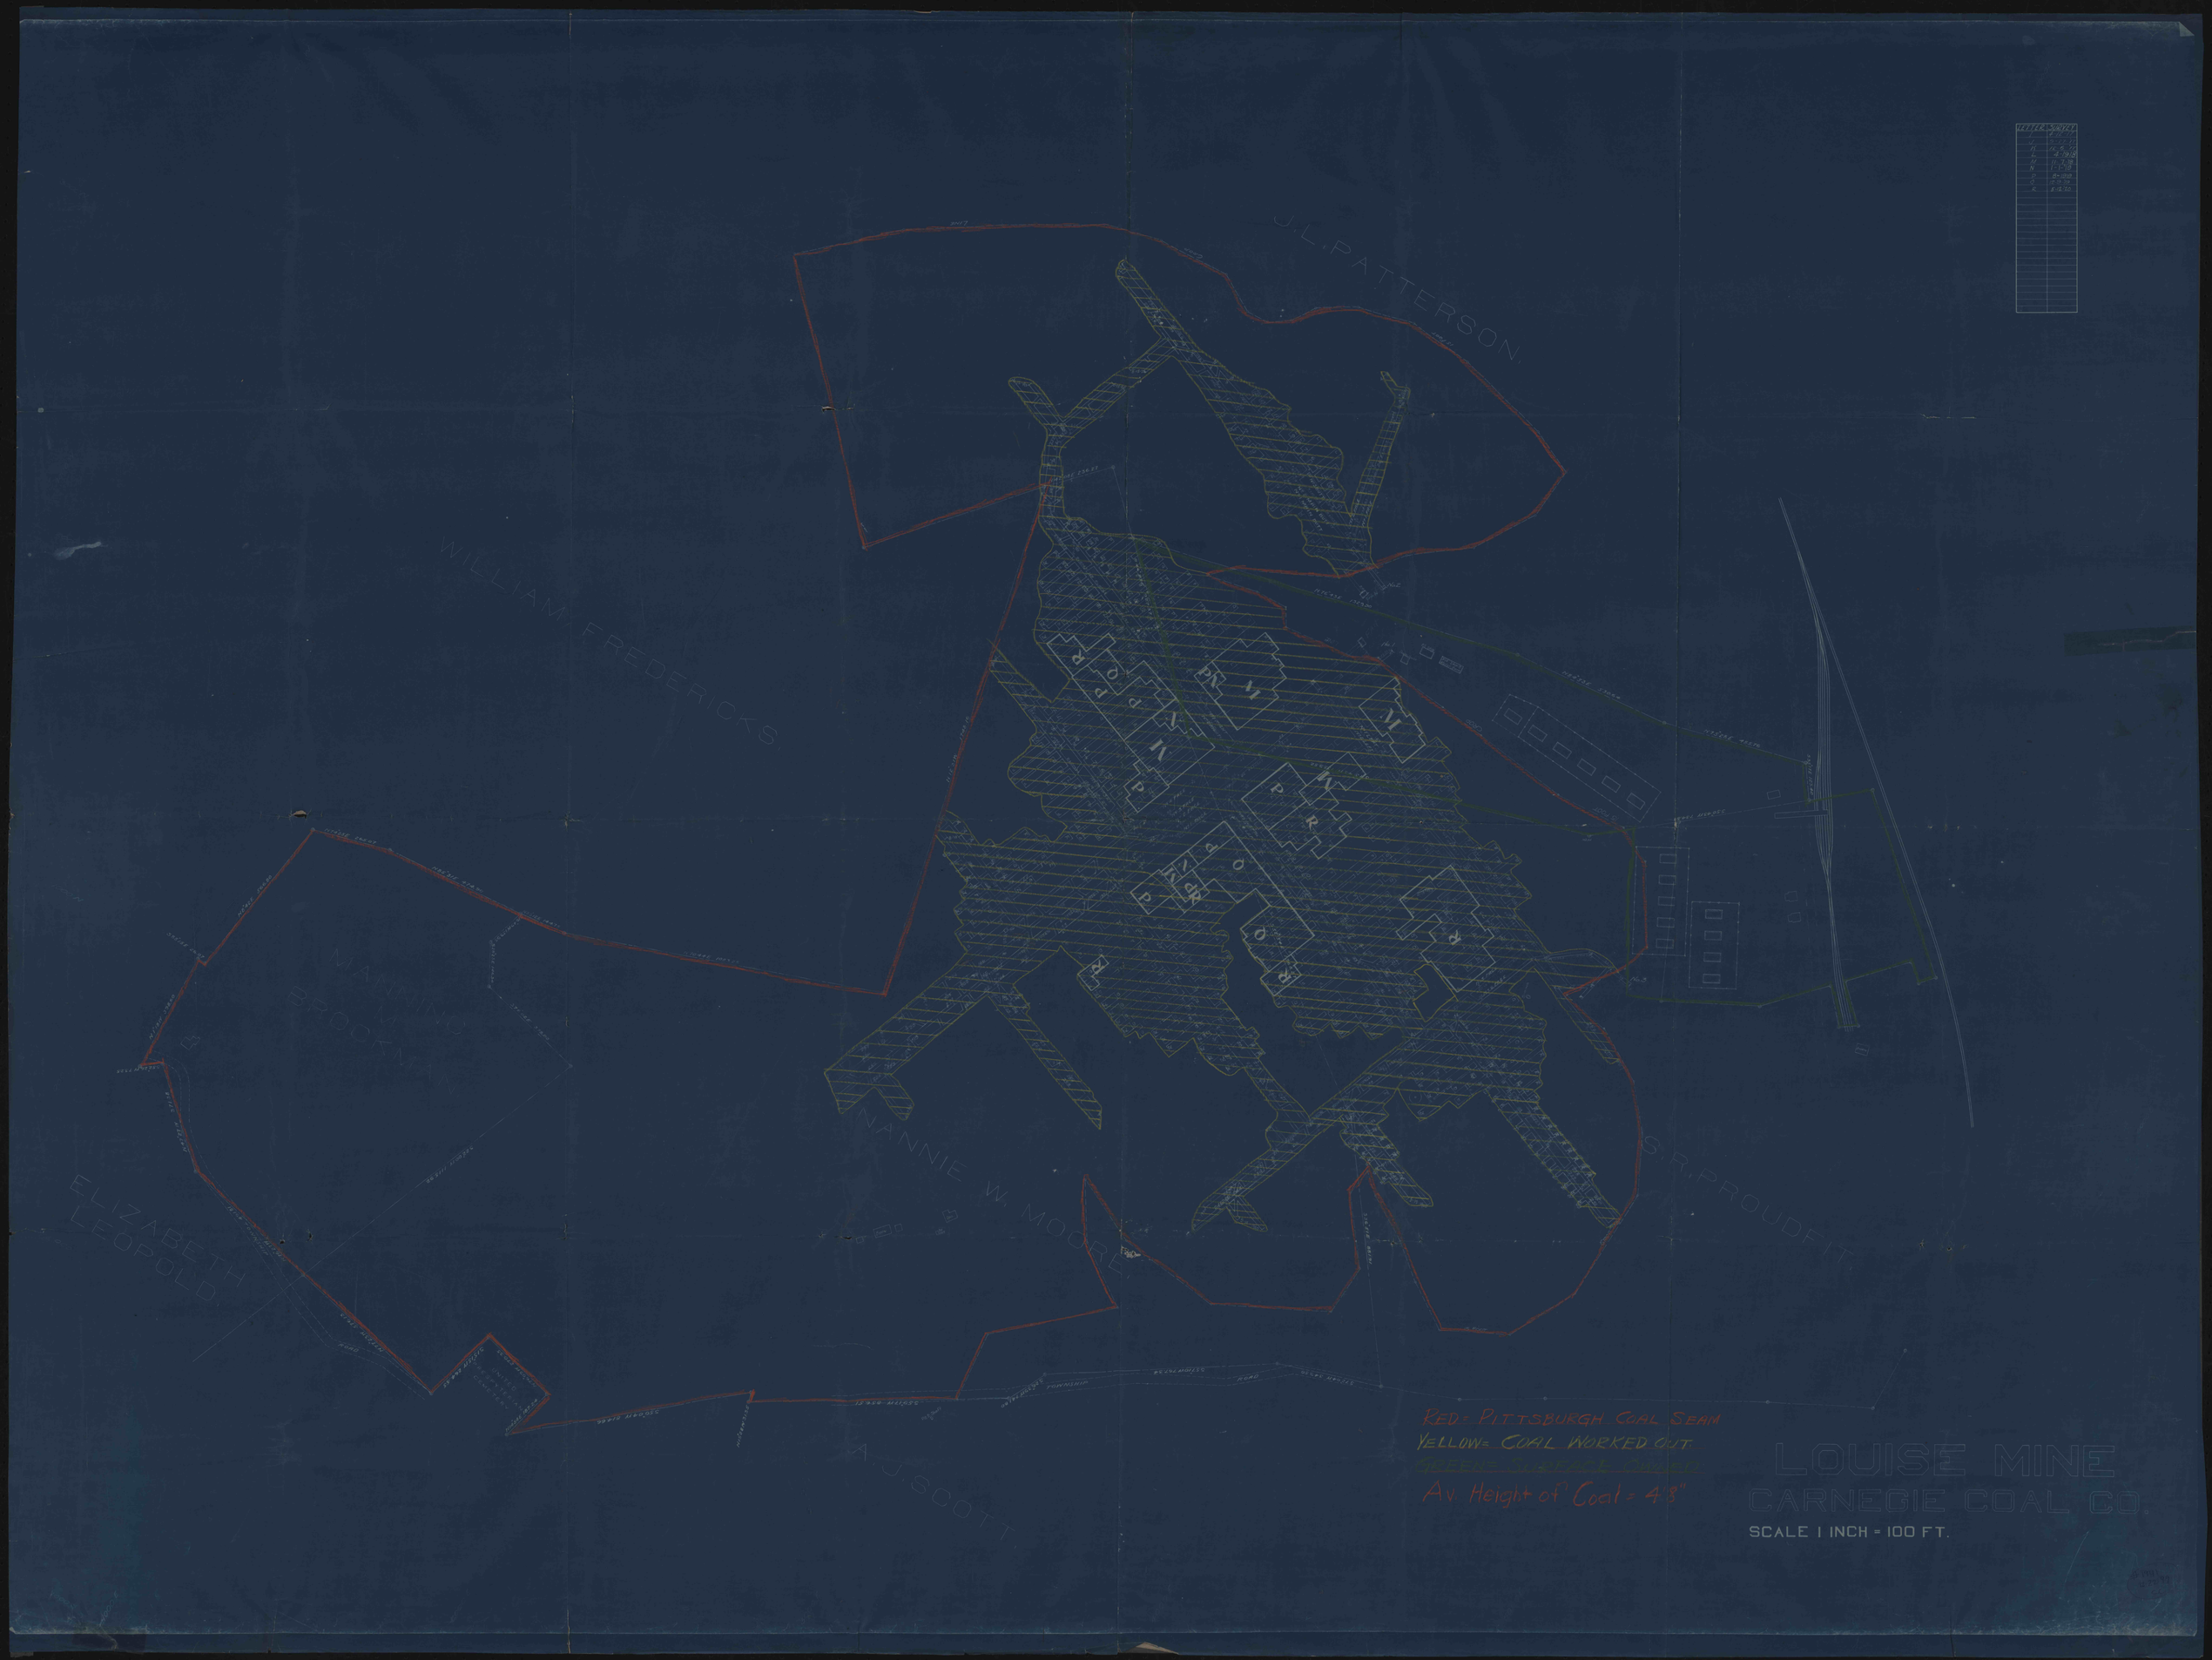
J.L. PATTERSON.
WILLIAM FREDERICKS.
MANNING M. BROCKMAN.
ELIZABETH LEOPOLD.
NANNIE W. MOORE.
S.R. PROUDFIT.
A.J. SCOTT.
RED = PITTSBURGH COAL SEAM
YELLOW = COAL WORKED OUT
GREEN = SURFACE OWNED
Av. Height of Coal = 4'8"
LOUISE MINE
CARNEGIE COAL CO.
SCALE 1 INCH = 100 FT.