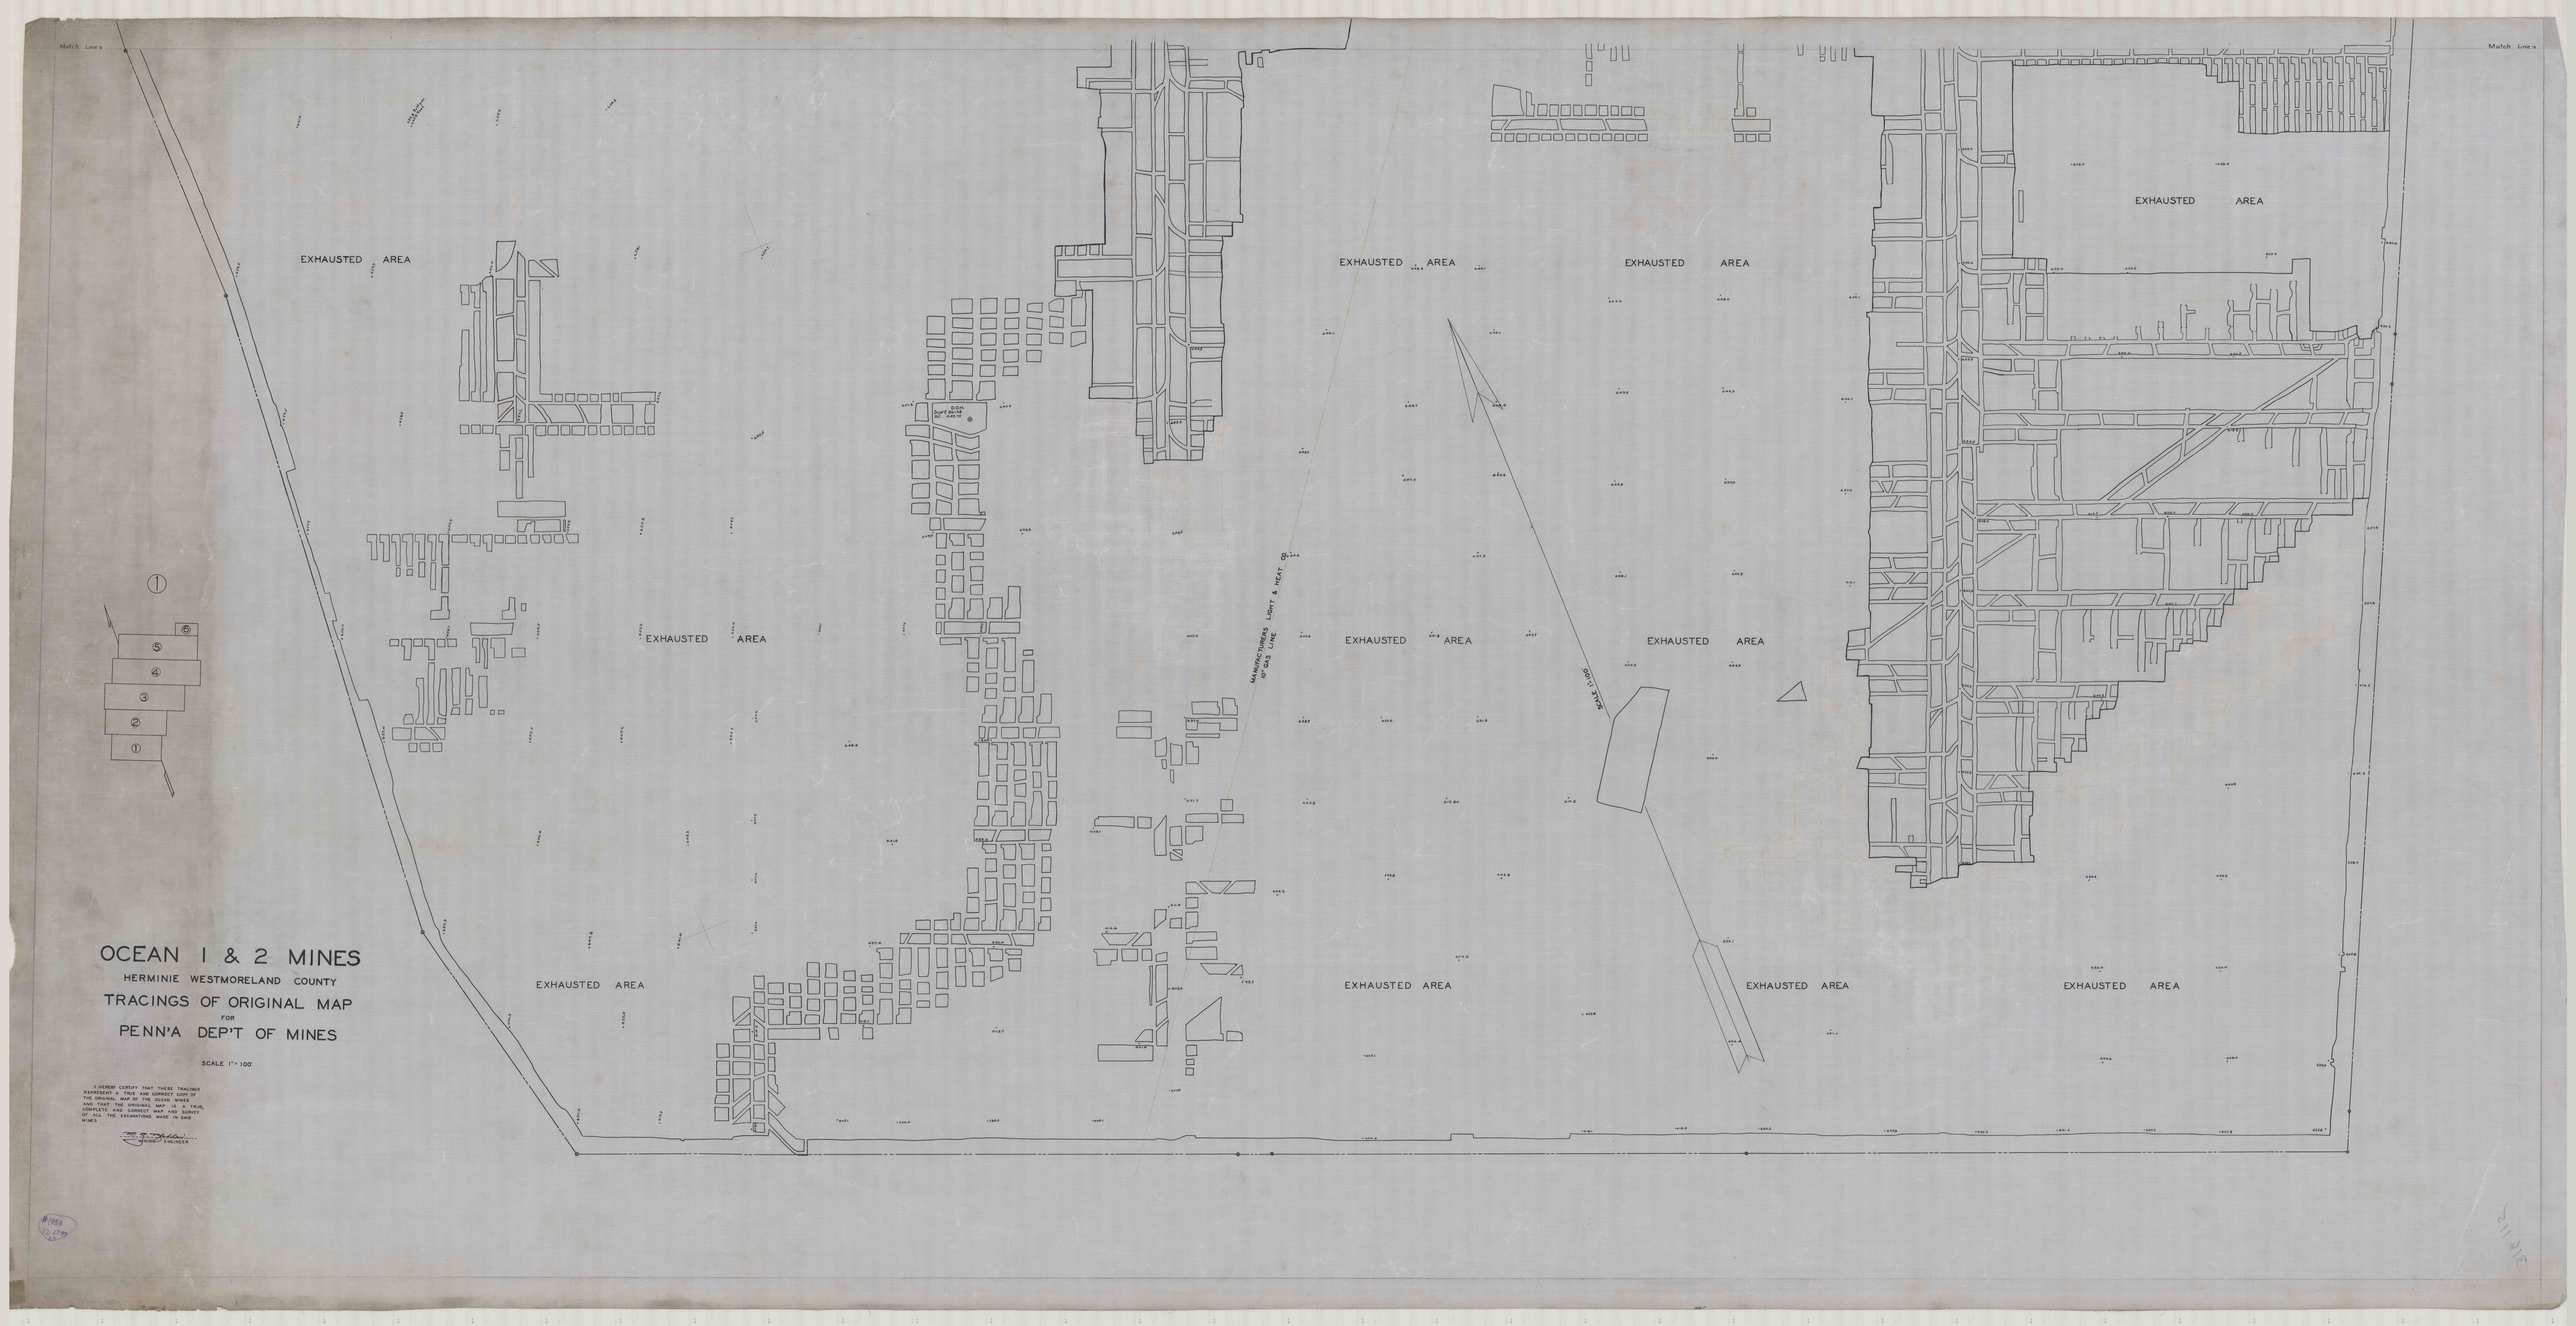

Match Line
Match Line
EXHAUSTED AREA
EXHAUSTED AREA
EXHAUSTED AREA
EXHAUSTED AREA
EXHAUSTED AREA
EXHAUSTED AREA
EXHAUSTED AREA
EXHAUSTED AREA
EXHAUSTED AREA
EXHAUSTED AREA
EXHAUSTED AREA
EXHAUSTED AREA
MANUFACTURERS LIGHT & HEAT CO.
10" GAS LINE
SCALE 1"=100'
①
②
③
④
⑤
⑥

# OCEAN 1 & 2 MINES

## HERMINIE WESTMORELAND COUNTY

## TRACINGS OF ORIGINAL MAP
FOR
## PENN'A DEP'T OF MINES

SCALE 1" = 100'

I HEREBY CERTIFY THAT THESE TRACINGS REPRESENT A TRUE AND CORRECT COPY OF THE ORIGINAL MAP OF THE OCEAN MINES AND THAT THE ORIGINAL MAP IS A TRUE, COMPLETE AND CORRECT MAP AND SURVEY OF ALL THE EXCAVATIONS MADE IN SAID MINES

MINING ENGINEER

#1953
12·27·99
C.a