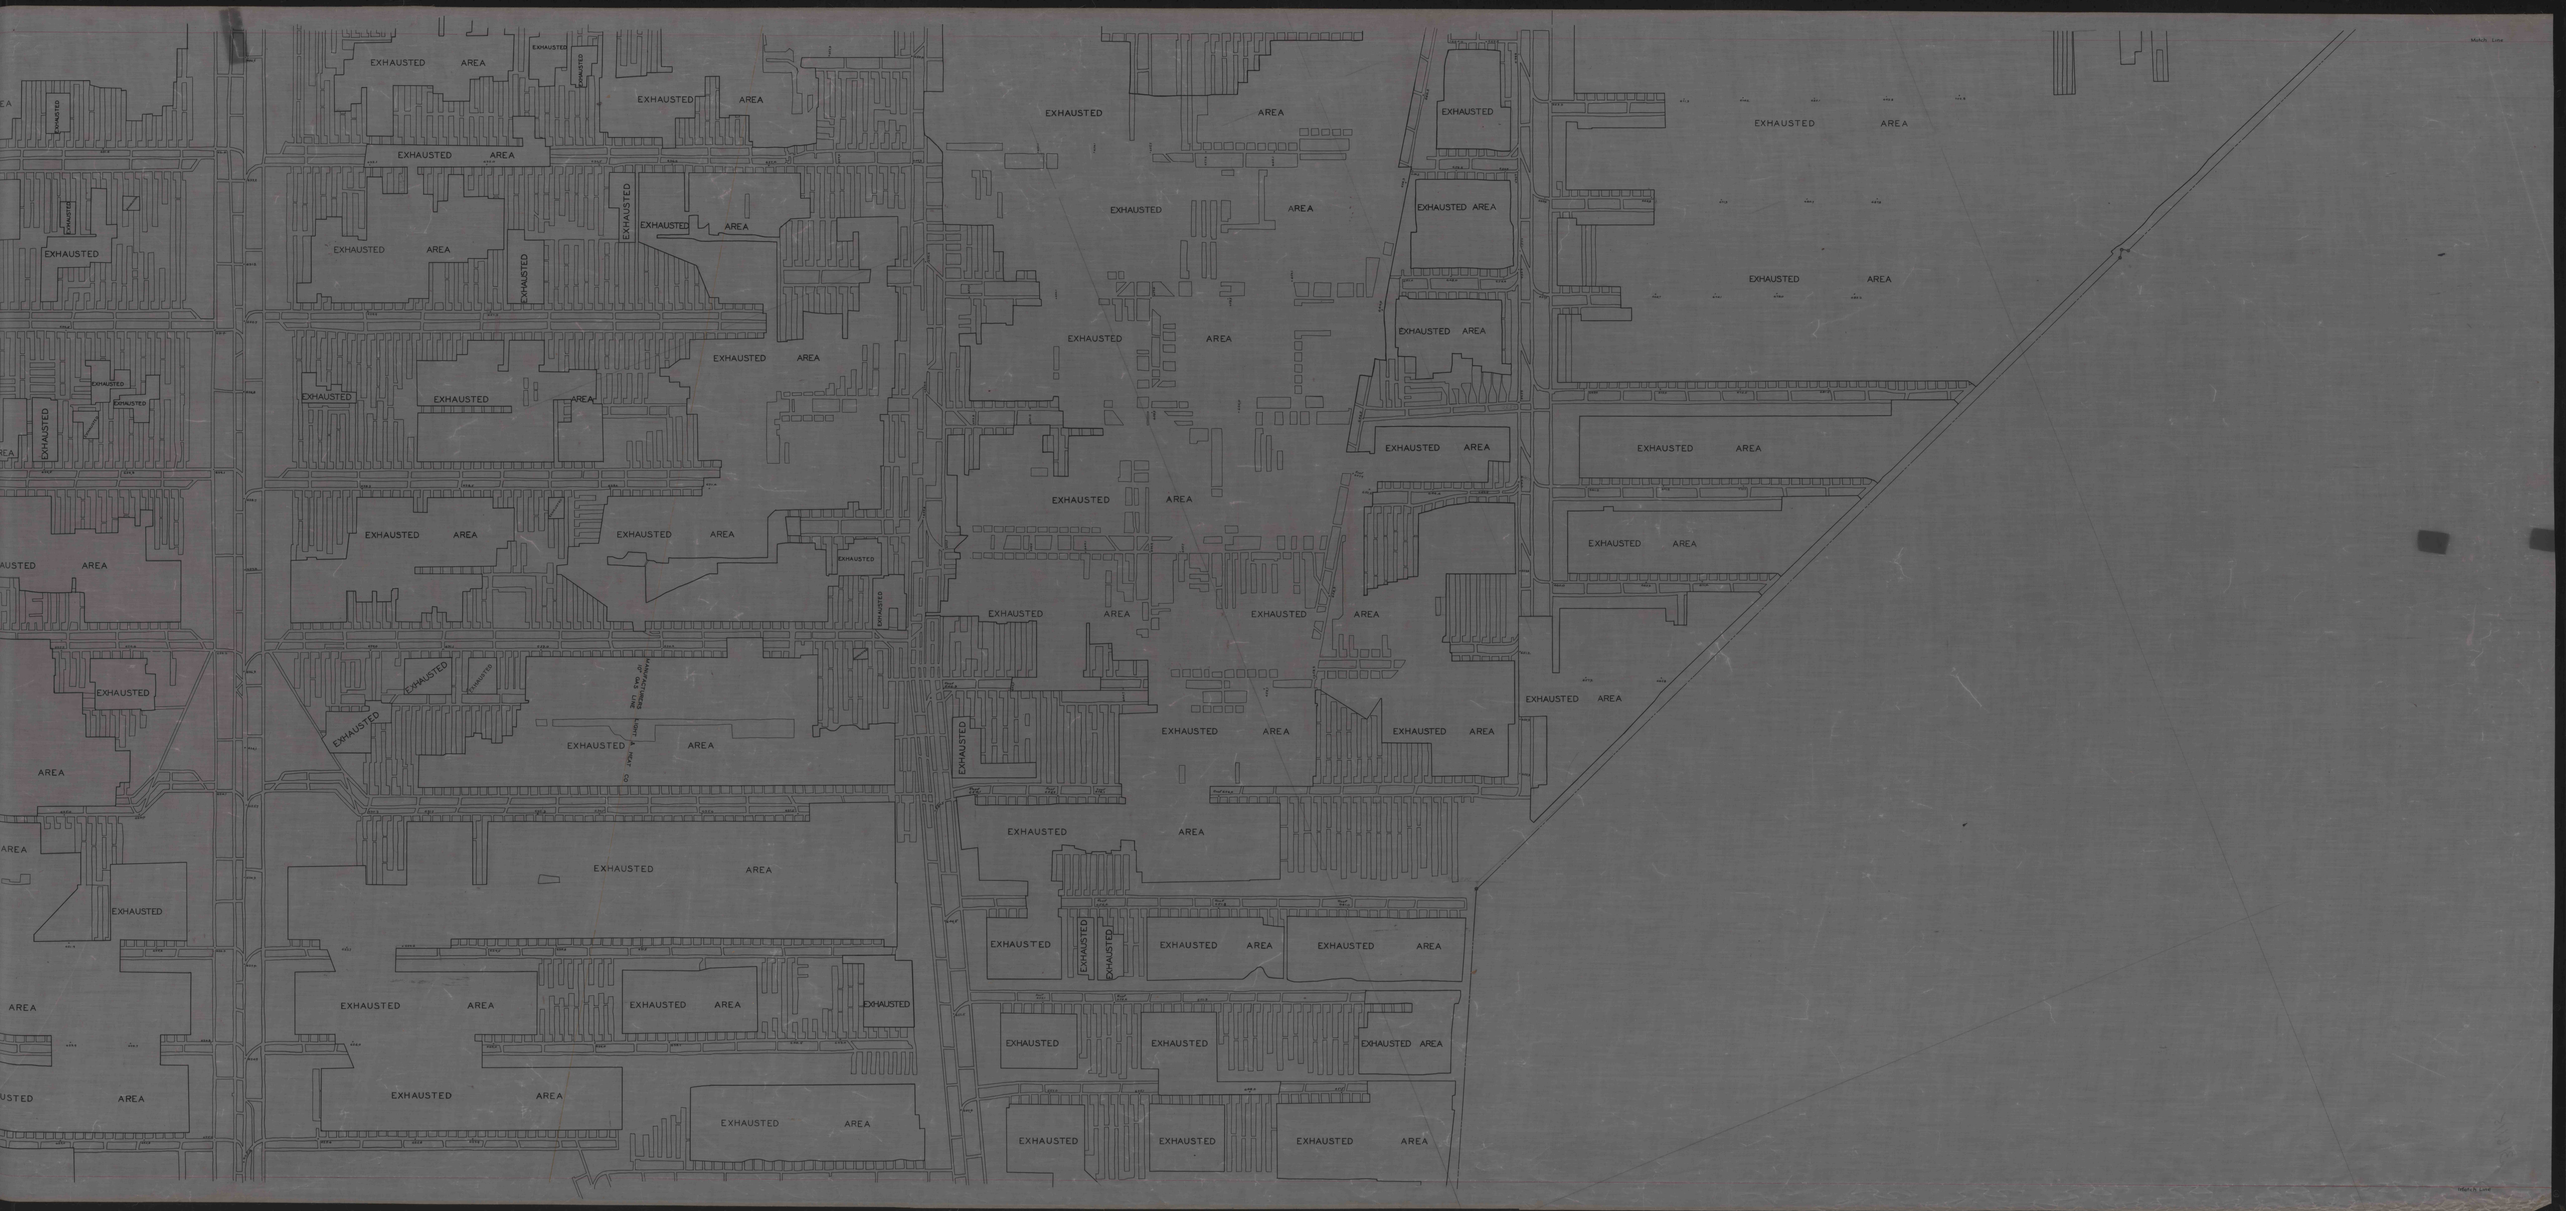
EXHAUSTED AREA
EXHAUSTED
AREA
MANUFACTURERS LIGHT & HEAT CO
