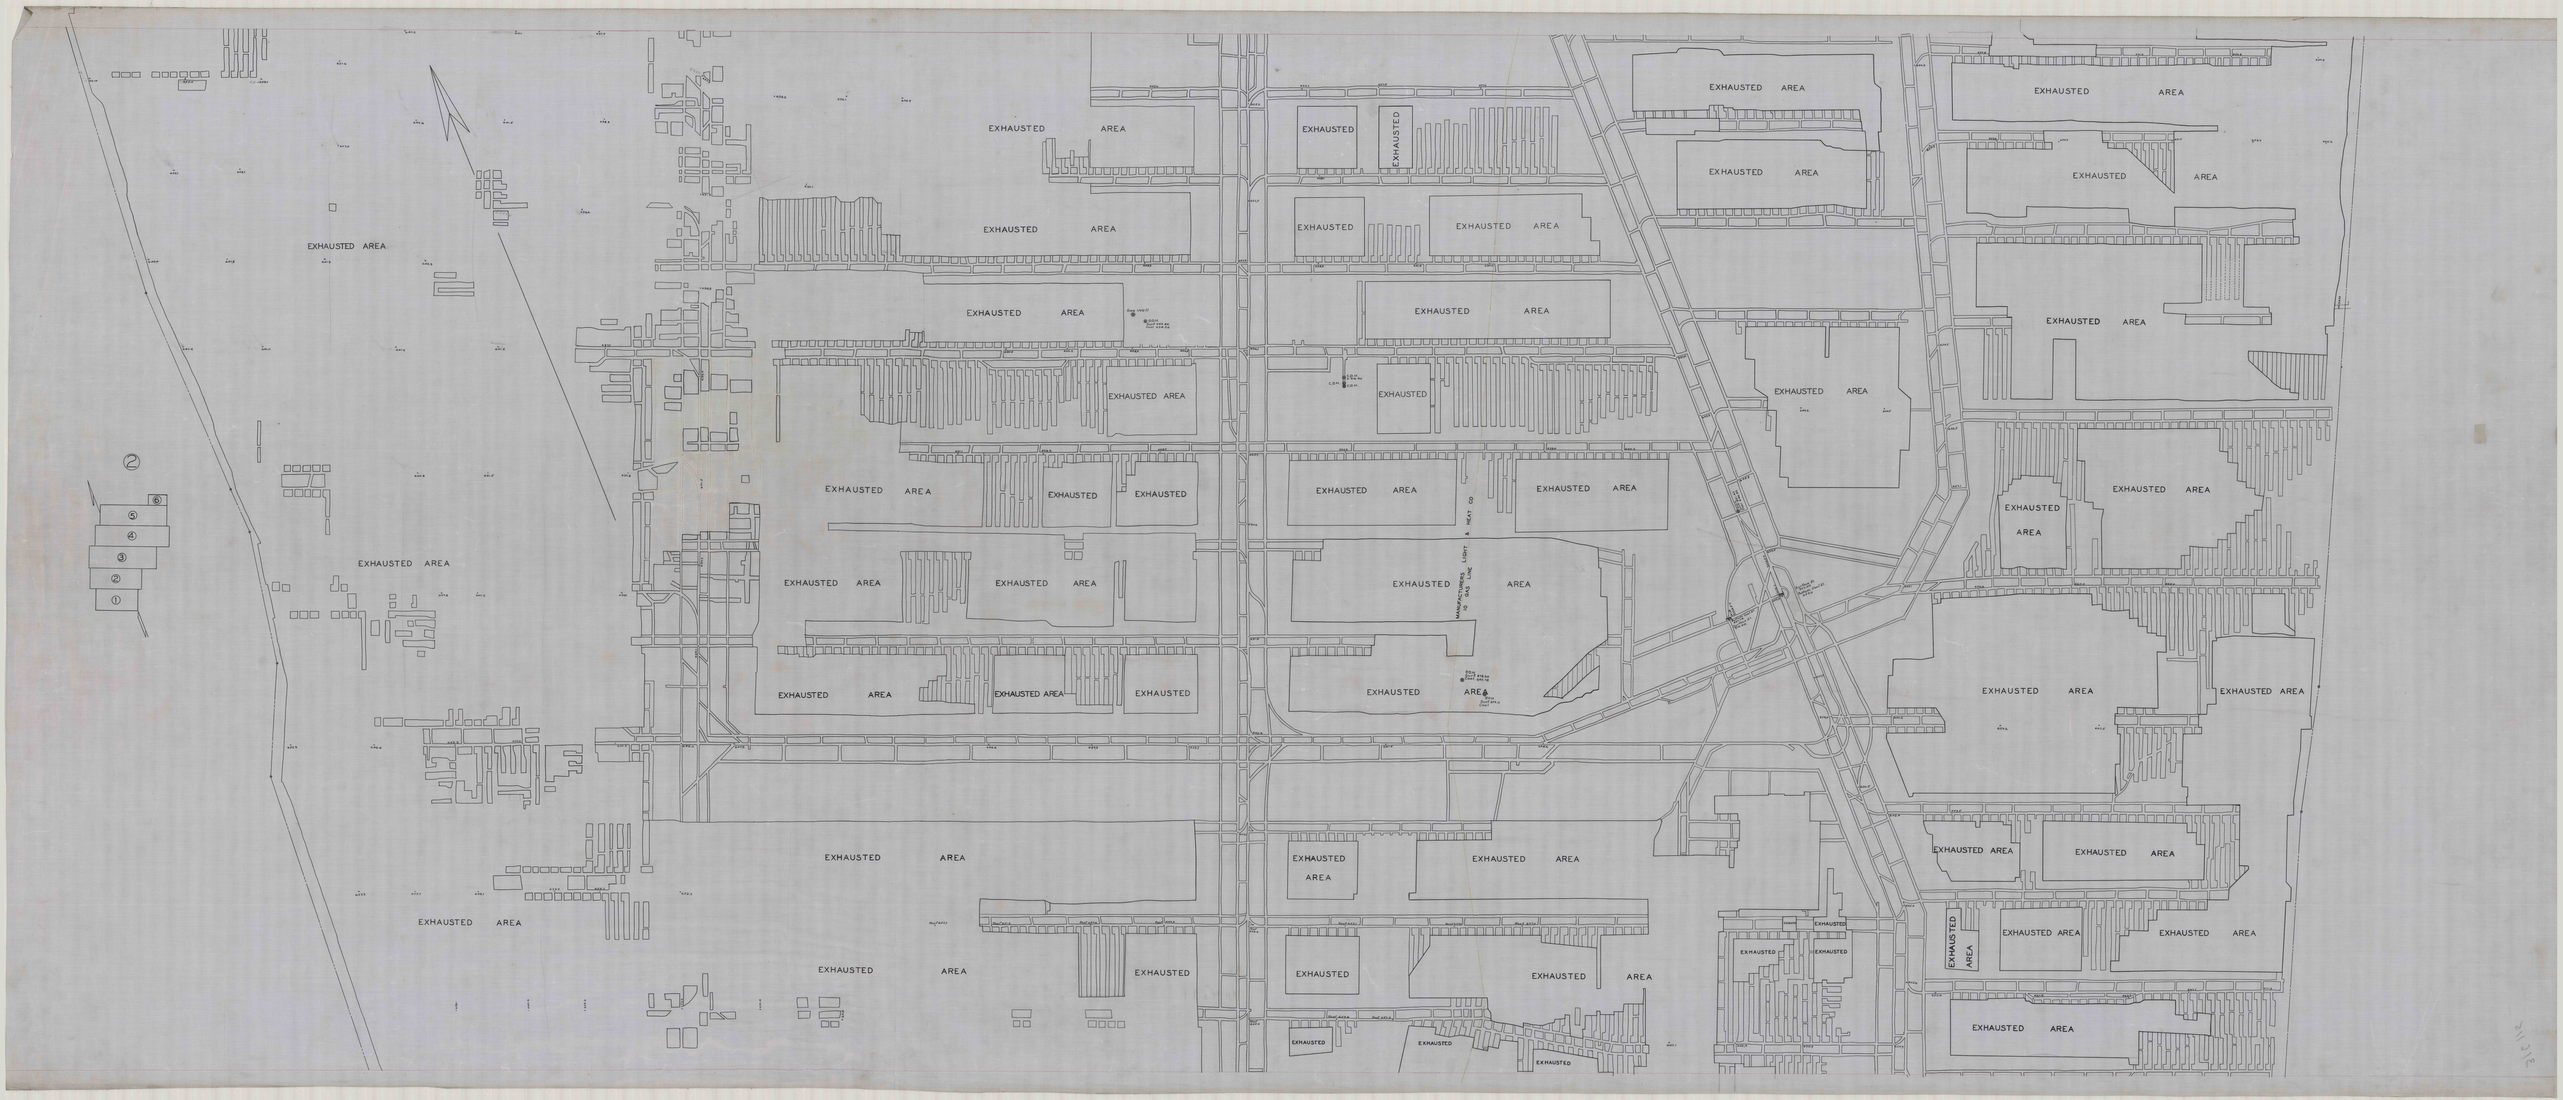
EXHAUSTED AREA
EXHAUSTED
MANUFACTURERS LIGHT & HEAT CO
TO GAS LINE