


P106

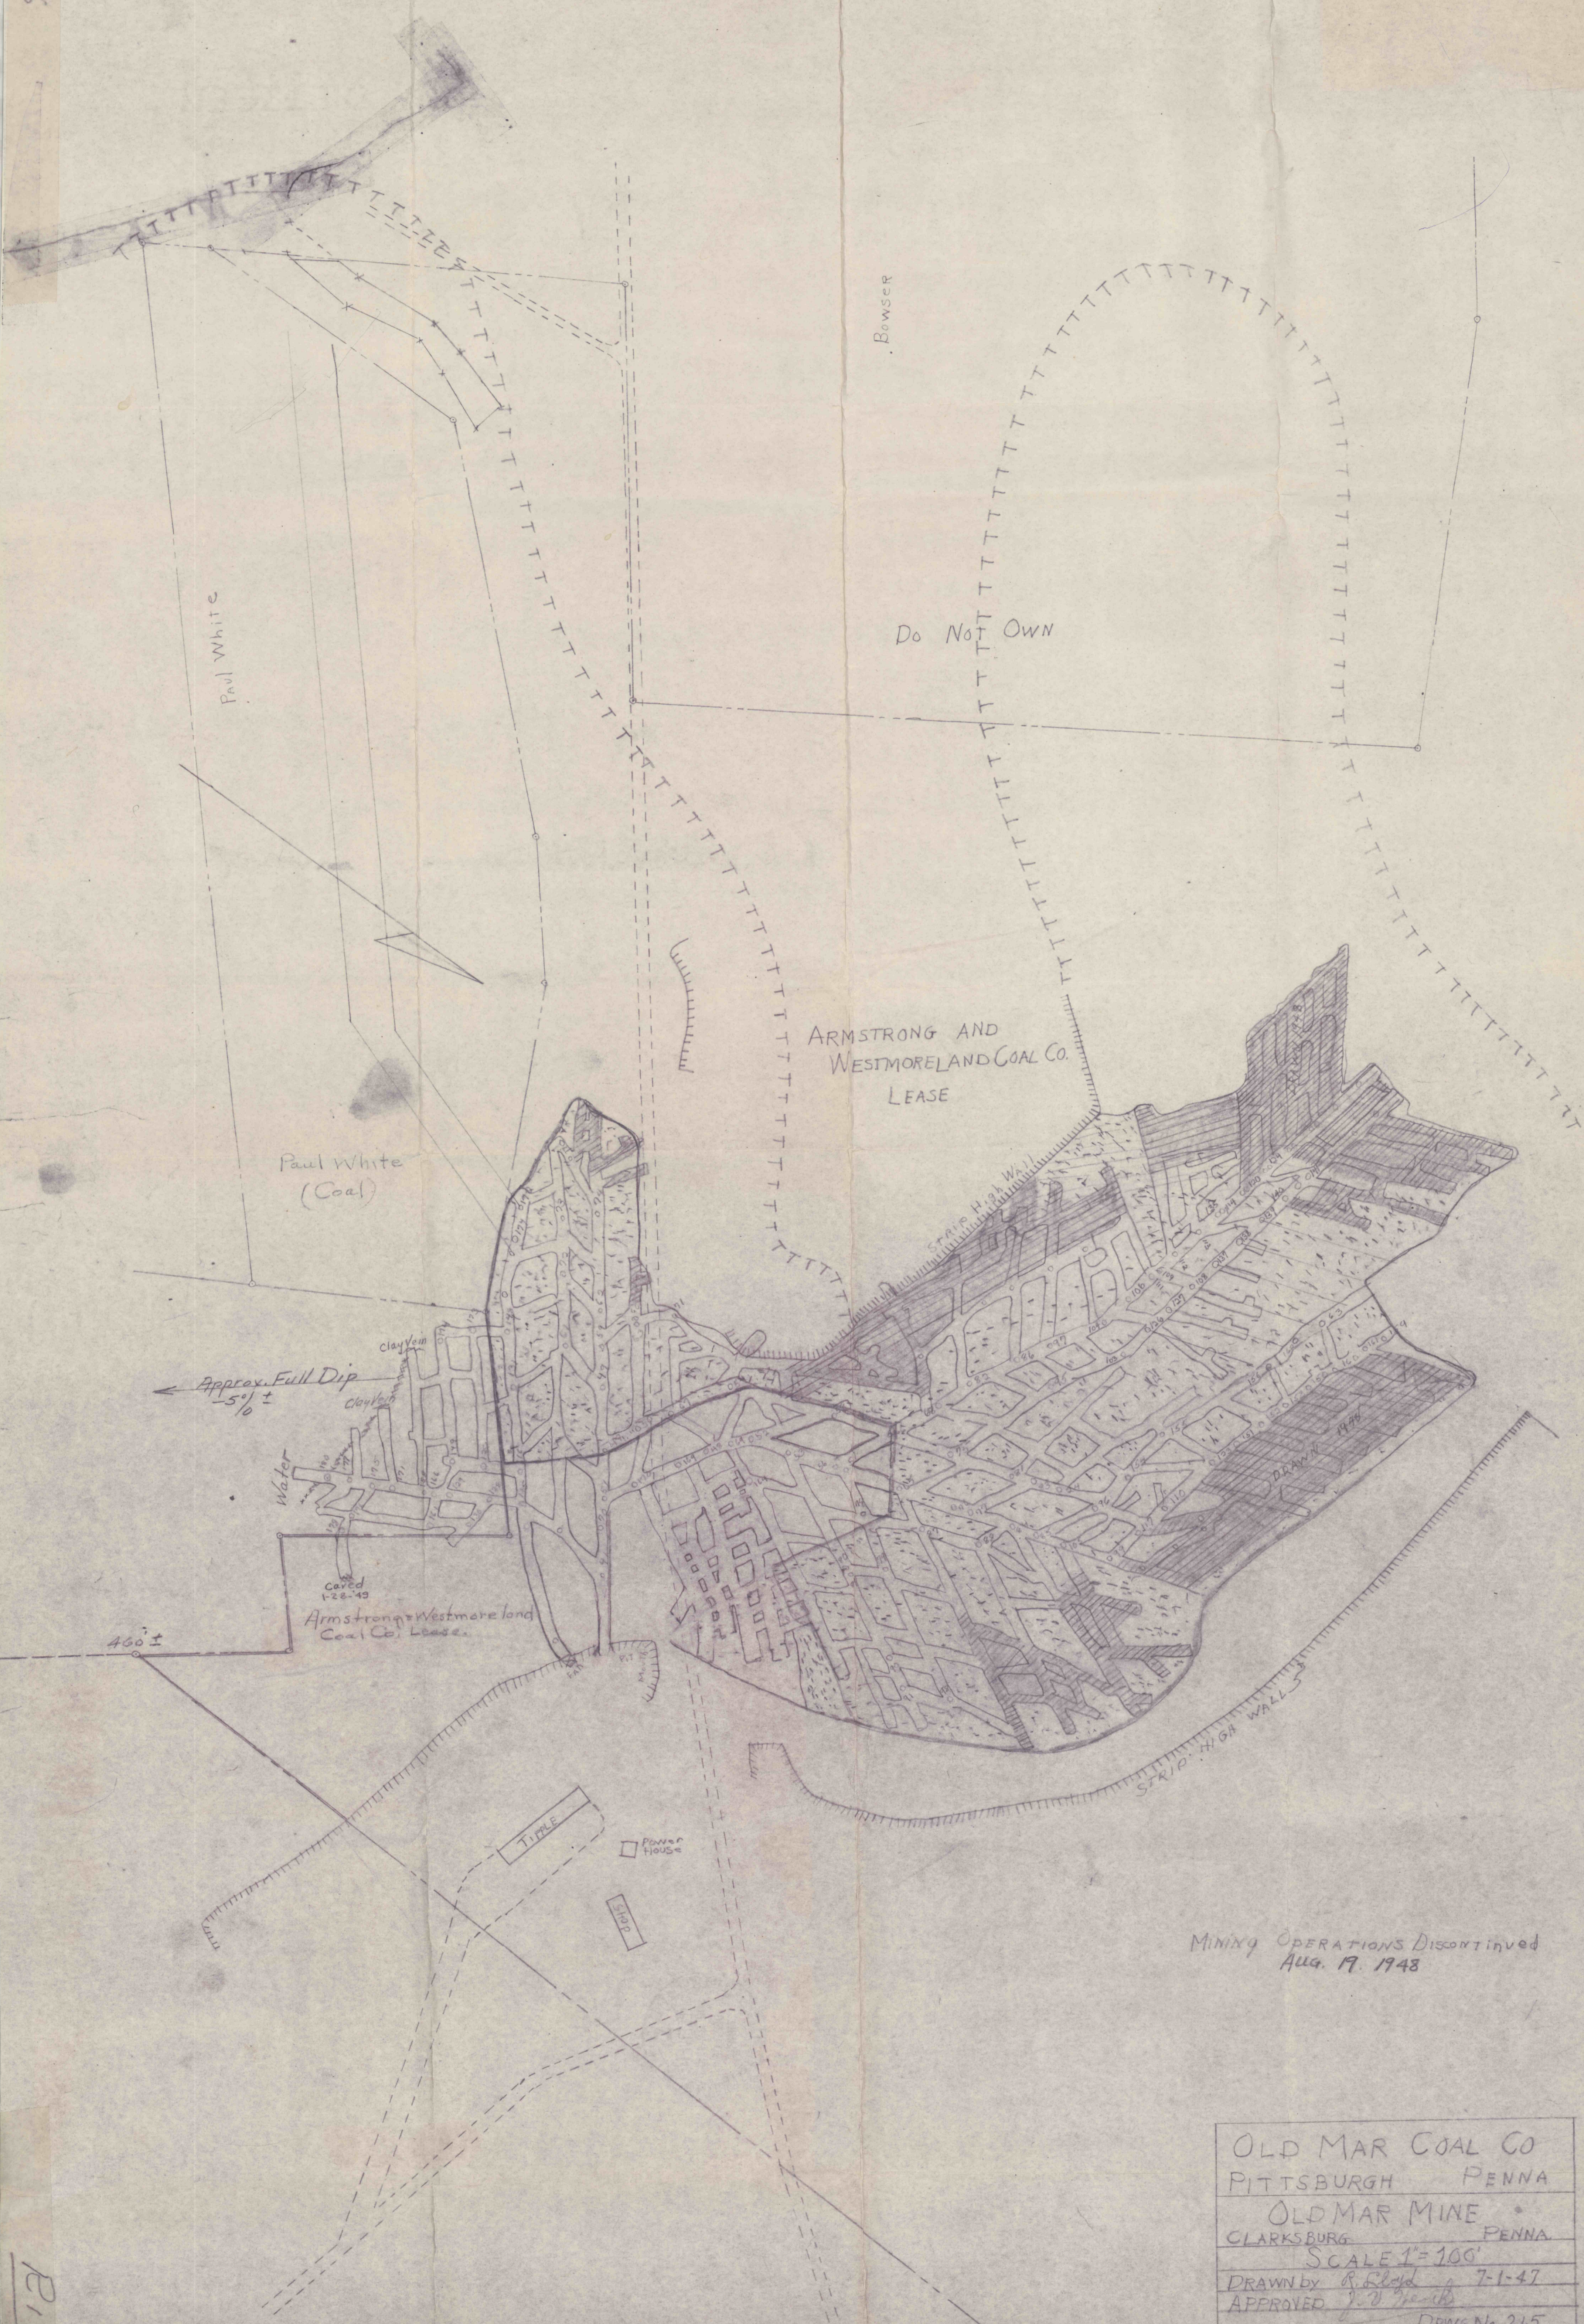

MINING OPERATIONS DISCONTINUED
Aug. 19, 1948

OLD MAR COAL CO
PITTSBURGH PENNA
OLD MAR MINE
CLARKSBURG PENNA
SCALE 1"=100'
DRAWN by J. D. [unclear] 7-1-47
APPROVED [unclear]
DRW No. 215

#1981
12-23-49
C.C.

Traced August 30, 1950
Office of Thomas Pector

P106