


1:10,000 250

# OLIPHANT PROPERTY

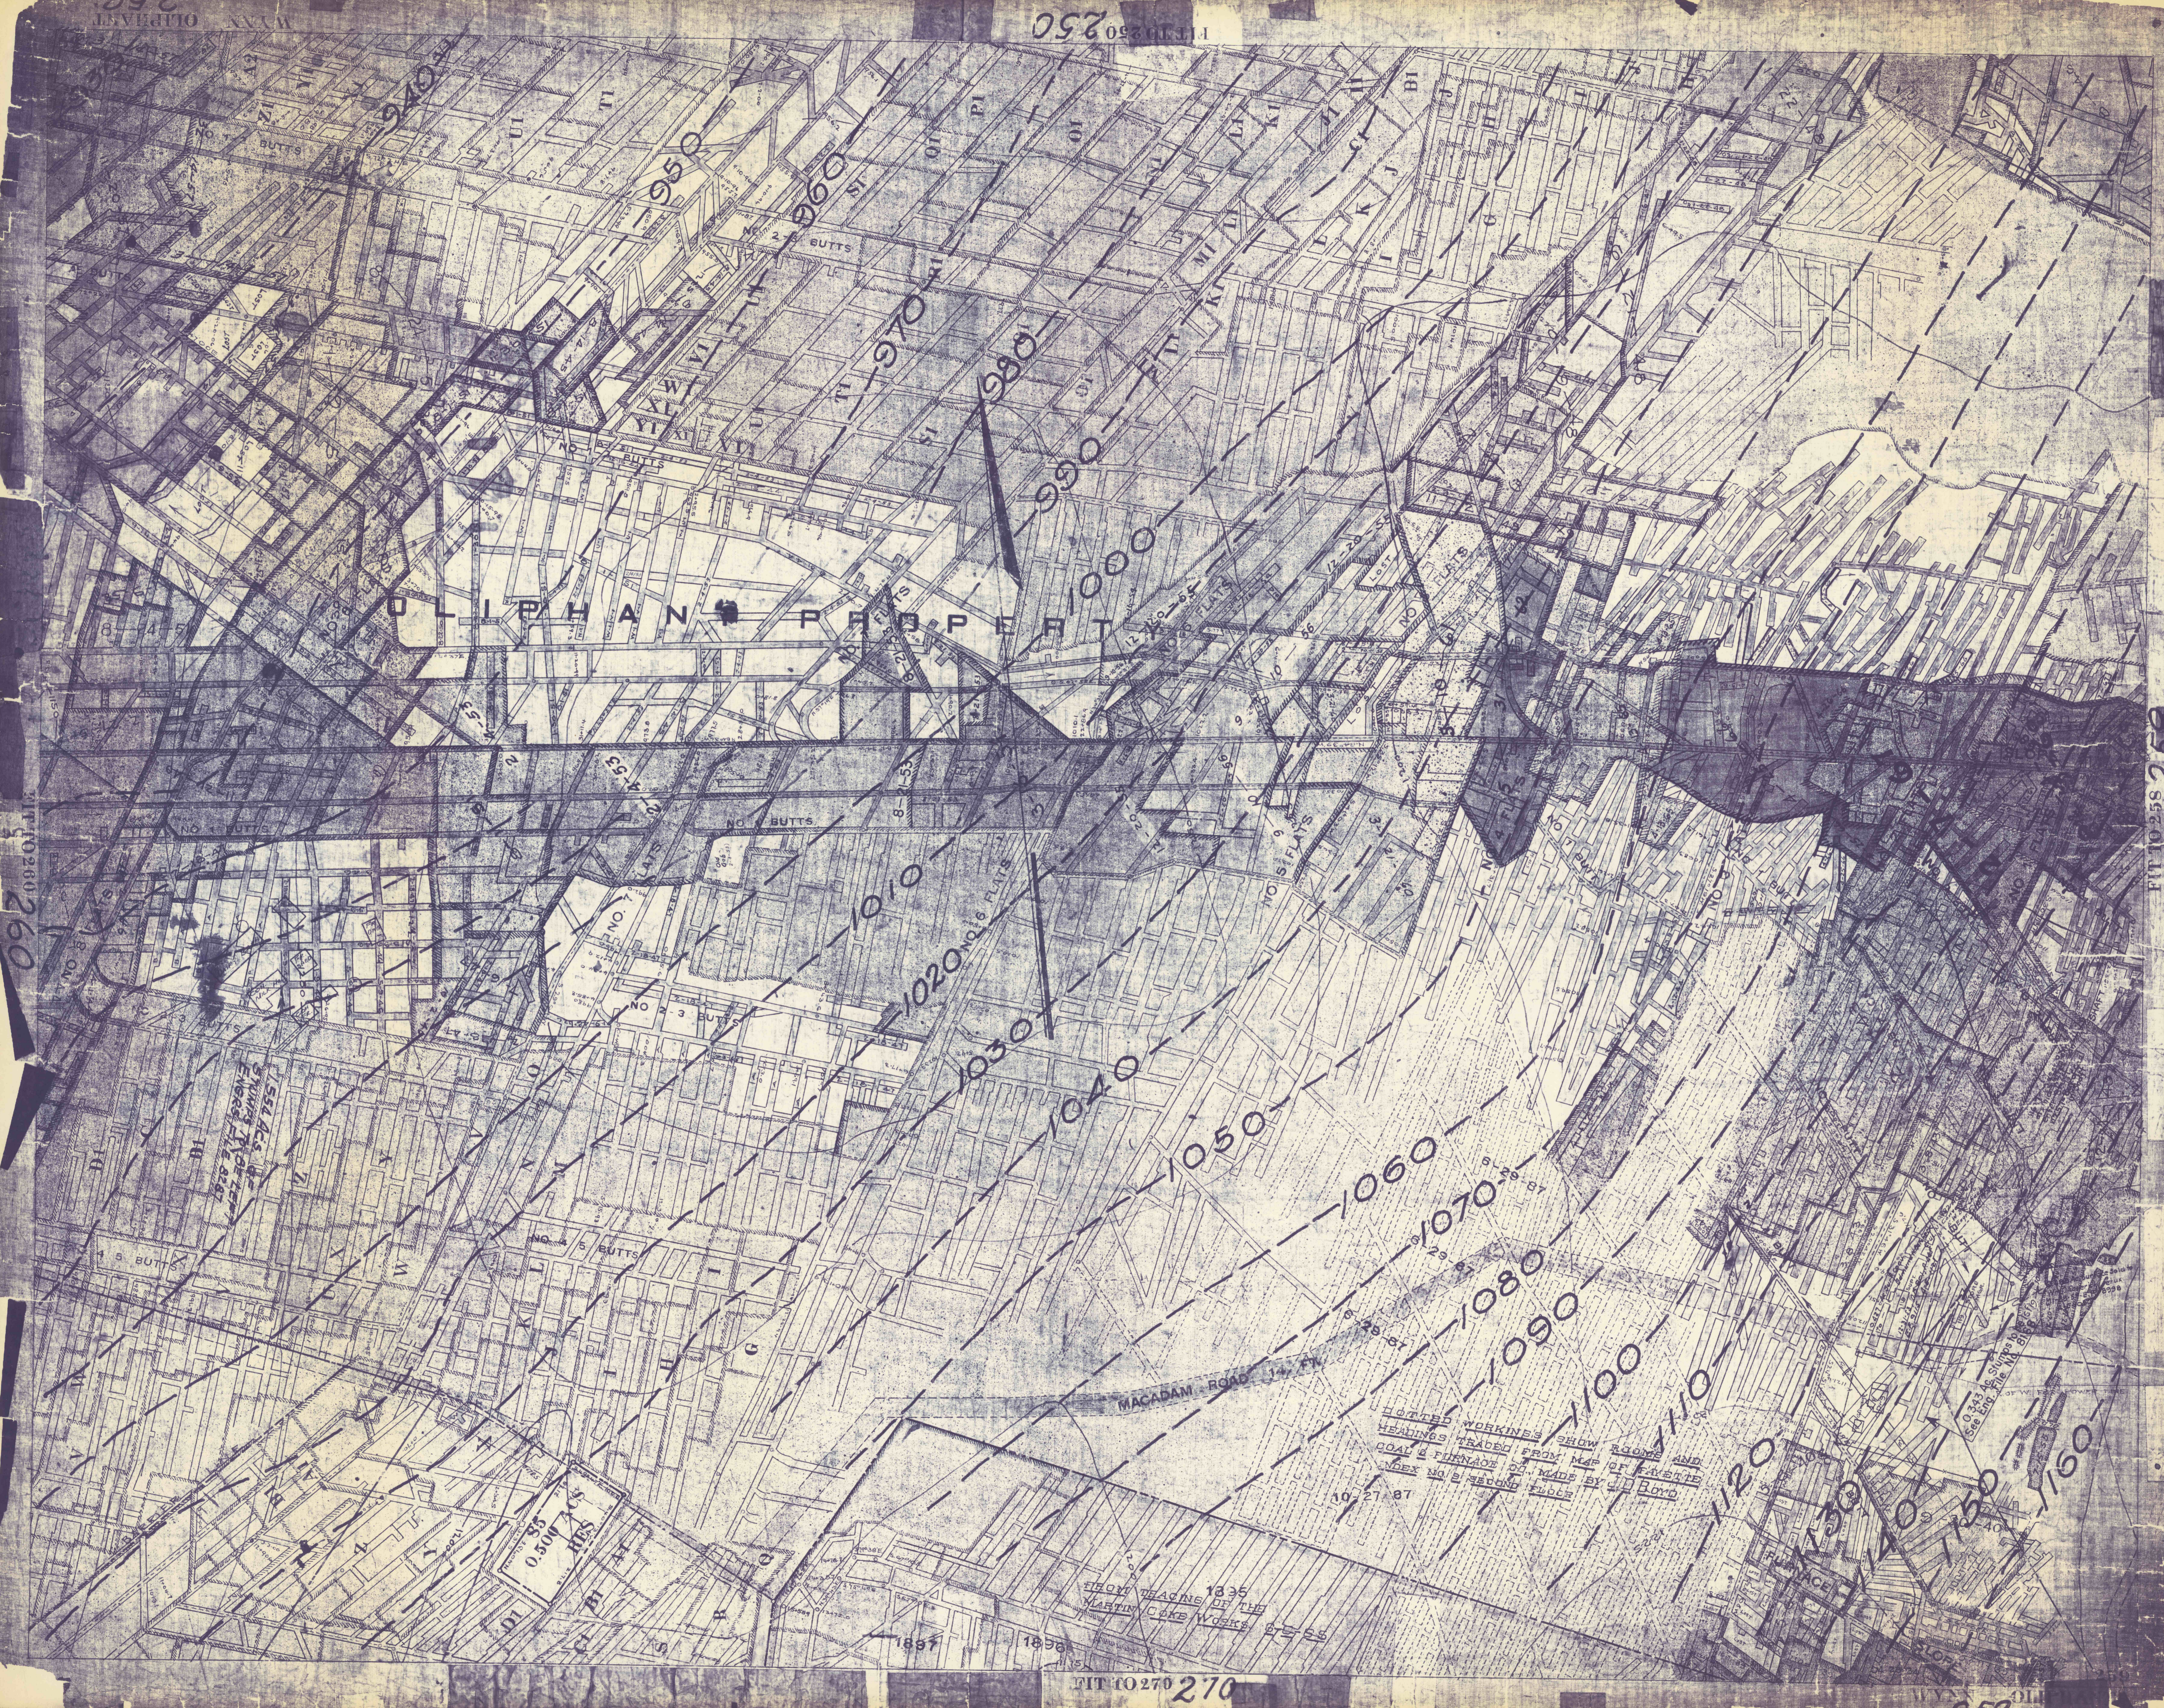

260

260

1552 A.C.S. 1897  

0.500  
1897

1070  
1080  
1090  
1100  
1110  
1120  
1130  
1140  
1150  
1160

1835  
1897  
1898  

270

250