





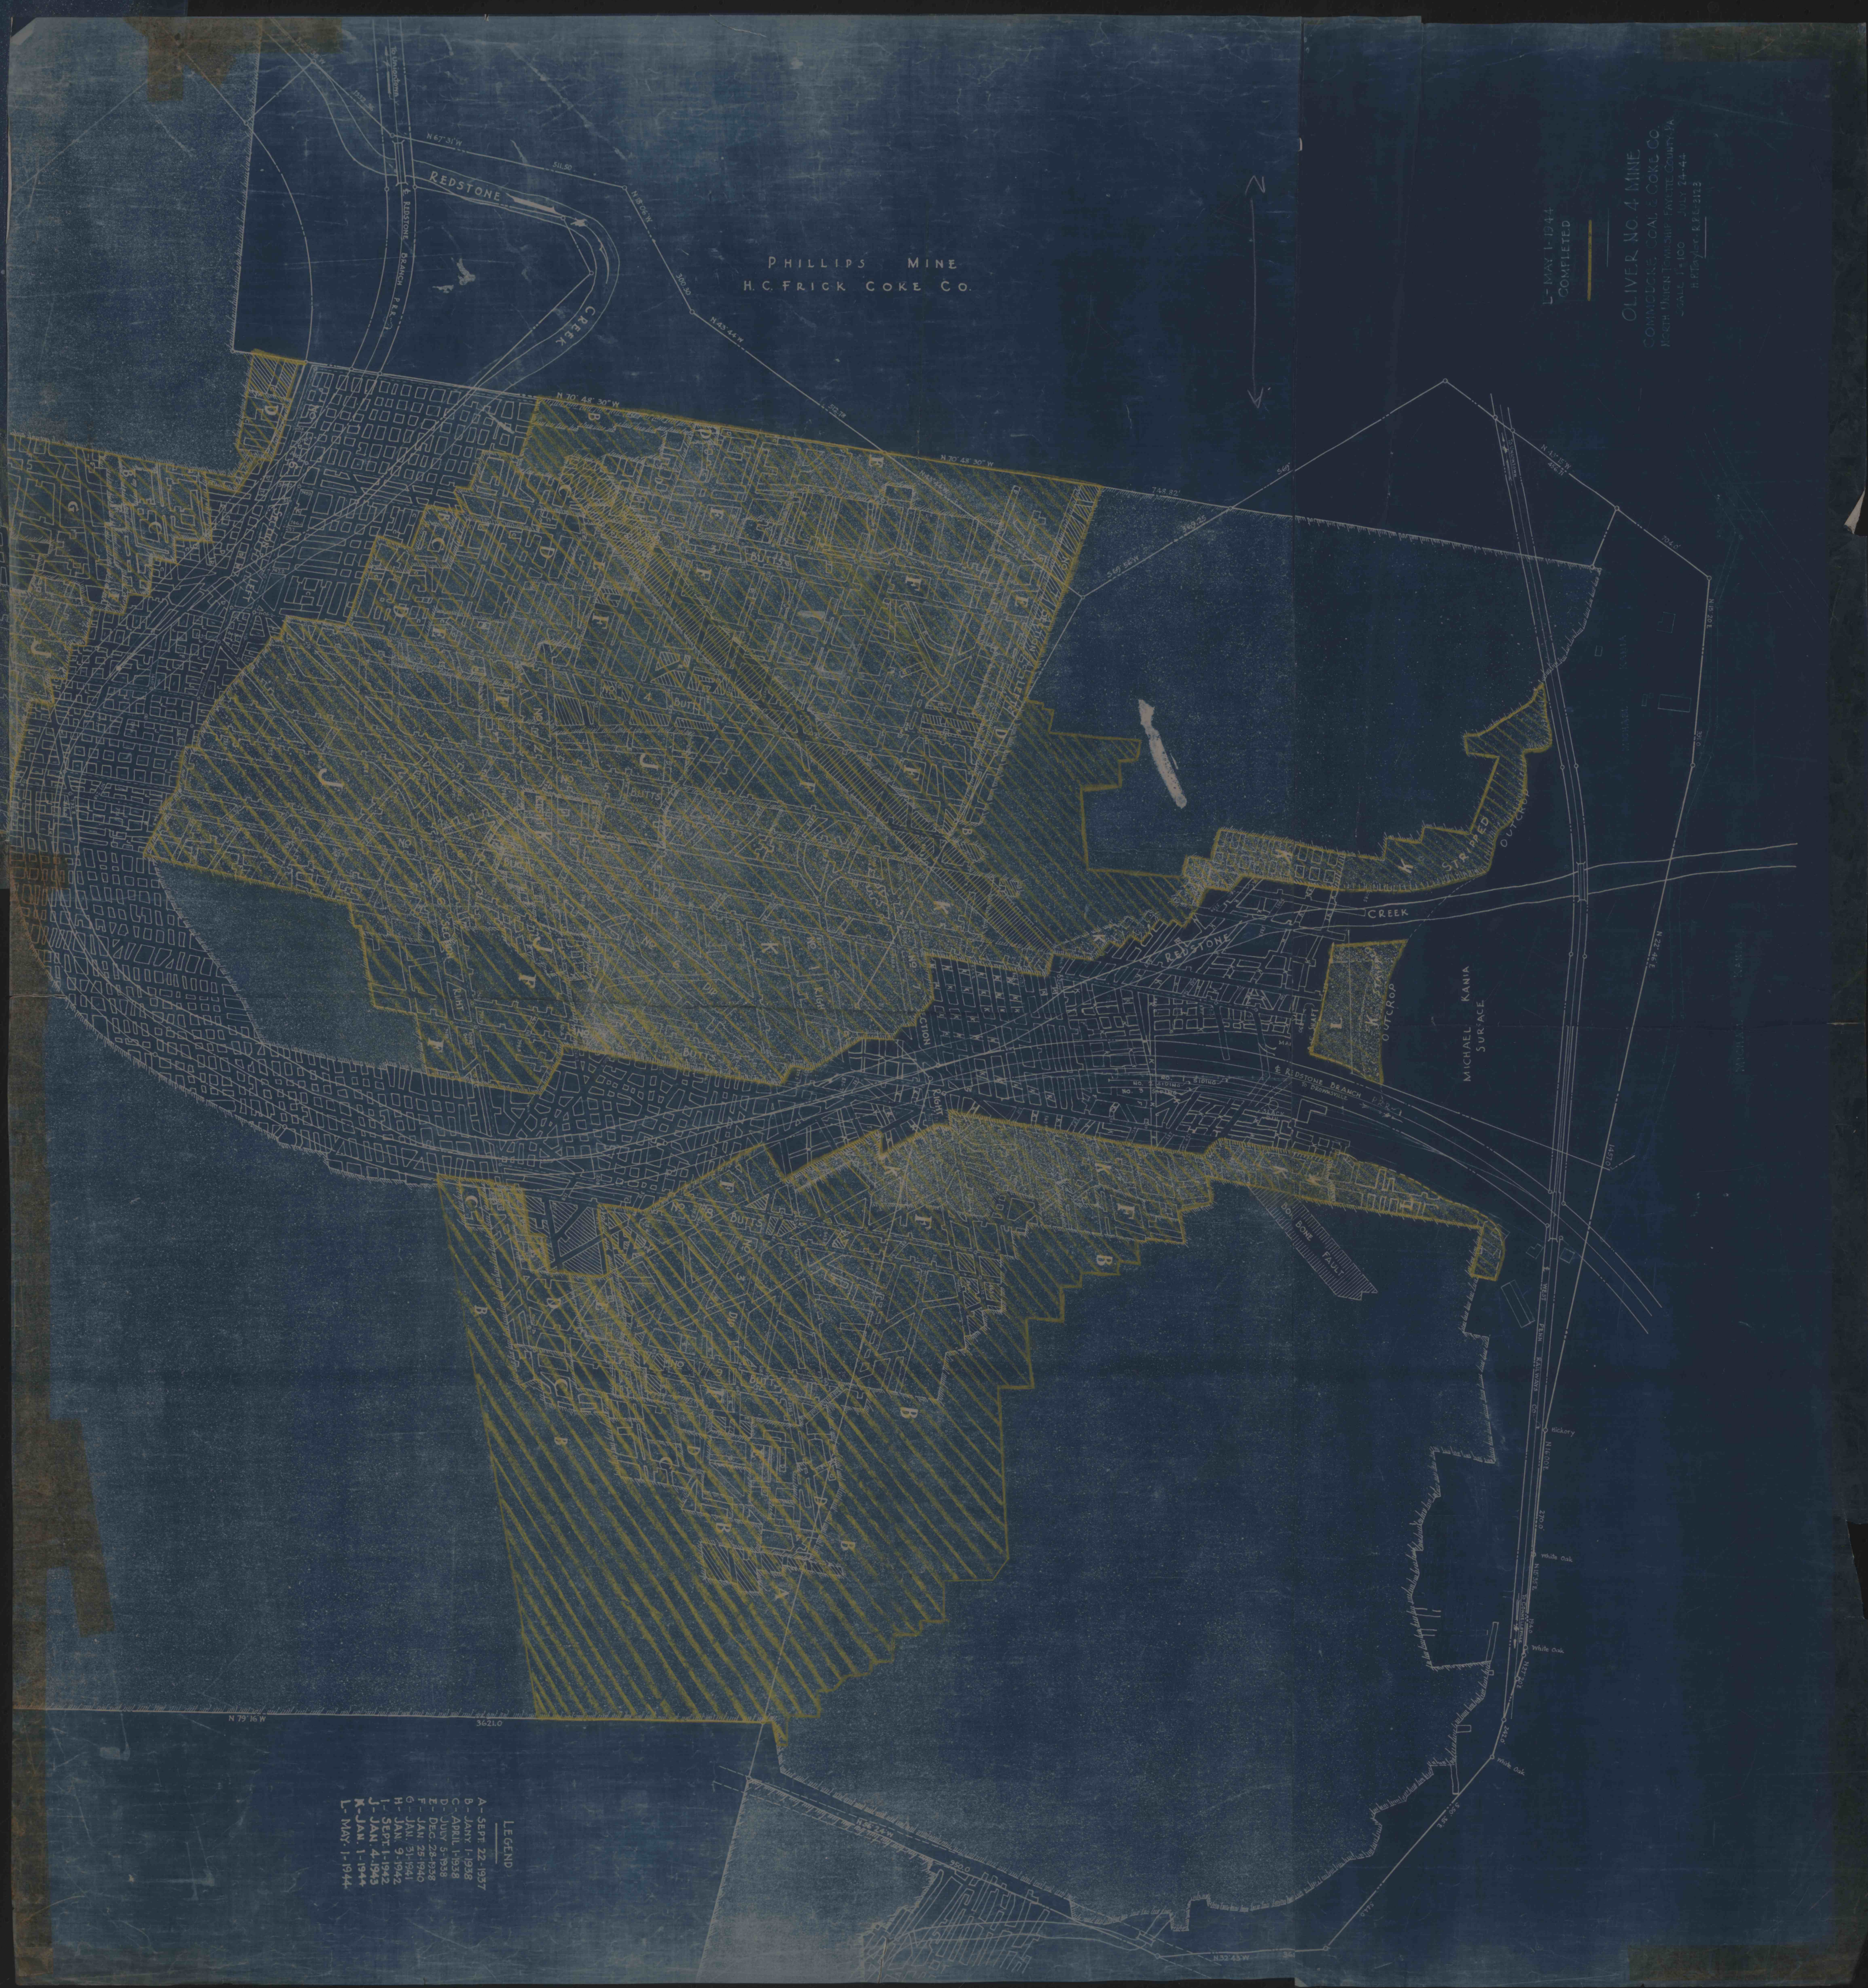

PHILLIPS MINE  
 H.C. FRICK COKE CO.

LEGEND  
 A - SEPT. 22, 1937  
 B - JAN. 1, 1938  
