



#1989
12-23-99
C.C.

JOHN REAMS (SURFACE)
P. C. & L. Co. (COAL)

GEORGE REAMS (SURFACE) 50 ACRES.
GRAMPIAN COAL CO. (COAL)

J.B. McENNALLY EST. (SURFACE)
GRAMPIAN COAL Co. (COAL)

LEWIS BLACK OAK COAL CO. (SURFACE)
FULTON EST. (COAL)

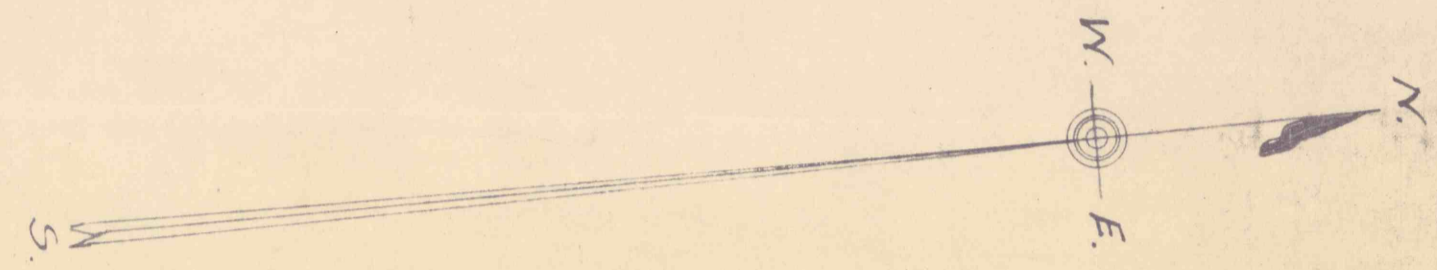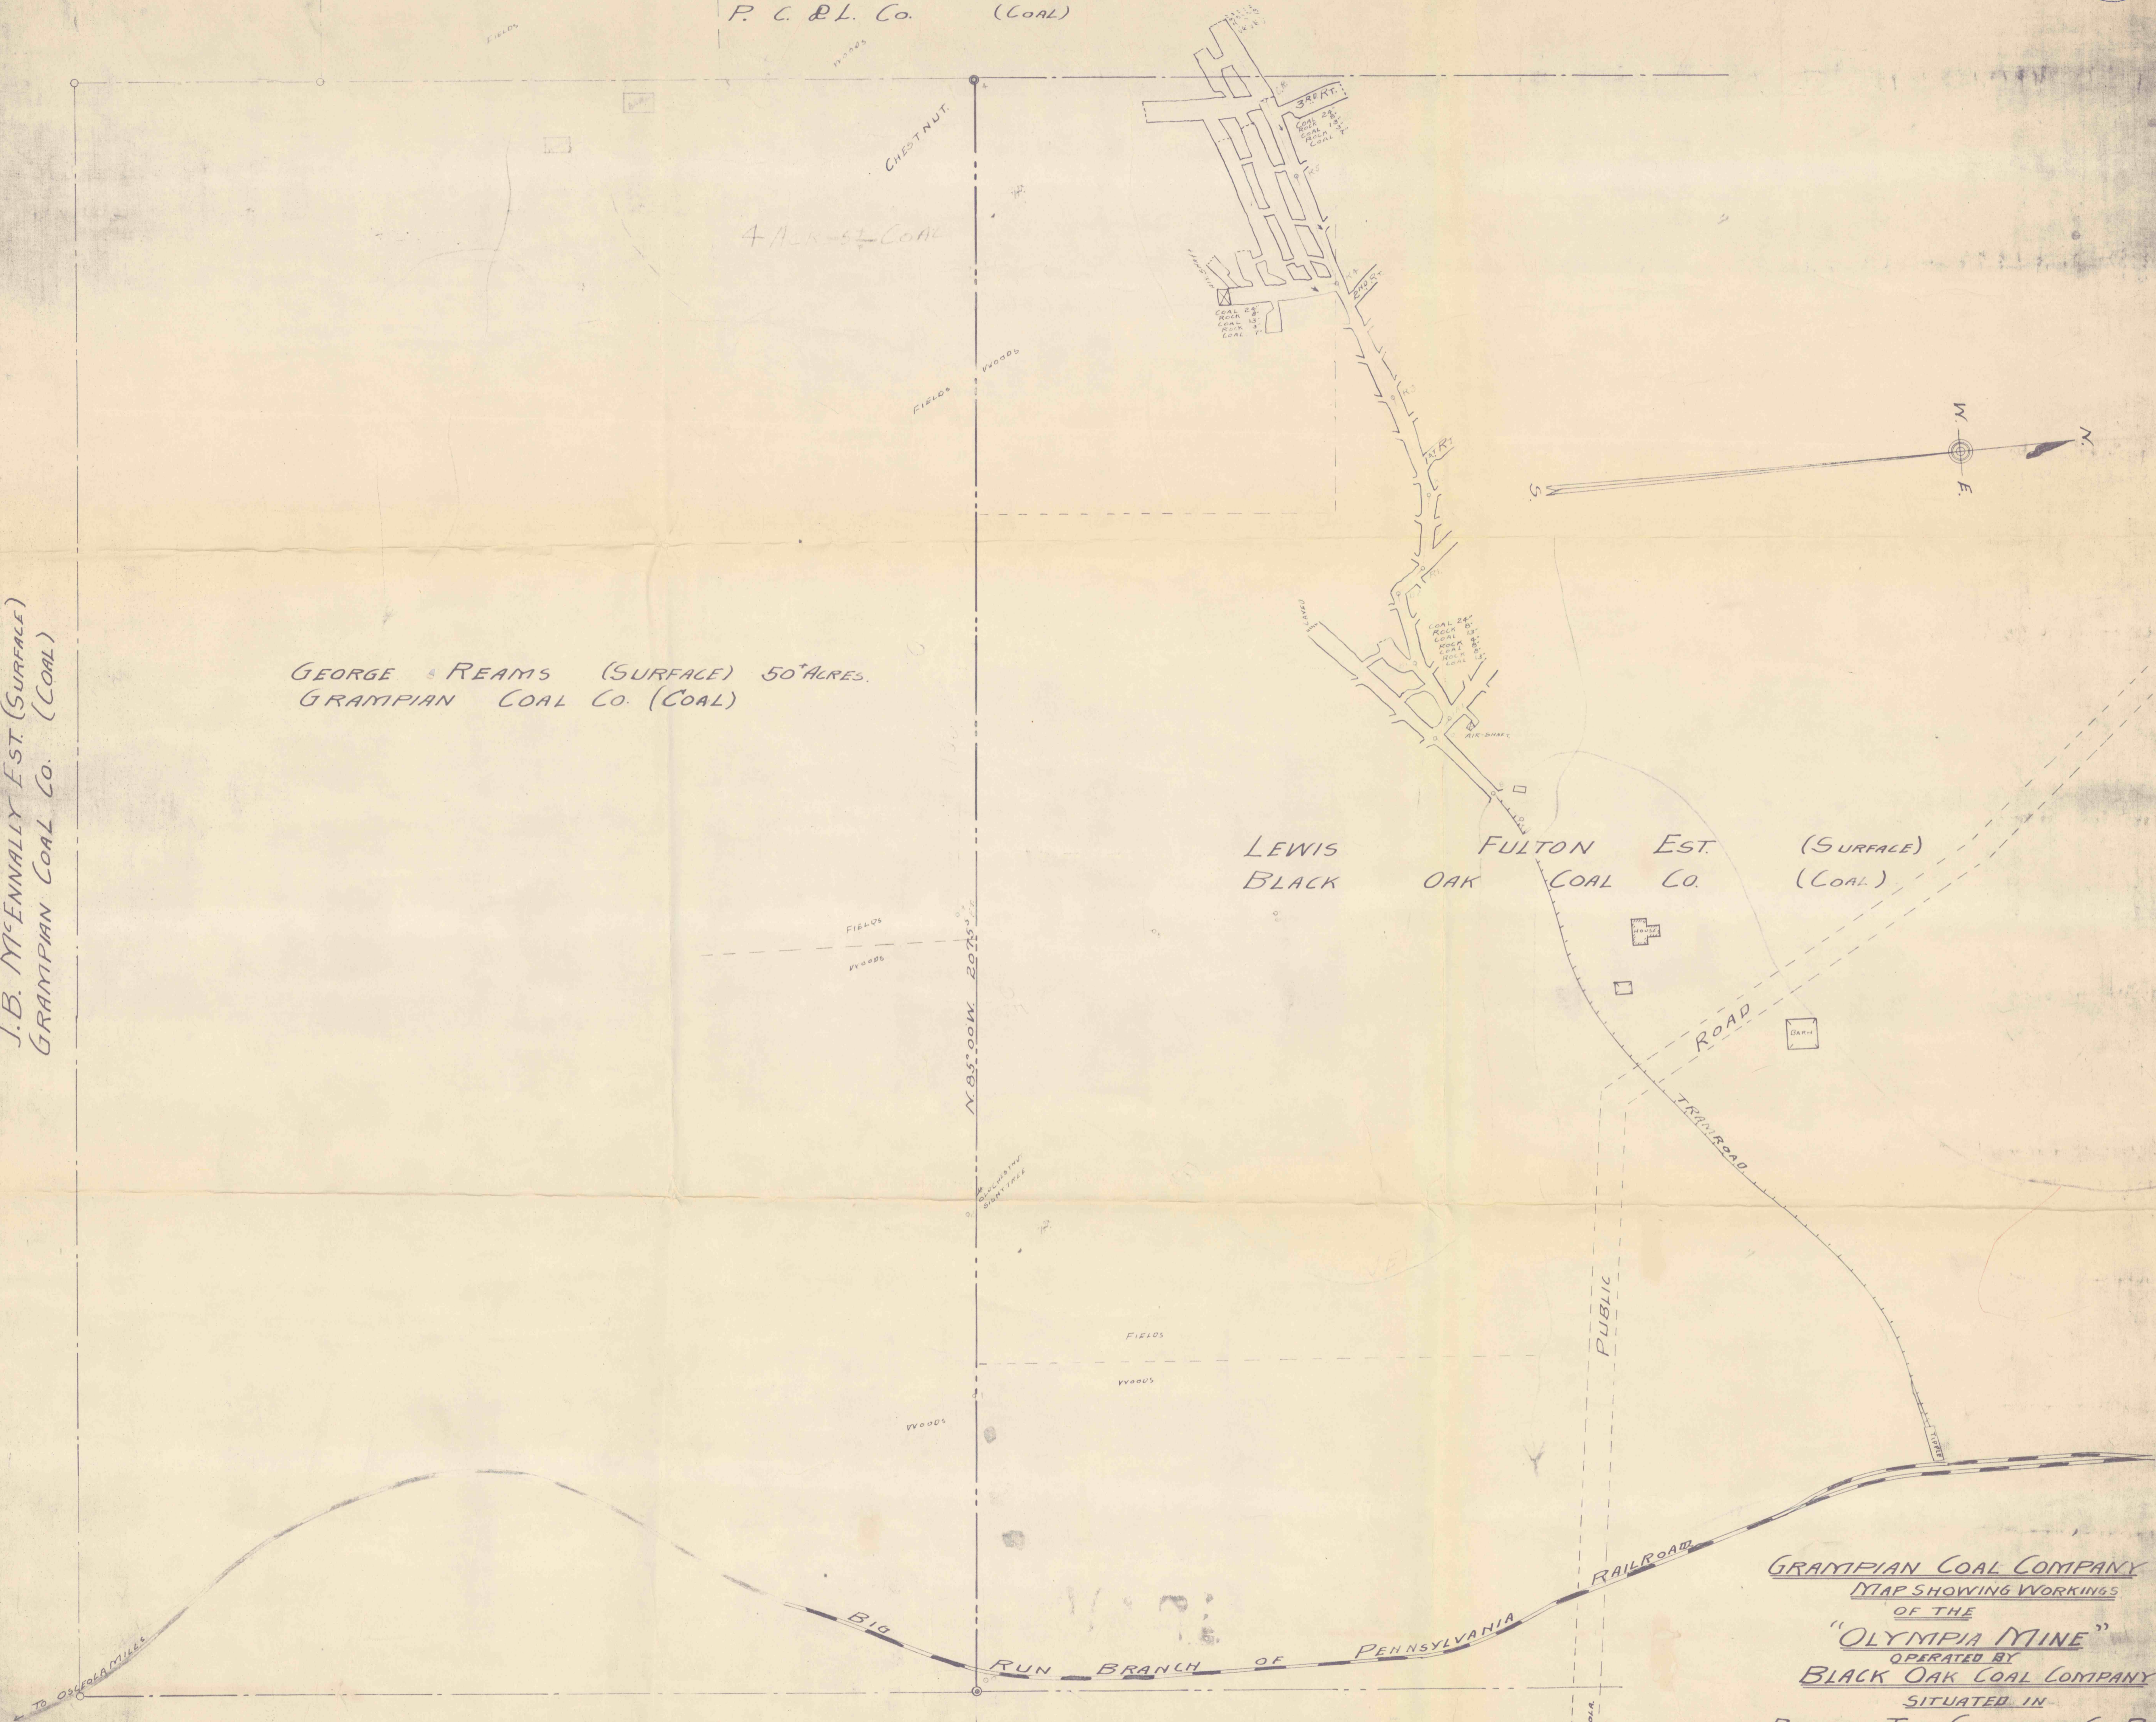

GRAMPIAN COAL COMPANY
MAP SHOWING WORKINGS
OF THE
"OLYMPIA MINE"
OPERATED BY
BLACK OAK COAL COMPANY
SITUATED IN
DECATUR TWP. CLEARFIELD CO. PA.
SCALE 1" = 100'

CLEARFIELD PA.
NOV. 26-1915.
RESURVEY - FEBY-6-1918
OFFICE OF E.W. HESS
ENGINEER.

HICKS KELLANDER

BIG RUN BRANCH OF PENNSYLVANIA RAILROAD

PUBLIC ROAD

ROAD

CHESTNUT

4 1/2 ACRES COAL

FIELDS WOODS

FIELDS WOODS

N 85° 00' W 2075' 1/2"

WOODS

FIELDS WOODS

TO OSCEOLA MILLS

TO WALLEGA