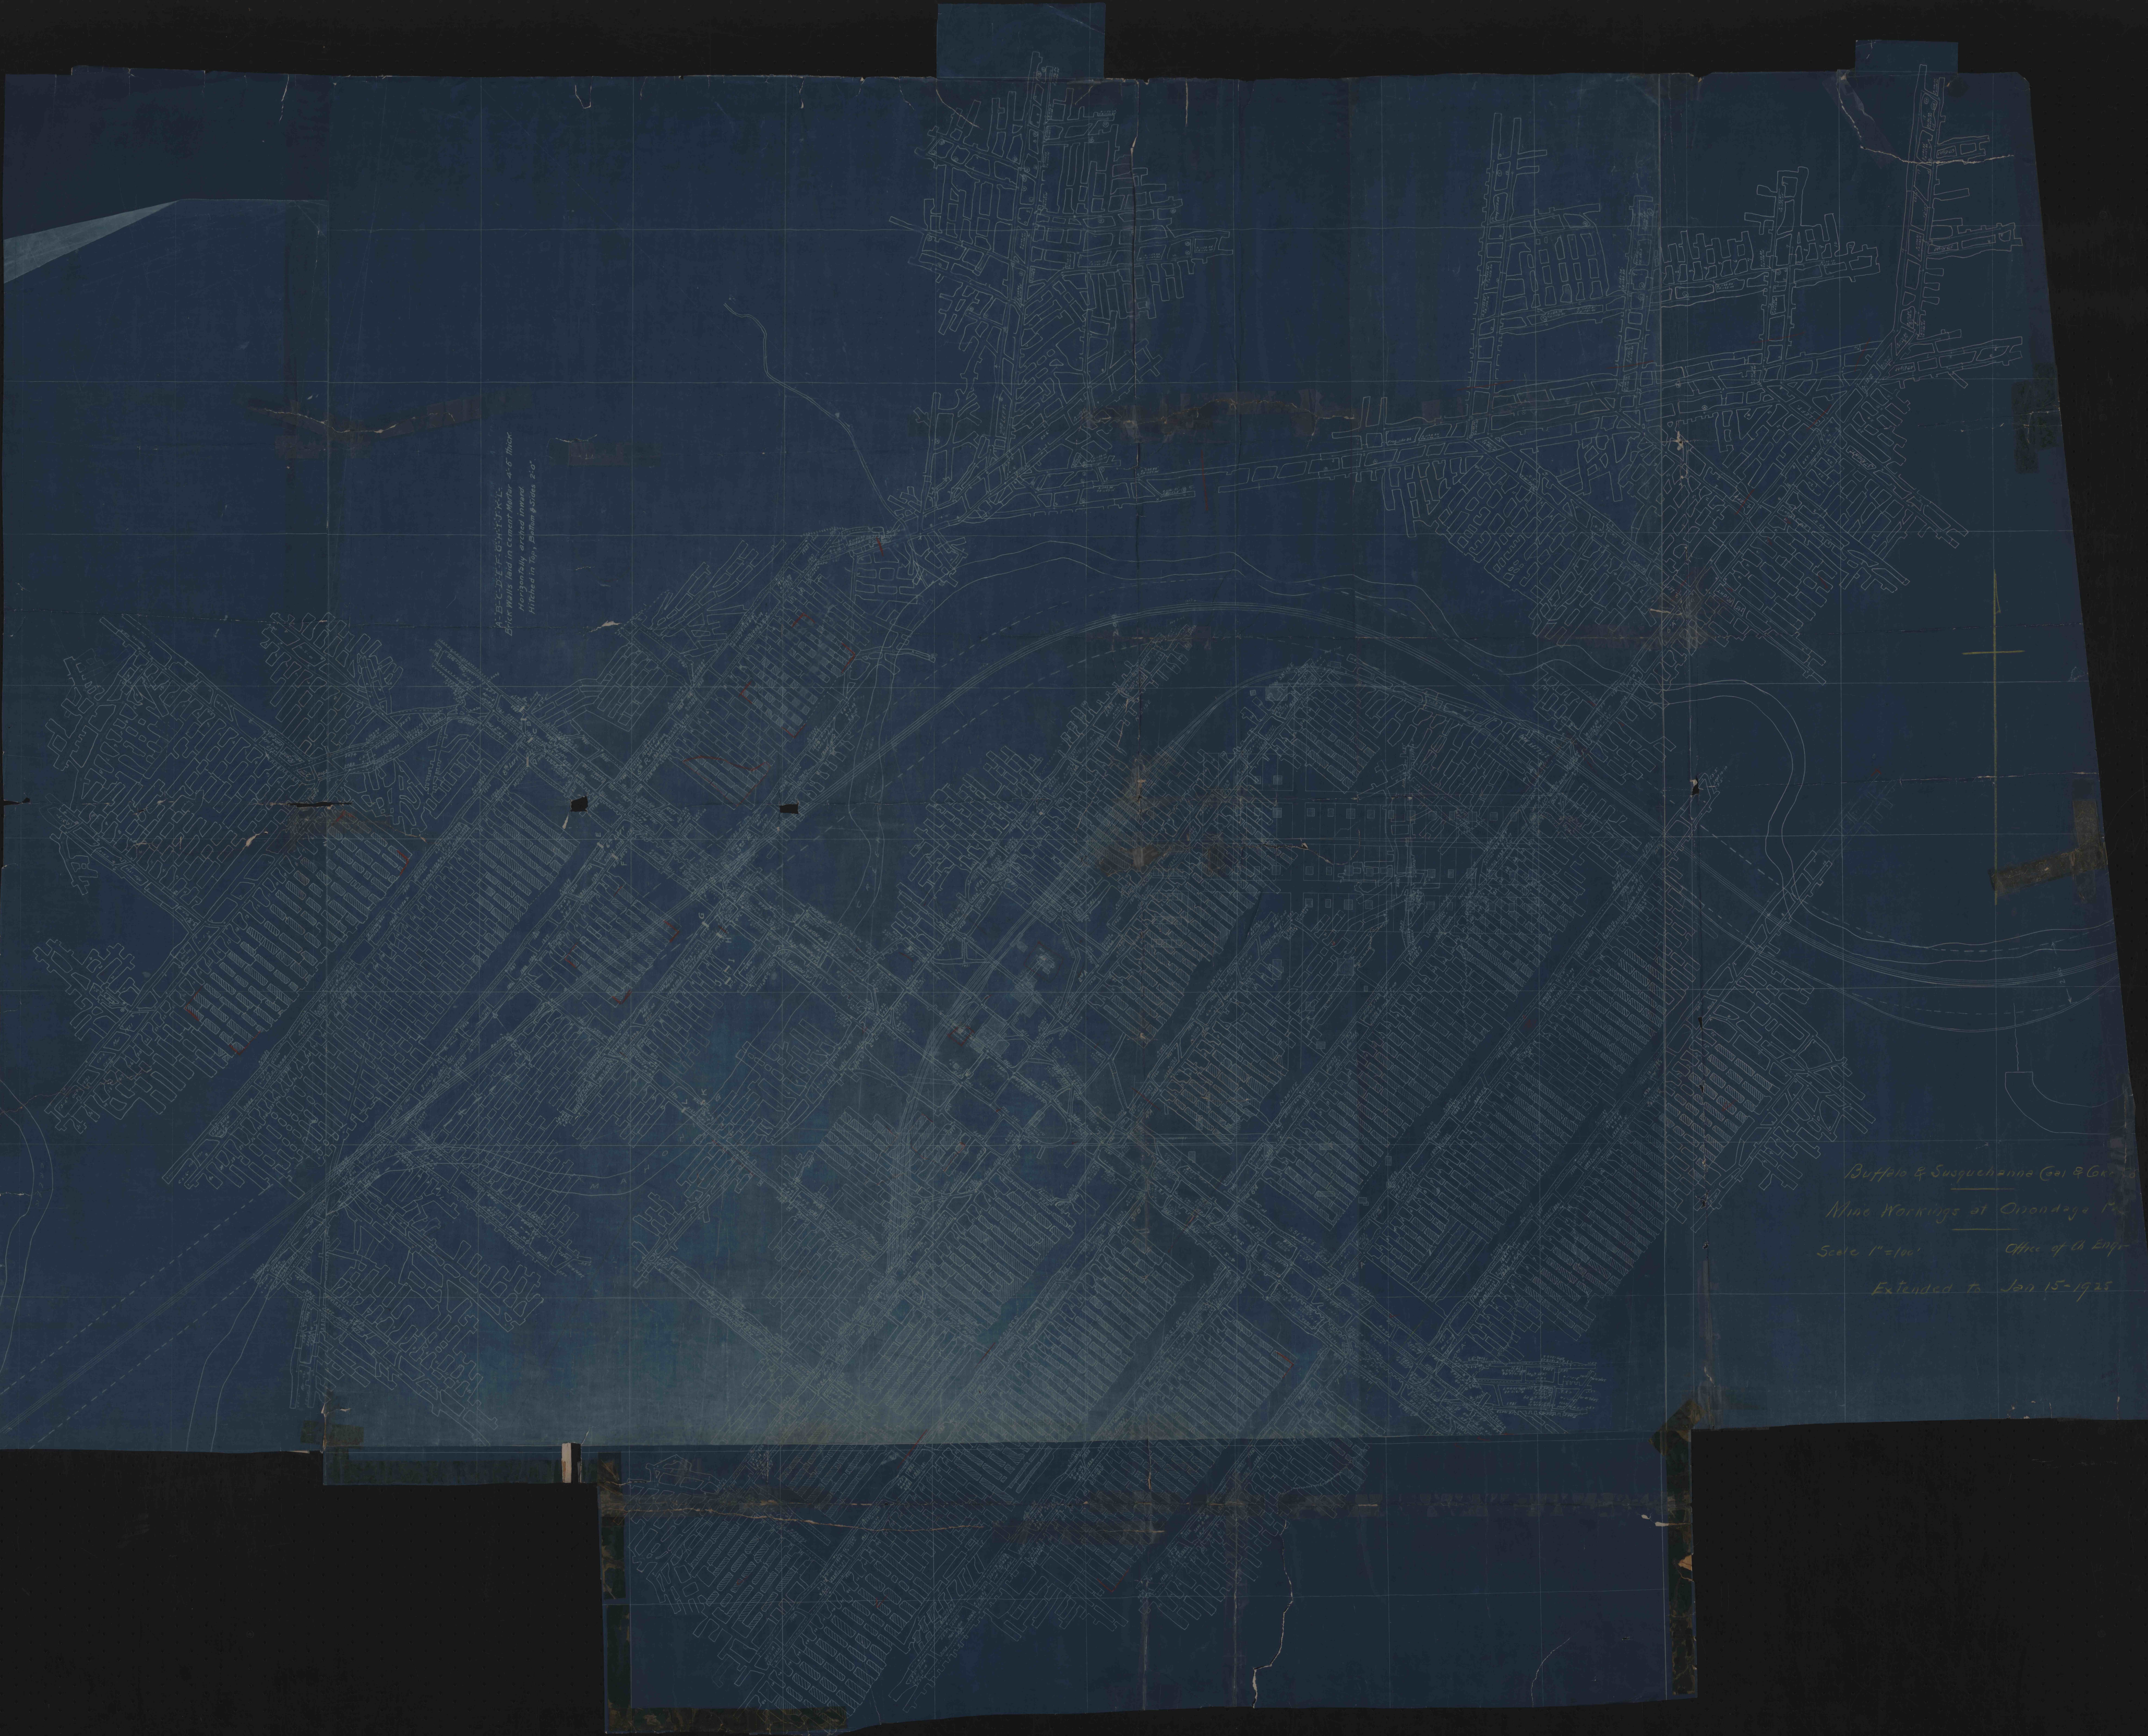
A-B-C-D-E-F-G-H-I-J-K-L-
Brick Walls laid in Cement Mortar 4'-6" Thick
Horizontally arched inward
Hitched in Top, Bottom & Sides 2'-0"
Buffalo & Susquehanna Coal & Coke
Mine Workings at Onondaga P
Scale 1" = 100'
Office of Ch Engr
Extended to Jan 15-1925