


P C & L CO

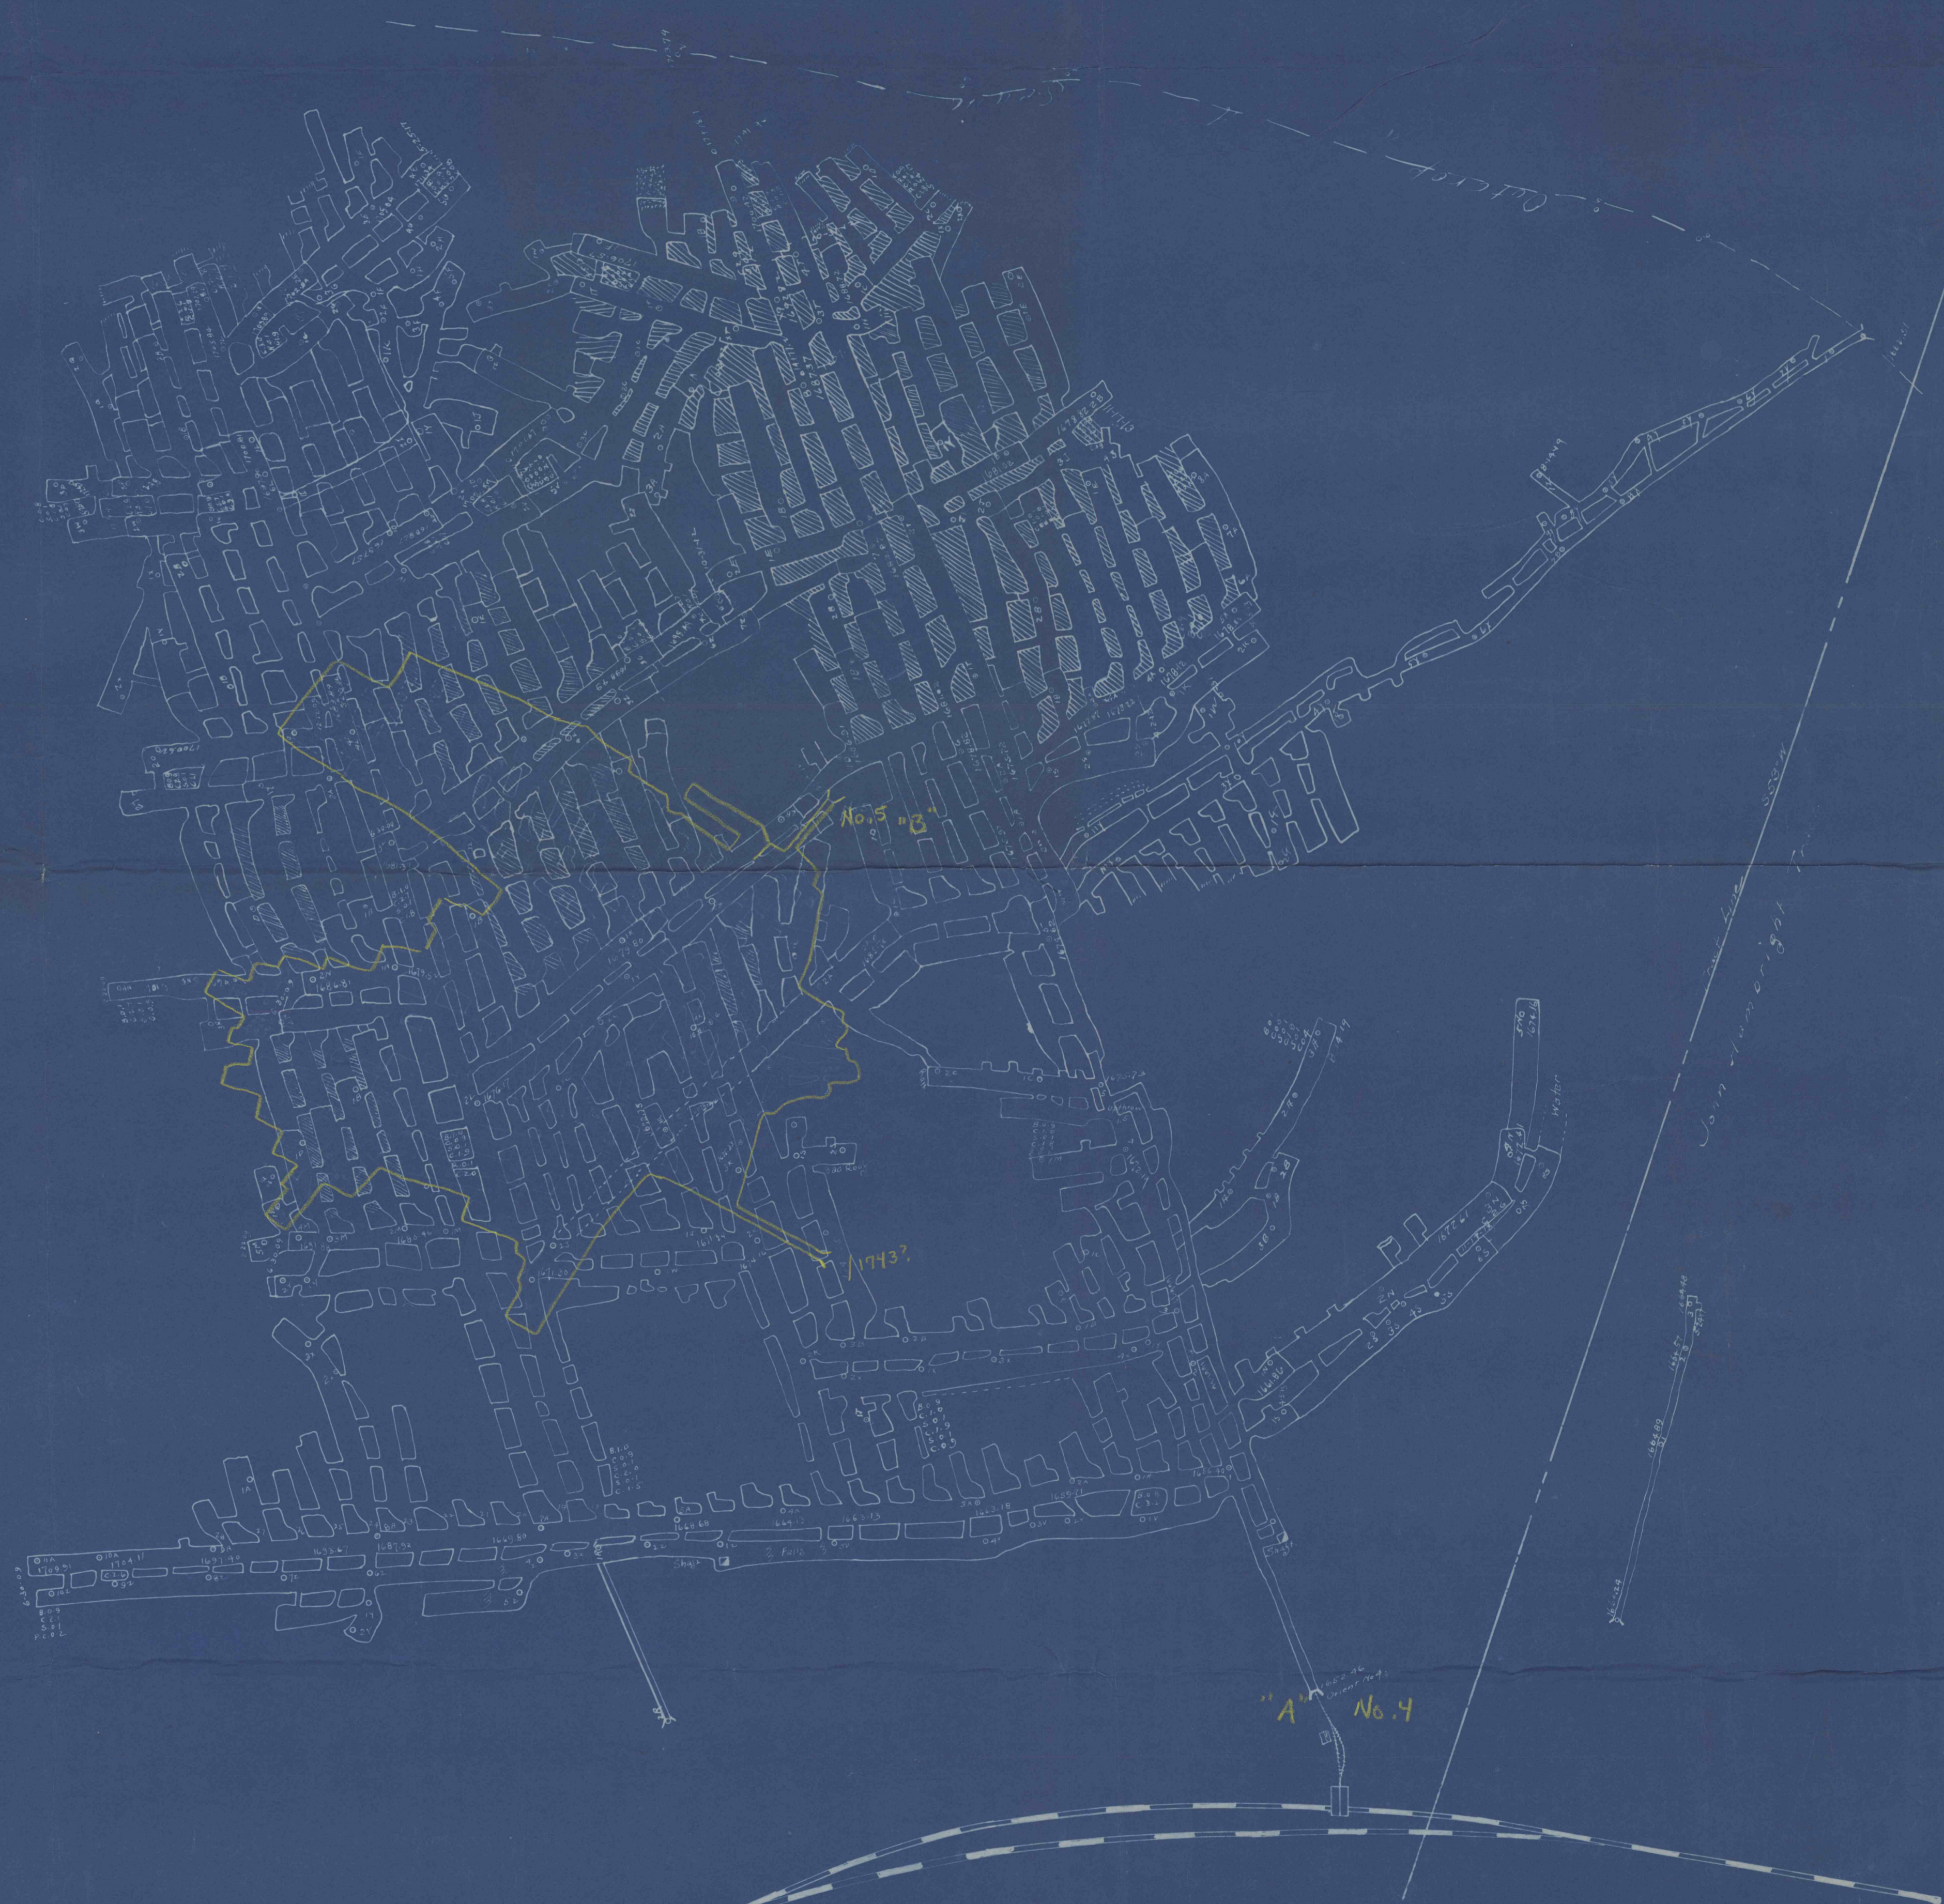

MAP OF  
ORIENT MINE NO 4  
OPERATED BY  
BLAIR BROS. COAL CO  
POMELTON, CENTRE CO. PENN.  
Scale 1 in. = 100 feet  
Wamsler & Dunlap  
Mining Engineers.

Notes: 119-265  
Dime Top D 20  
Tracing H 13  
C. W. 230. J. C. Stone E. P. Dunlap 11/14