


#2009
12.27.99
C.C

CONTEMPLATED MINING 3-15-74 TO 9-15-74

NOTE: NO MINING 3-31-71 TO 9-30-71 AND 3-31-72 TO 9-30-72 AND 3-15-73 TO 9-15-73

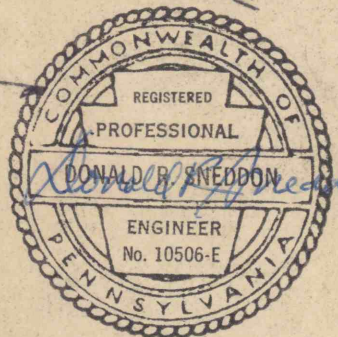

FINAL MAP

ORISIK COAL MINE
SOUTH HUNTINGDON TWP.
WESTMORELAND CO., PA.
SCALE 1"=100' 3-6-69