

P. P. & K.

H. H. Owens

A. O. Tate Est.



D. E. Bloom Tract
Coal - Ray Walker

OWENS #1
E Seam
1400 ±

Contemplated Mining 10 Acres
Feb. 27, 1968 to Aug. 27, 1968

Harvey Rowles

ELENSKY BROTHERS
DEEP MINE MAP
LAWRENCE TWP., CLEARFIELD CO., PA.
SCALE - 1 inch = 100 feet
SEPTEMBER 13, 1966 JOHN W. HESS
CLEARFIELD, PA. ENGINEER

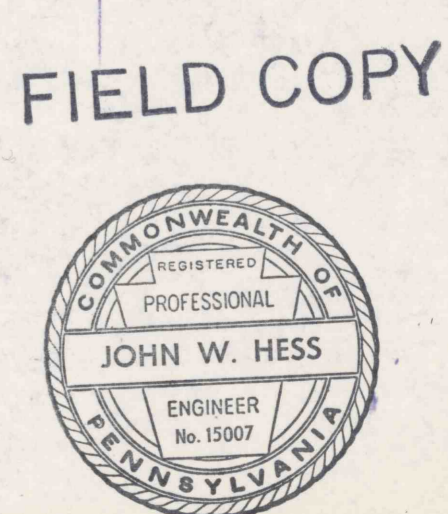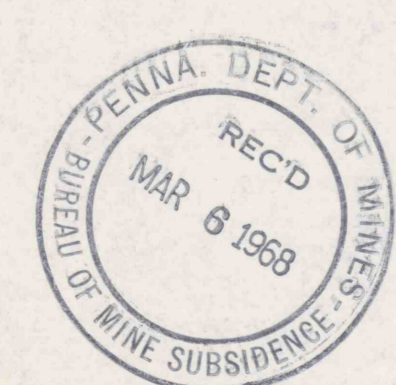

Subsidence Permit # 62-1

Mine Works to date 9/20/67 RST.
Mine Works to date 10/24/66 RST.
Mine Works to date 3/5/66 RST.
Revisions

#2013
12-23-68