


FIT TO K 570

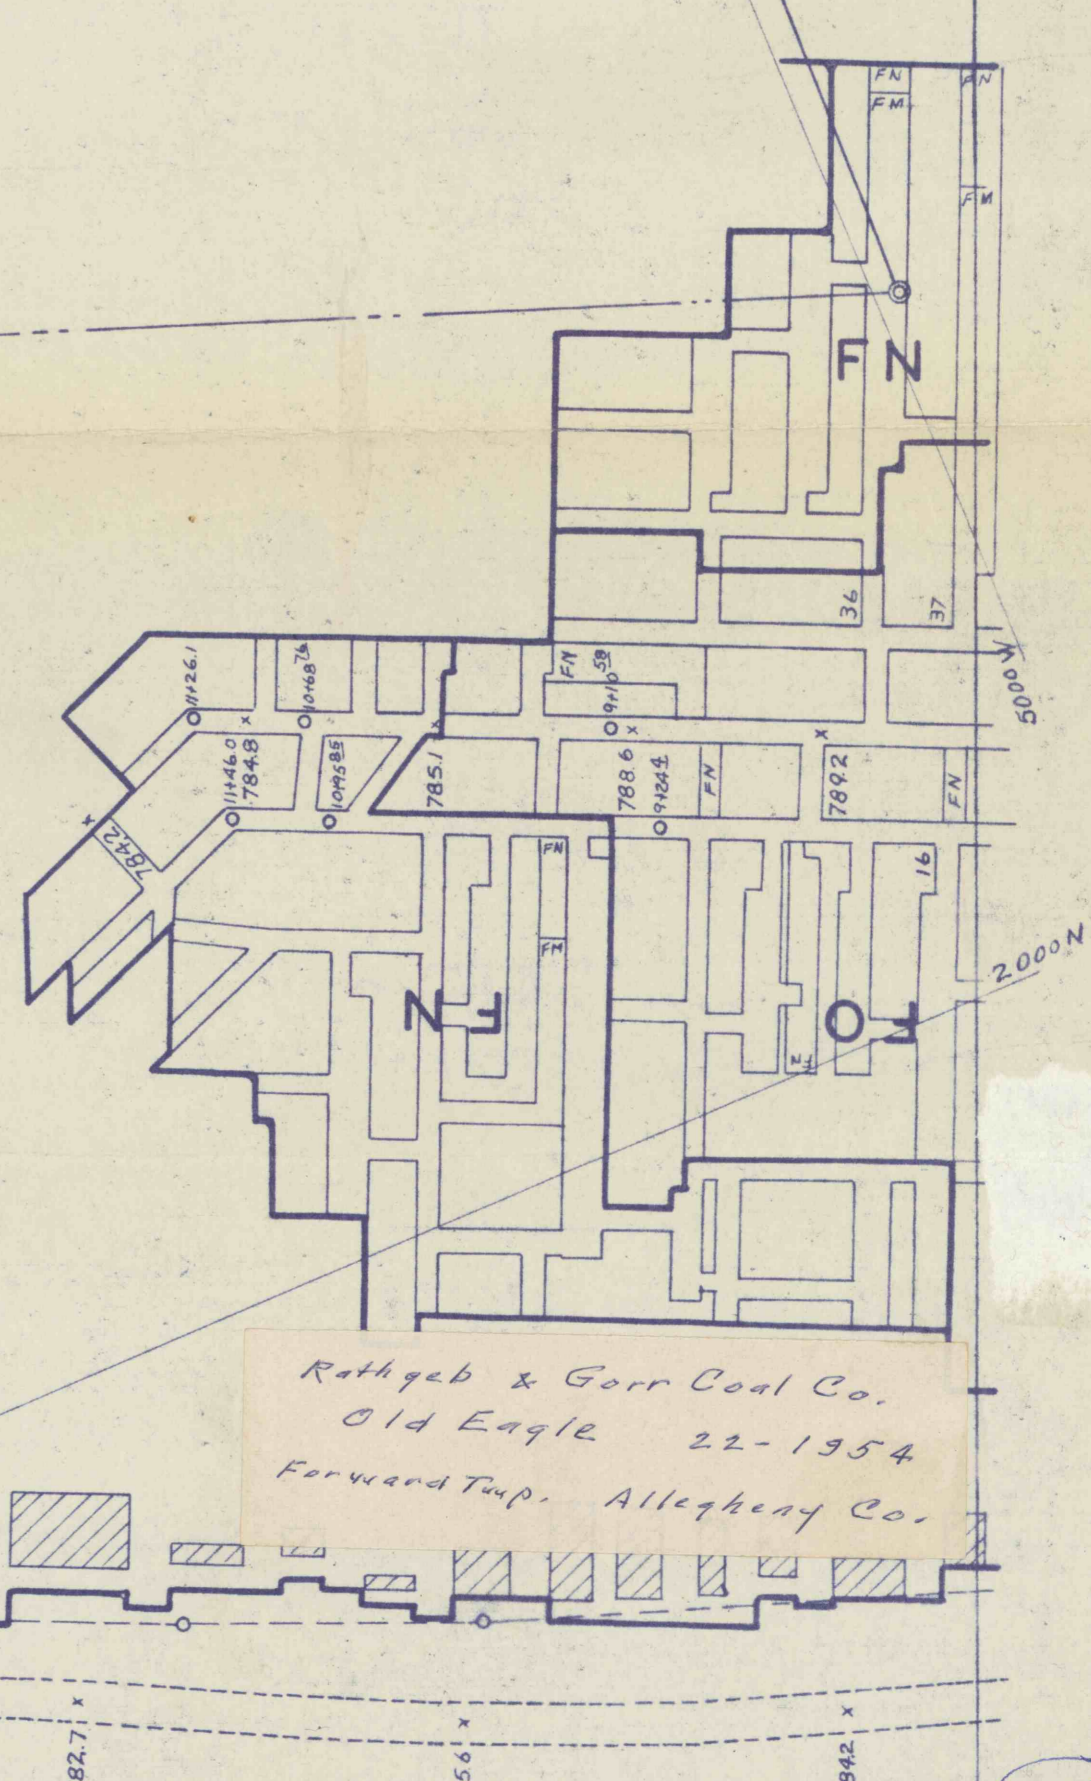

1870
12-11
C.C.