


ELDER TRACT 220 A's
GAUTZEN TWP CAMBRIA CO.

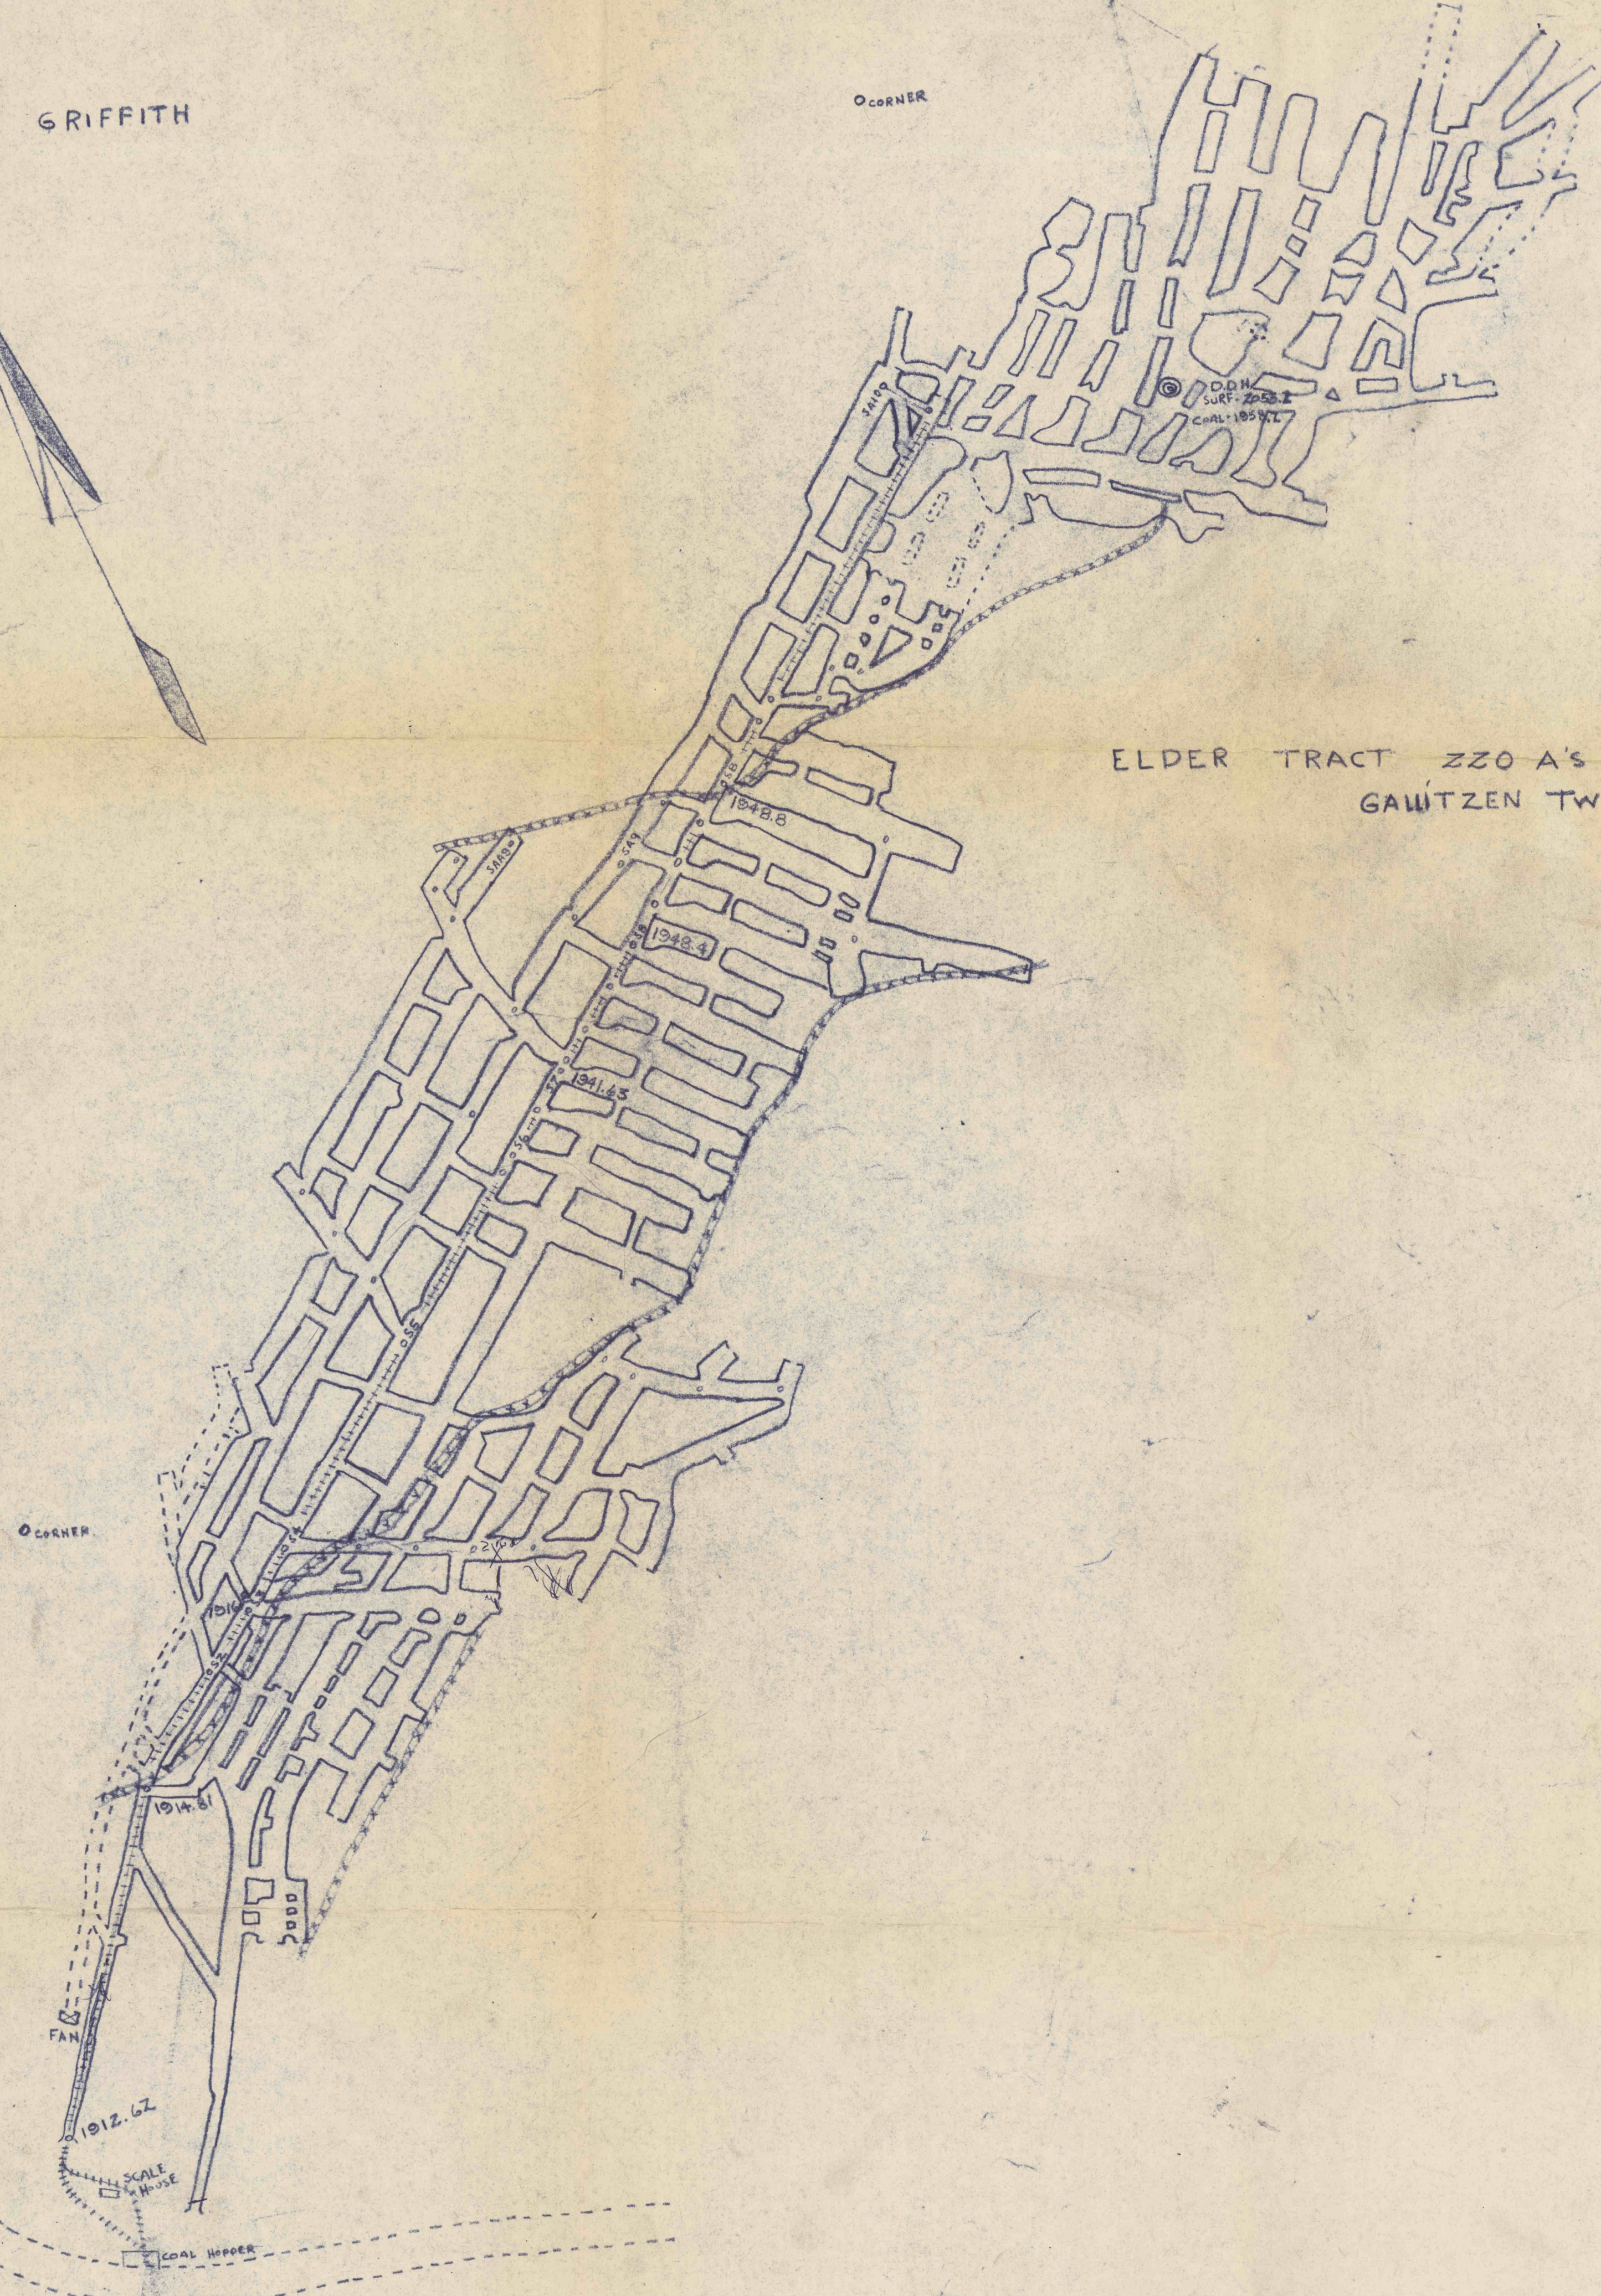

PROPERTY & MINE MAP
P. & P. COAL COMPANY
ELMER PETTENANTI - OWNER
ASHVILLE R. D.

DATE - JUNE 1963 SCALE - 1" = 100'
SURVEYED & DRAWN BY - J. C. P.

REFERENCES - O'CONNOR MINE MAP & SURVEY NOTES

SURVEYOR - JOHN C. PASSMORE
400 WEST MILTON ST
EBENSBURG PA.
TELE - 6R-28008



4/65